


RECORD DRAWING
 THE SEAL THAT ORIGINALLY APPEARED ON THIS DOCUMENT WAS AUTHORIZED BY
 TED B. SUGG, TEXAS NO. 62775 ON 10-1-09
 THESE RECORD DRAWINGS WERE PREPARED
 BASED UPON AS CONSTRUCTED DRAWINGS
 REPRESENTED THAT ALL FIELD CHANGES AND
 DEVIATIONS FROM THE APPROVED
 CONSTRUCTION DRAWINGS WERE INCLUDED ON
 APRIL 18, 2011.




CITY OF ROCKWALL
 SHADY DALE LANE
 SHADY DALE WATERLINE
 STA 0+00 TO 5+00

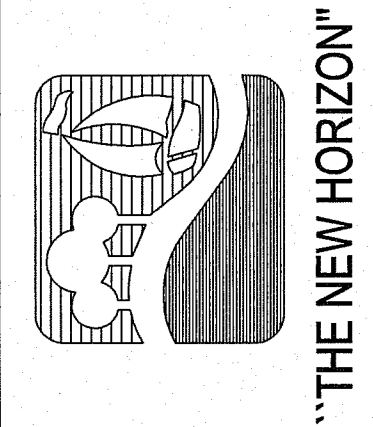

NO.	REVISION	BY	DATE
1	MOVED WATERLINE TO 9' FROM ROW	TBS	11/17/09
2	RECORD DRAWINGS	MW	4/18/11

DESIGN: CRH / TBS	CHECKED: PBS&J
DRAWN: CRH / TBS	APPROVED: PBS&J

TYPE REC. #474	DATE: SEPTEMBER 2009
8383 PRESTON ROAD, SUITE 110 DALLAS, TEXAS 75252	FILE: \$FILE\$\$
PBS&J JOB NO.: 52091000	

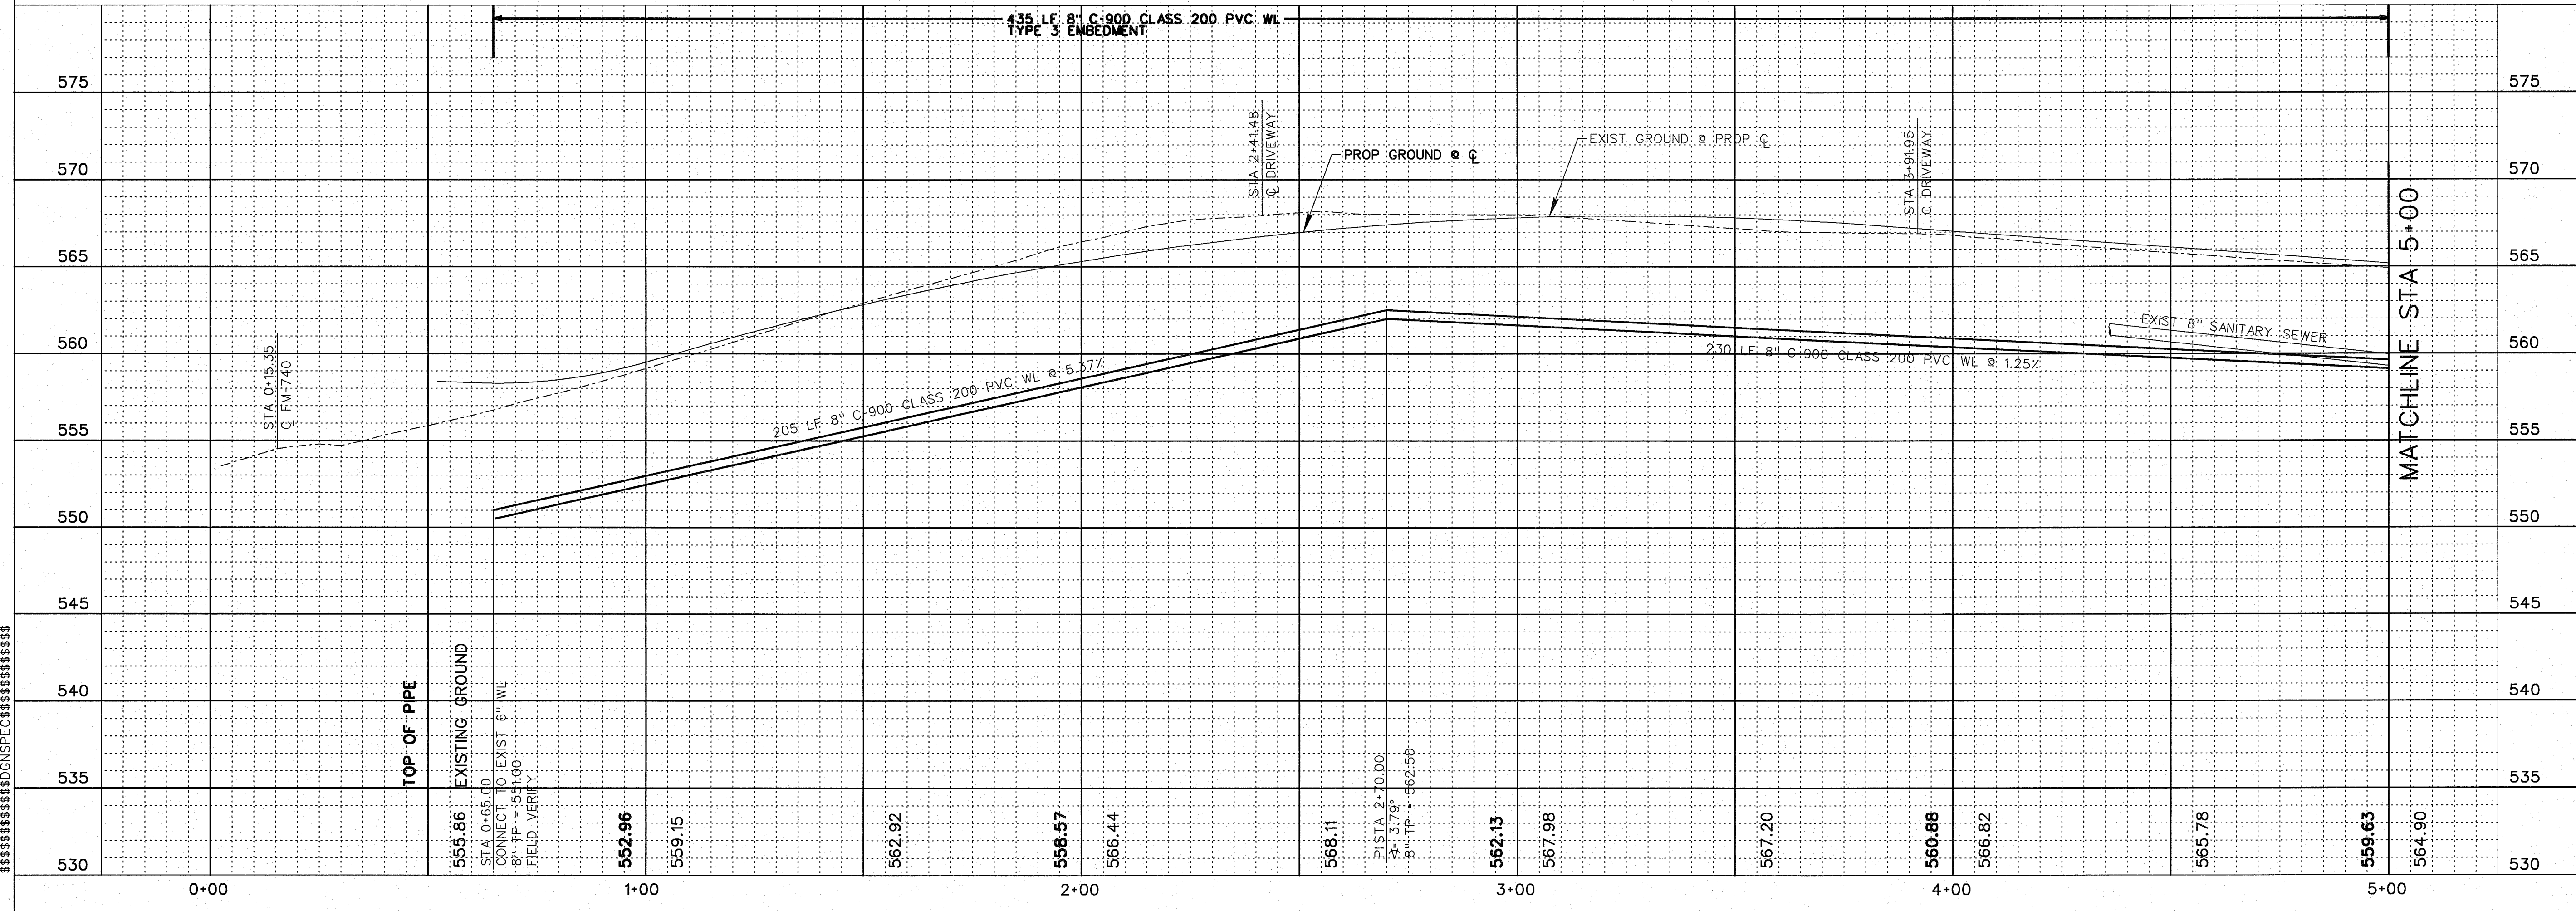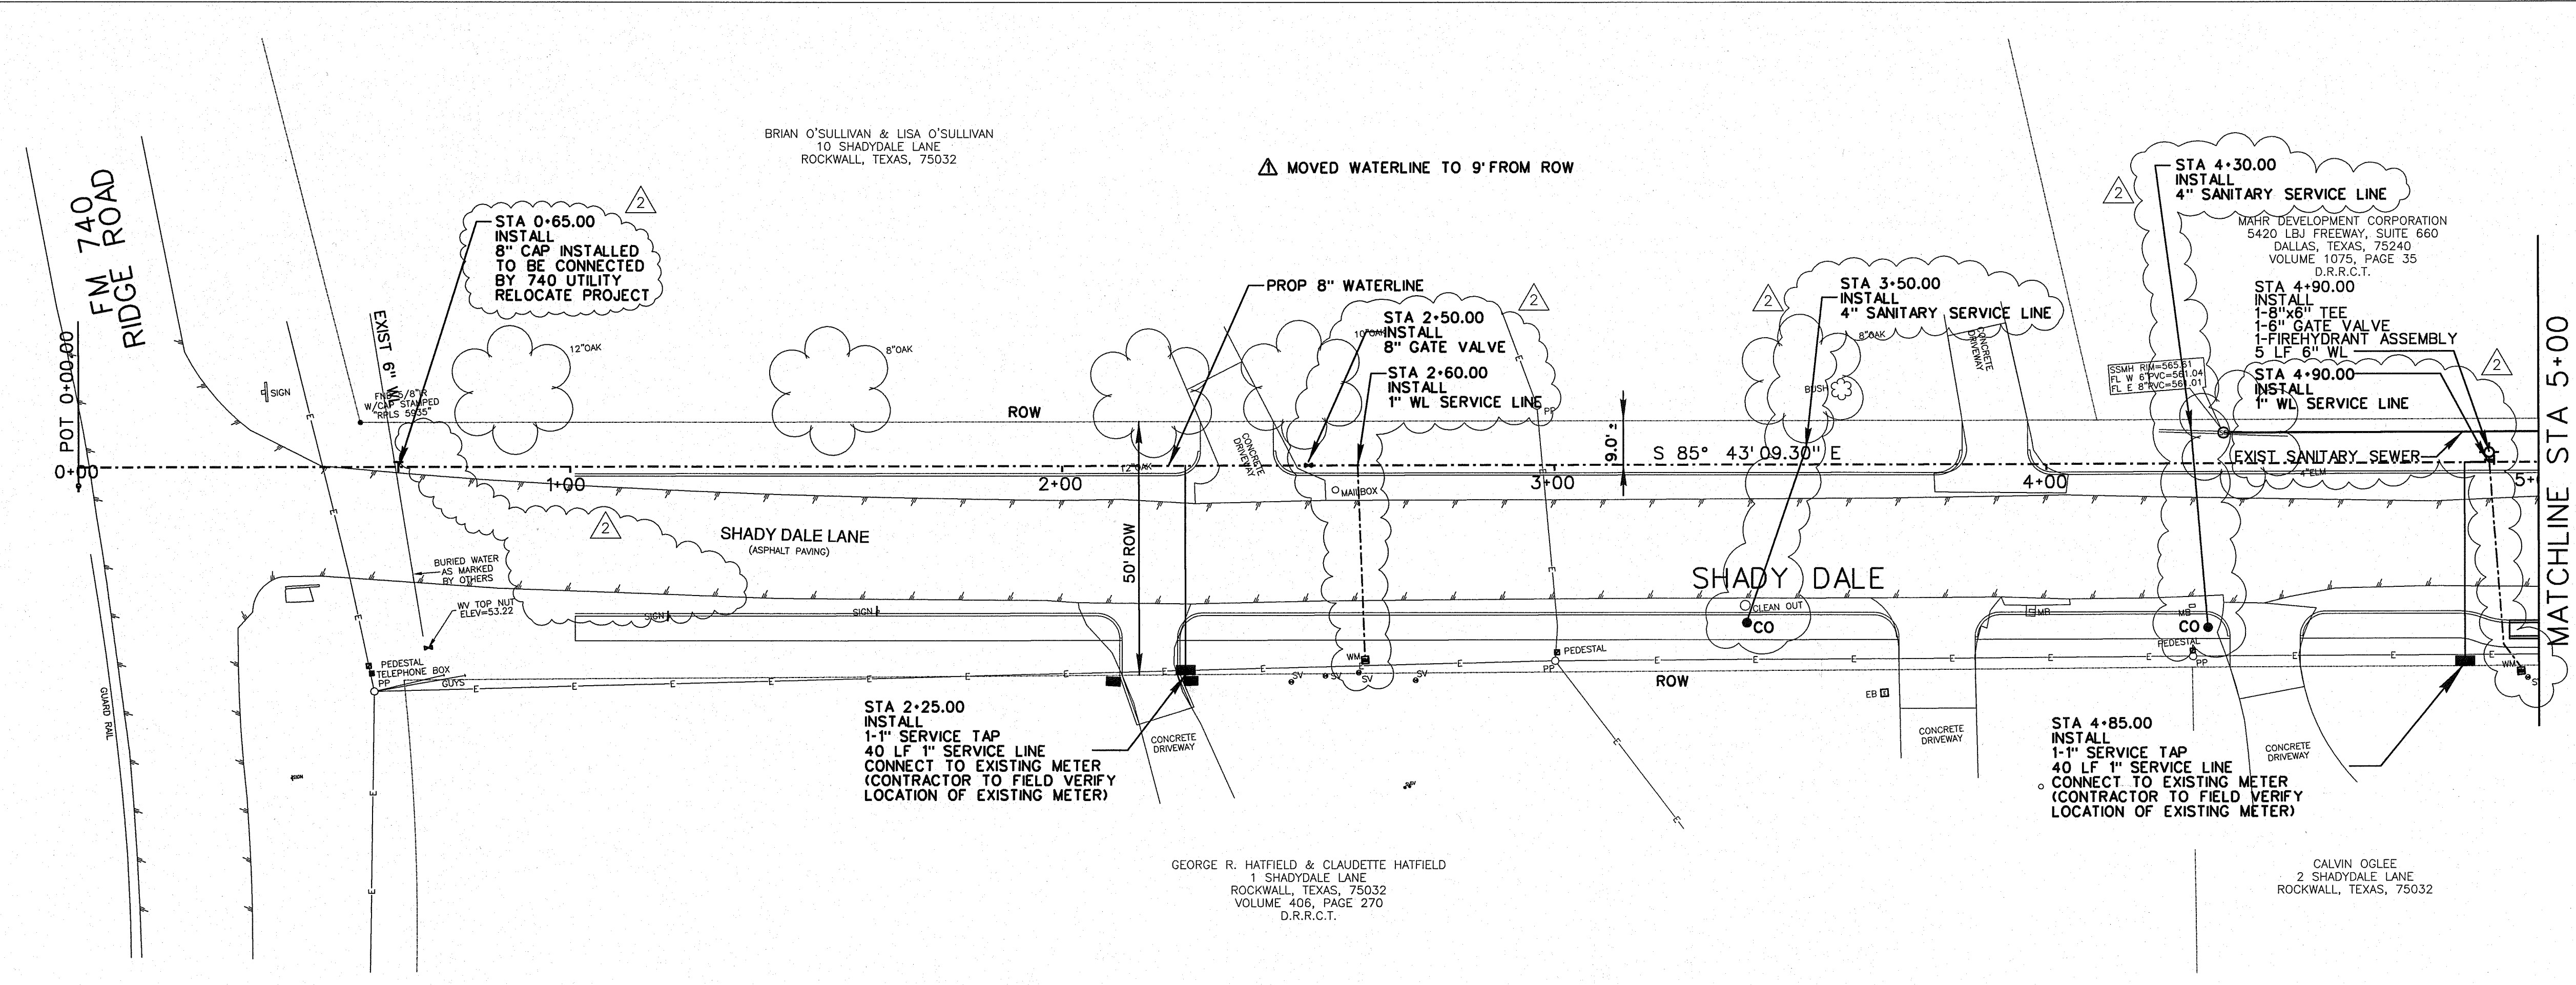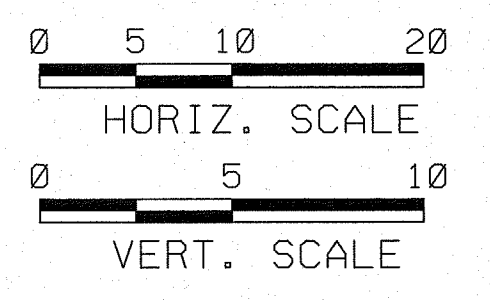

STIMEC
 8:15 AM
 8/18/11