

SHADY DALE LANE




CITY OF ROCKWALL

"THE NEW HORIZON"

SEPTEMBER 2009

BILL CECIL * MAYOR
 DAVID SWEET
 MARK RUSSO
 GLEN FARRIS
 CLIFF SEVIER - MAYOR PRO-TEM
 MATT SCOTT
 MARGO NIELSEN
 CITY COUNCIL
 JULIE COUCH
 CITY MANAGER
 CHUCK TODD, P.E.
 DIRECTOR OF PUBLIC WORKS

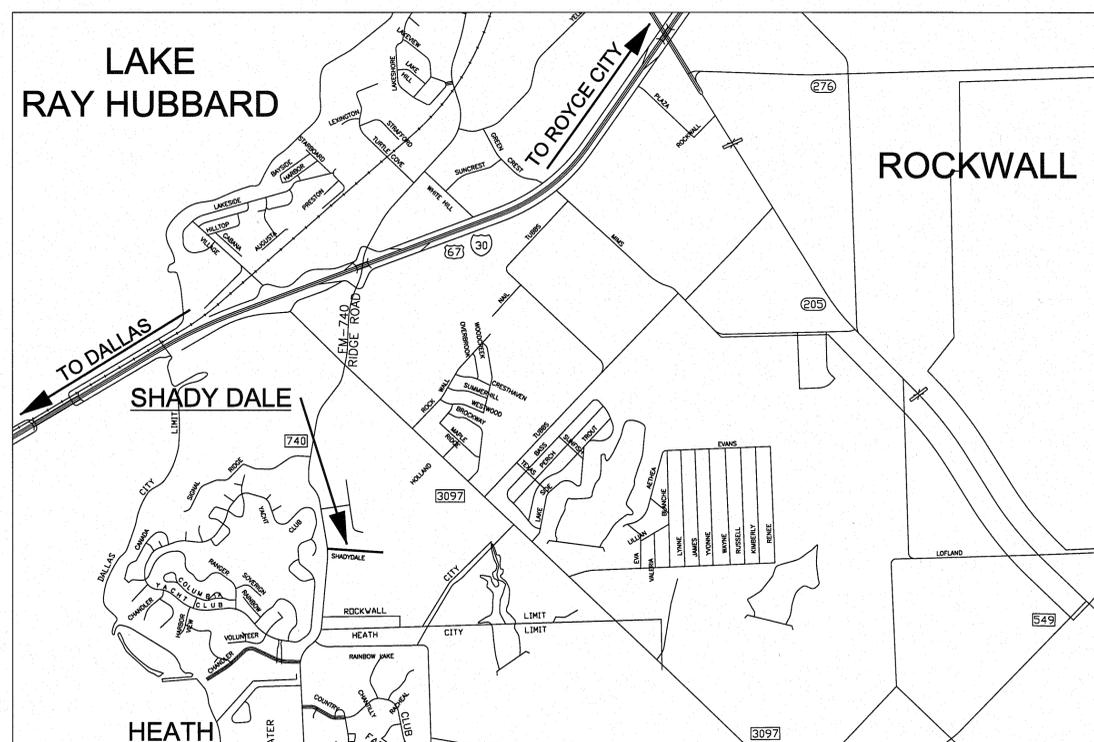

VICINITY MAP
 N.T.S.

SHEET INDEX

SHEET NO.	DESCRIPTION
GN-1	COVER SHEET
GN-2	GENERAL NOTES
GN-3	QUANTITY SUMMARY SHEET
GN-4	TYPICAL SECTIONS
SD-P1	SHADY DALE PAVING P&P STA 1+00 TO 6+00
SD-P2	SHADY DALE PAVING P&P STA 6+00 TO 11+00
SD-P3	SHADY DALE PAVING P&P STA 11+00 TO END
SD-D 1	SHADY DALE DRAINAGE AREA MAP & CALCULATIONS
SD-A 1	SHADY DALE STORM DRAIN P&P STA 0+00 TO 5+00
SD-A 2	SHADY DALE STORM DRAIN P&P STA 5+00 TO END
SD-W1	SHADY DALE WATERLINE STA 0+00 TO 5+00
SD-W2	SHADY DALE WATERLINE STA 5+00 TO 10+00
SD-W3	SHADY DALE WATERLINE STA 10+00 TO END
SD-EC1	SHADY DALE EROSION CONTROL
SD-XS1-XS5	SHADY DALE CROSS SECTIONS
EC-1	EROSION CONTROL NARRATIVE

RECORD DRAWING

THE SEAL THAT ORIGINALLY APPEARED ON THIS DOCUMENT WAS AUTHORIZED BY TED B. SUGG, TEXAS NO 82775 ON 10-1-09


THESE RECORD DRAWINGS WERE PREPARED BASED UPON AS CONSTRUCTED DRAWINGS PROVIDED BY THE CONTRACTOR WHO REPRESENTED THAT ALL FIELD CHANGES AND DEVIATIONS FROM THE APPROVED CONSTRUCTION DRAWINGS WERE INCLUDED ON APRIL 18, 2011.



TBPE REG. #F-474



18383 PRESTON ROAD, SUITE 110
 DALLAS, TEXAS 75252
 972-818-7275

CITY OF ROCKWALL - SHADY DALE LANE

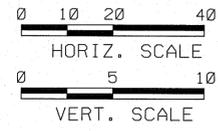

REVISD CUT/FILL LIMITS


MAHR DEVELOPMENT CORPORATION
5420 LBJ FREEWAY, SUITE 660
DALLAS, TEXAS, 75240
VOLUME 1247, PAGE 270
D.R.R.C.T.

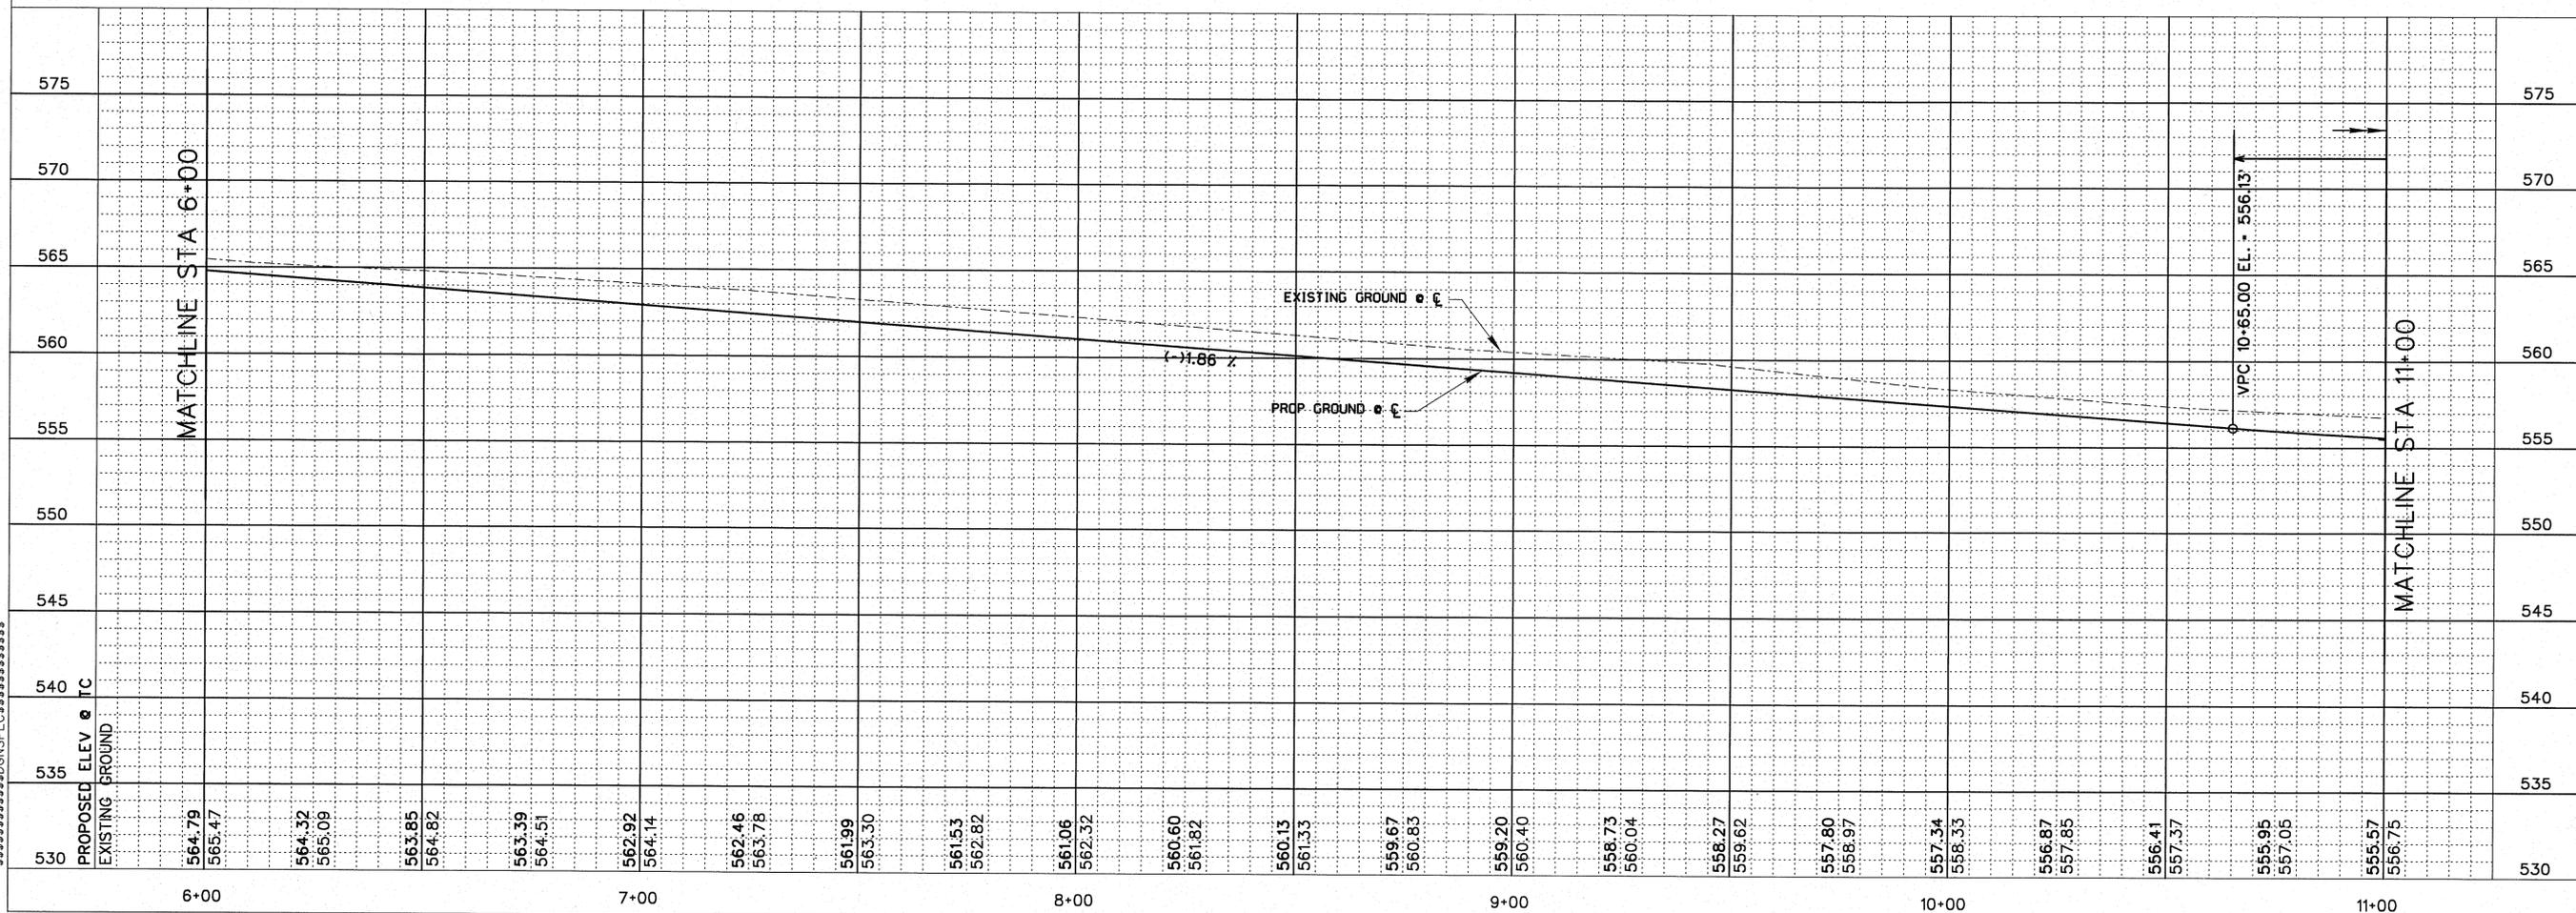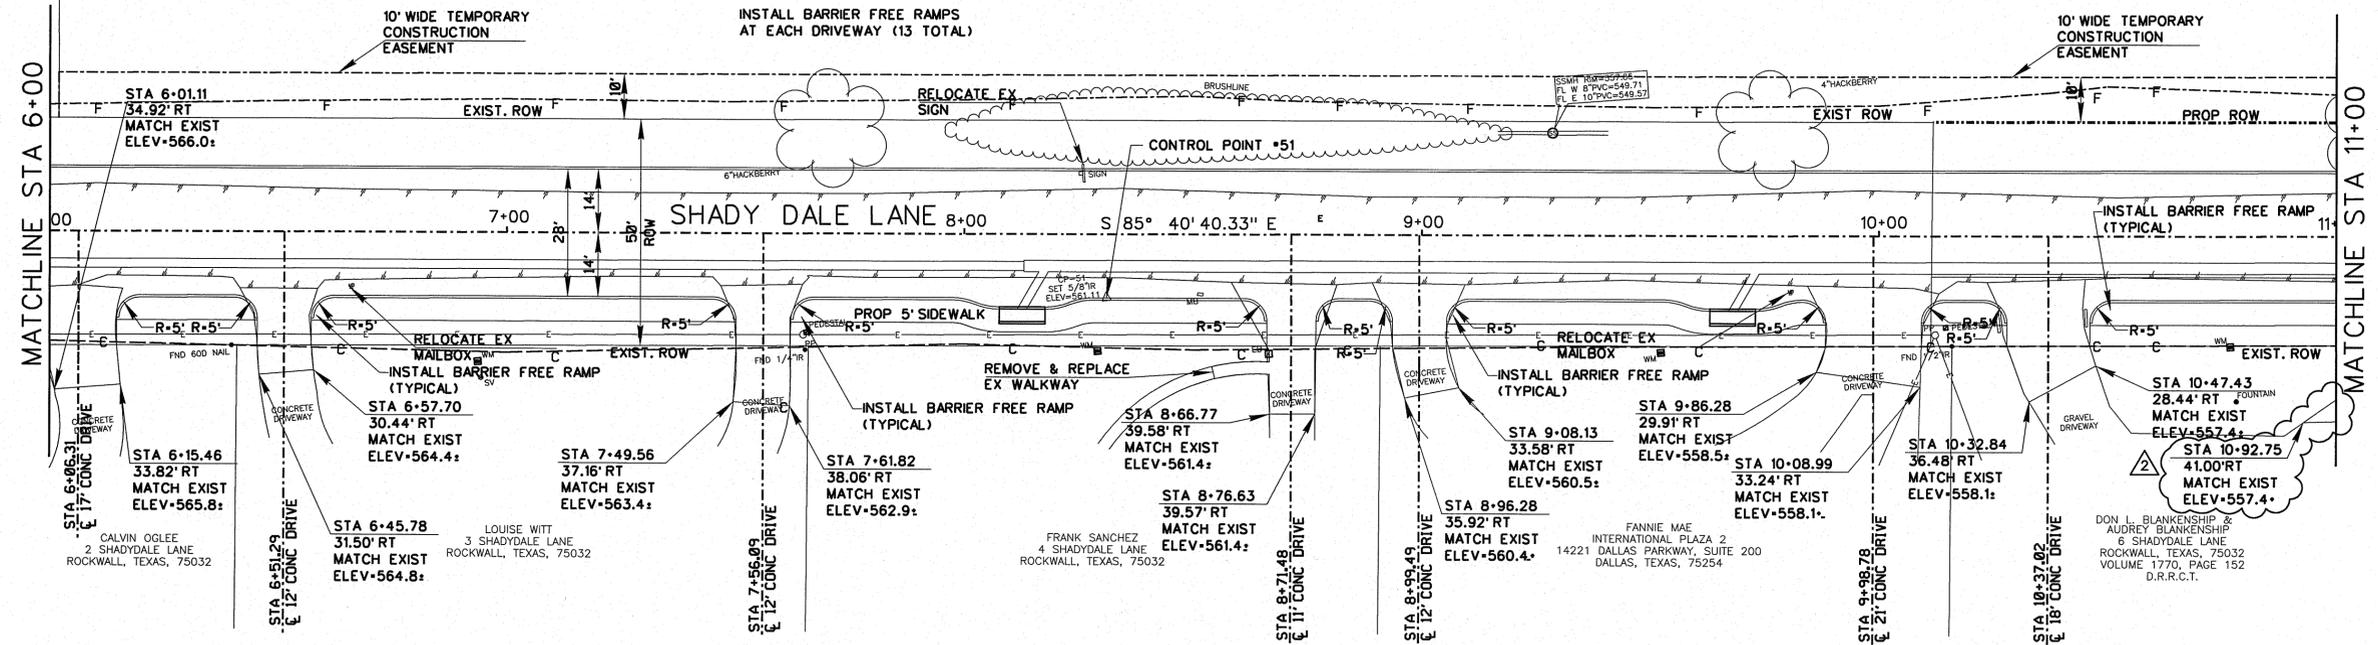

STIMES
\$\$\$\$SYTIME\$\$\$\$
\$\$\$\$\$\$\$\$DGN\$P\$C\$\$\$\$\$\$\$\$

RECORD DRAWING
THE SEAL THAT ORIGINALLY APPEARED ON THIS DOCUMENT WAS AUTHORIZED BY TED B. SUGG, TEXAS NO. 82775 ON 10-1-09
THESE RECORD DRAWINGS WERE PREPARED BY THE CONTRACTOR WHO PROVIDED BY THE CONTRACTOR WHO DEVIATIONS FROM THE APPROVED CONSTRUCTION DRAWINGS WERE INCLUDED ON APRIL 18, 2011.

CITY OF ROCKWALL
SHADY DALE LANE
SHADY DALE PAVING
STA 6+00 TO 11+00

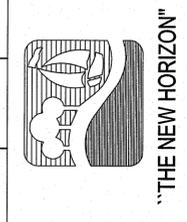

NO.	REVISION	BY	DATE
1	REVISED CUT/FILL LIMITS	TBS	11/17/09
2	RECORD DRAWINGS	MW	4/7/11



DESIGN: CRH / TBS
DRAWN: CRH / TBS
CHECKED: PBS&J
APPROVED: PBS&J

DATE: SEPTEMBER 2009
JOB NO.: 52091000
FILE: \$FILES

TYPE REC: 4-474
18383 PRESTON ROAD, SUITE 10
DALLAS, TEXAS 75252
972-818-7275

SHEET SD P2
6 OF 20


STIMES
 \$\$\$\$\$\$SYTIME\$\$\$\$\$\$
 \$\$\$\$\$\$SDGNSPEC\$\$\$\$\$\$\$\$\$\$\$\$\$\$\$\$

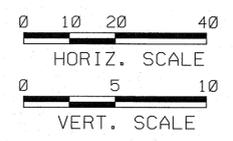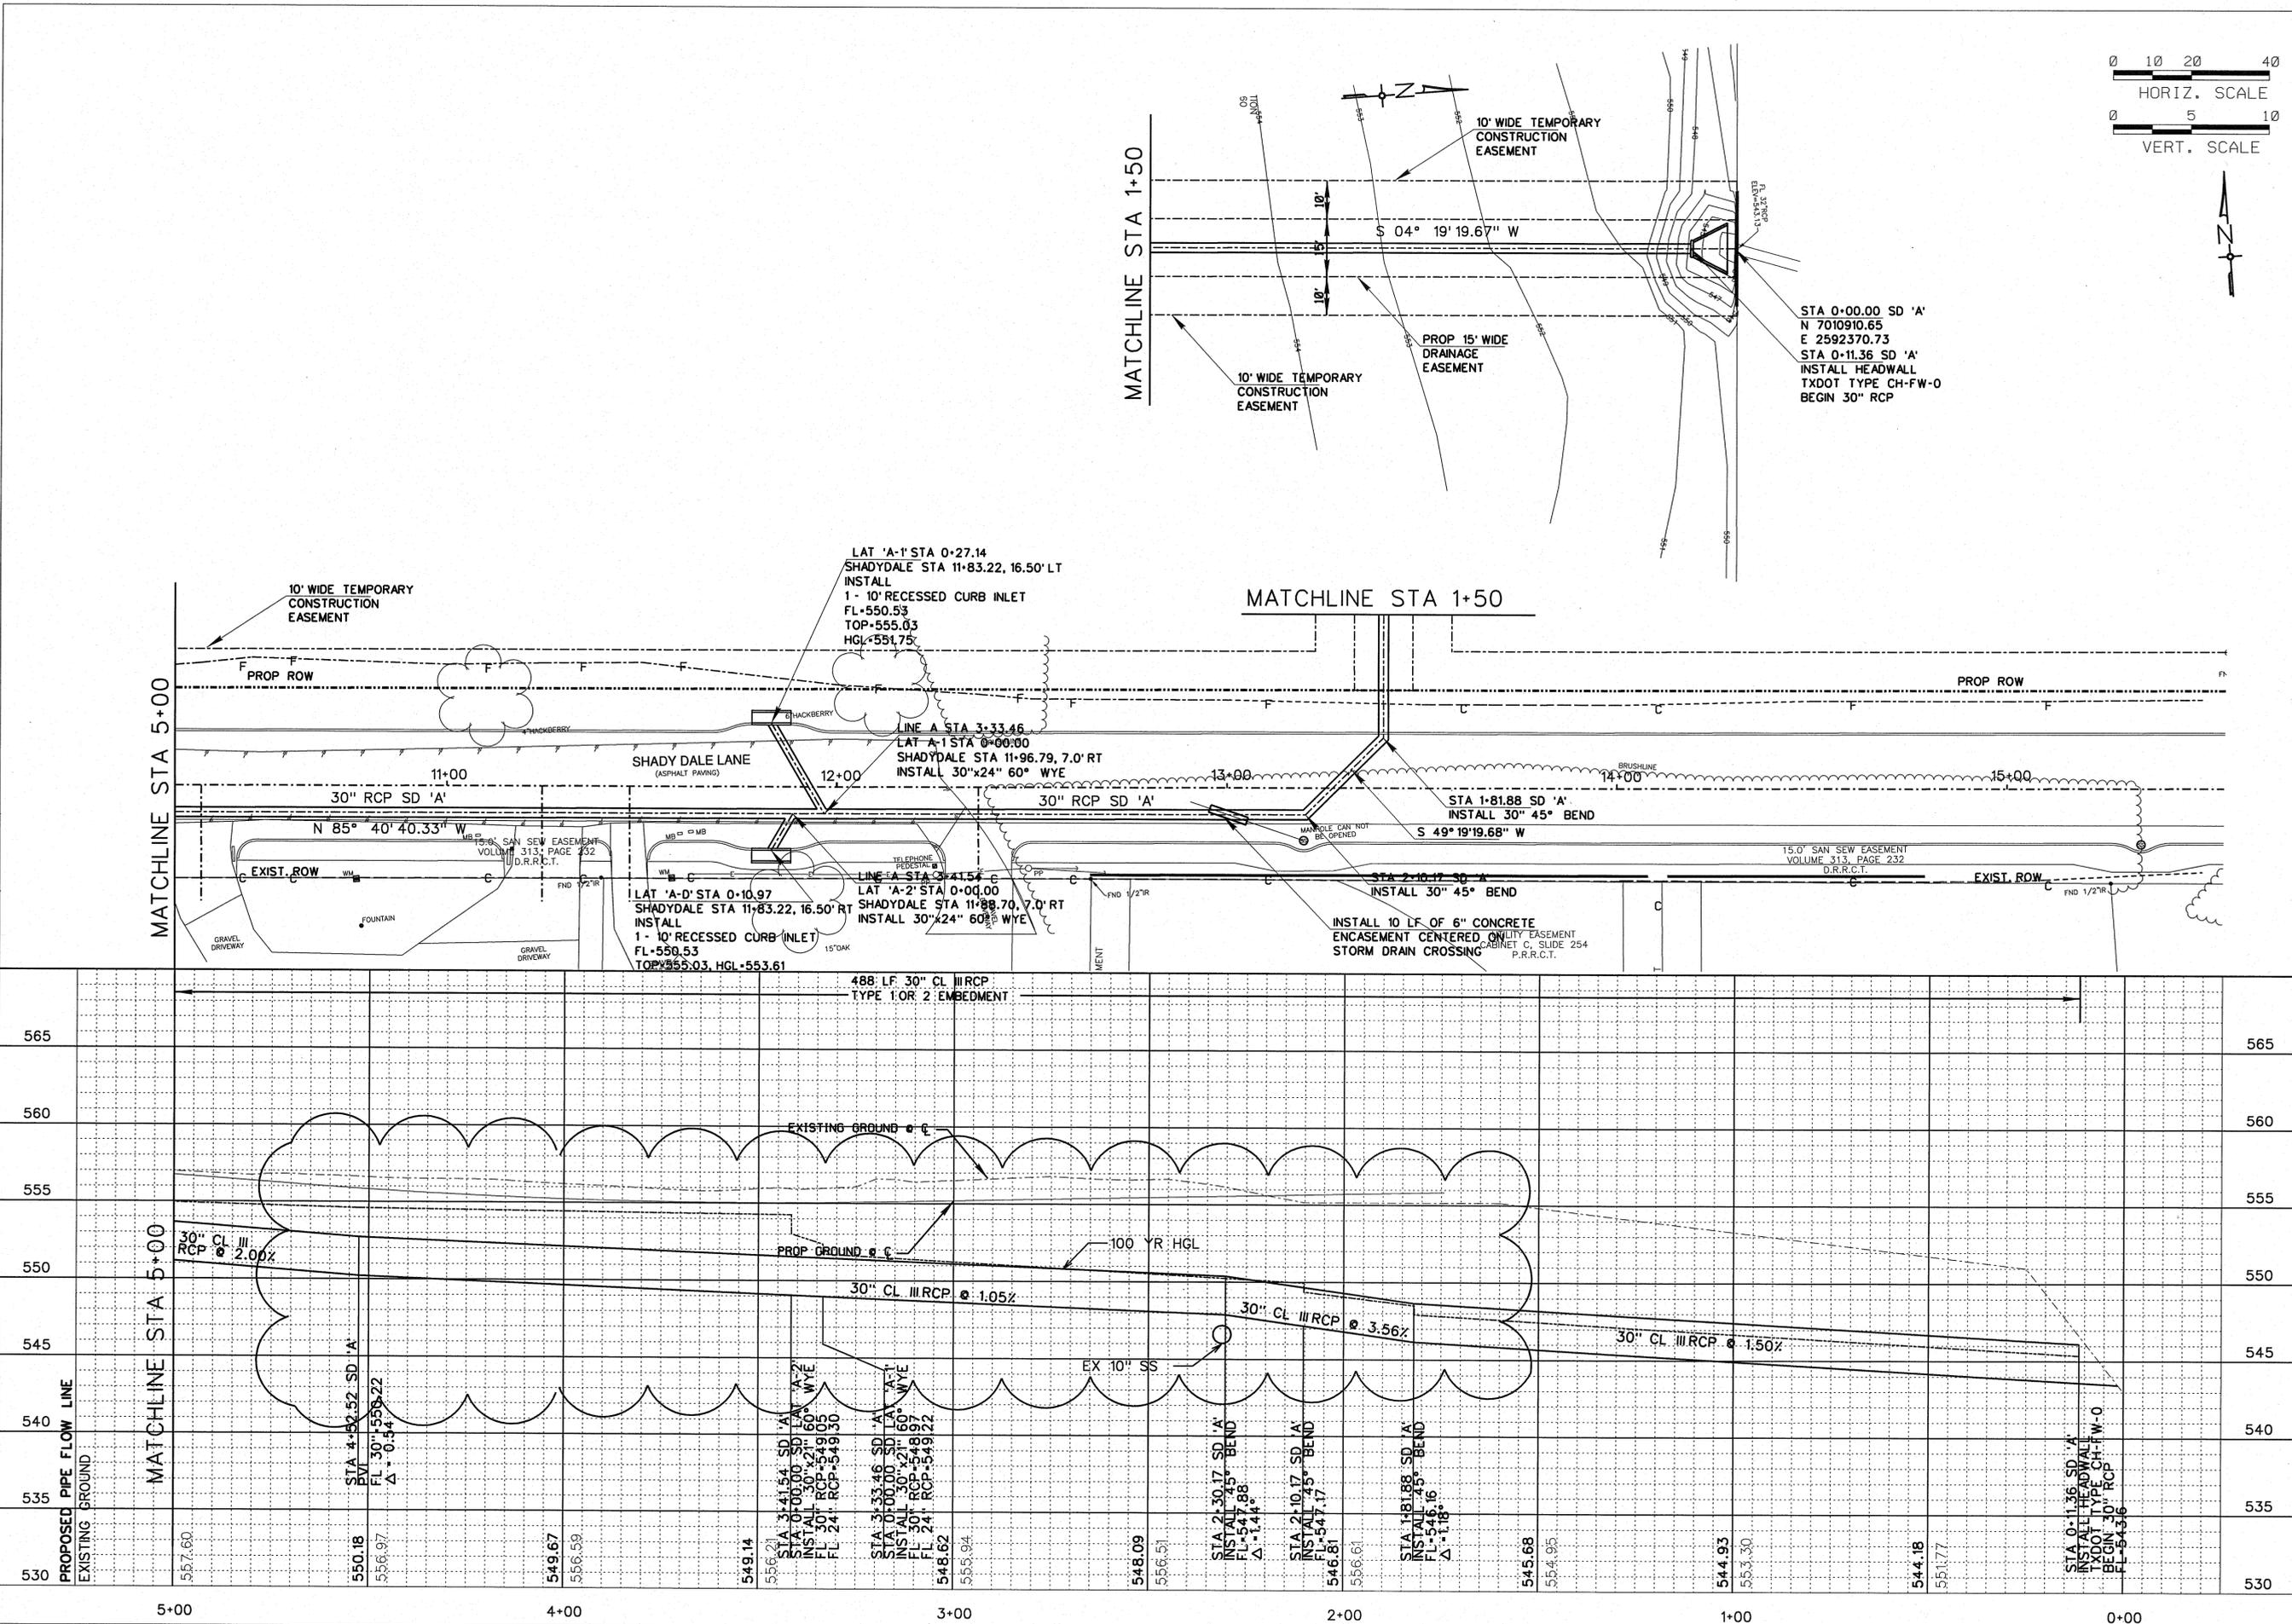

RECORD DRAWING
 THE SEAL THAT ORIGINALLY APPEARED ON THIS DOCUMENT WAS AUTHORIZED BY THE BOARD OF SURVEYORS, TEXAS NO. 82775 ON 10-1-09. THESE RECORD DRAWINGS WERE PREPARED BASED UPON AS CONSTRUCTED DRAWINGS PROVIDED BY THE CONTRACTOR WHO HAS AGREED TO CORRECT ANY CHANGES AND DEVIATIONS FROM THE APPROVED CONSTRUCTION DRAWINGS WERE INCLUDED ON APRIL 18, 2011.

**CITY OF ROCKWALL
 SHADY DALE LANE**

**SHADY DALE STORM DRAIN 'A'
 STA 0+00 TO STA 5+00**

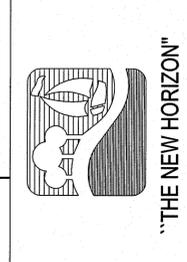


NO.	REVISION	BY	DATE
1	REVISE SD SLOPE FROM 4+52.52 TO 1+81.88	RKJ	12/1/09

DESIGN: CRH / TBS	CHECKED: PBS&J
DRAWN: CRH / TBS	APPROVED: PBS&J

TBPE REC. #F-474	DATE: SEPTEMBER 2009
18383 PRESTON ROAD, SUITE 110 DALLAS, TEXAS 75252 972-818-7275	FILE: \$FILESS

STIMES
 \$\$\$\$\$SYTIME\$\$\$\$\$\$
 \$\$\$\$\$\$\$\$\$\$\$\$\$\$\$\$\$\$

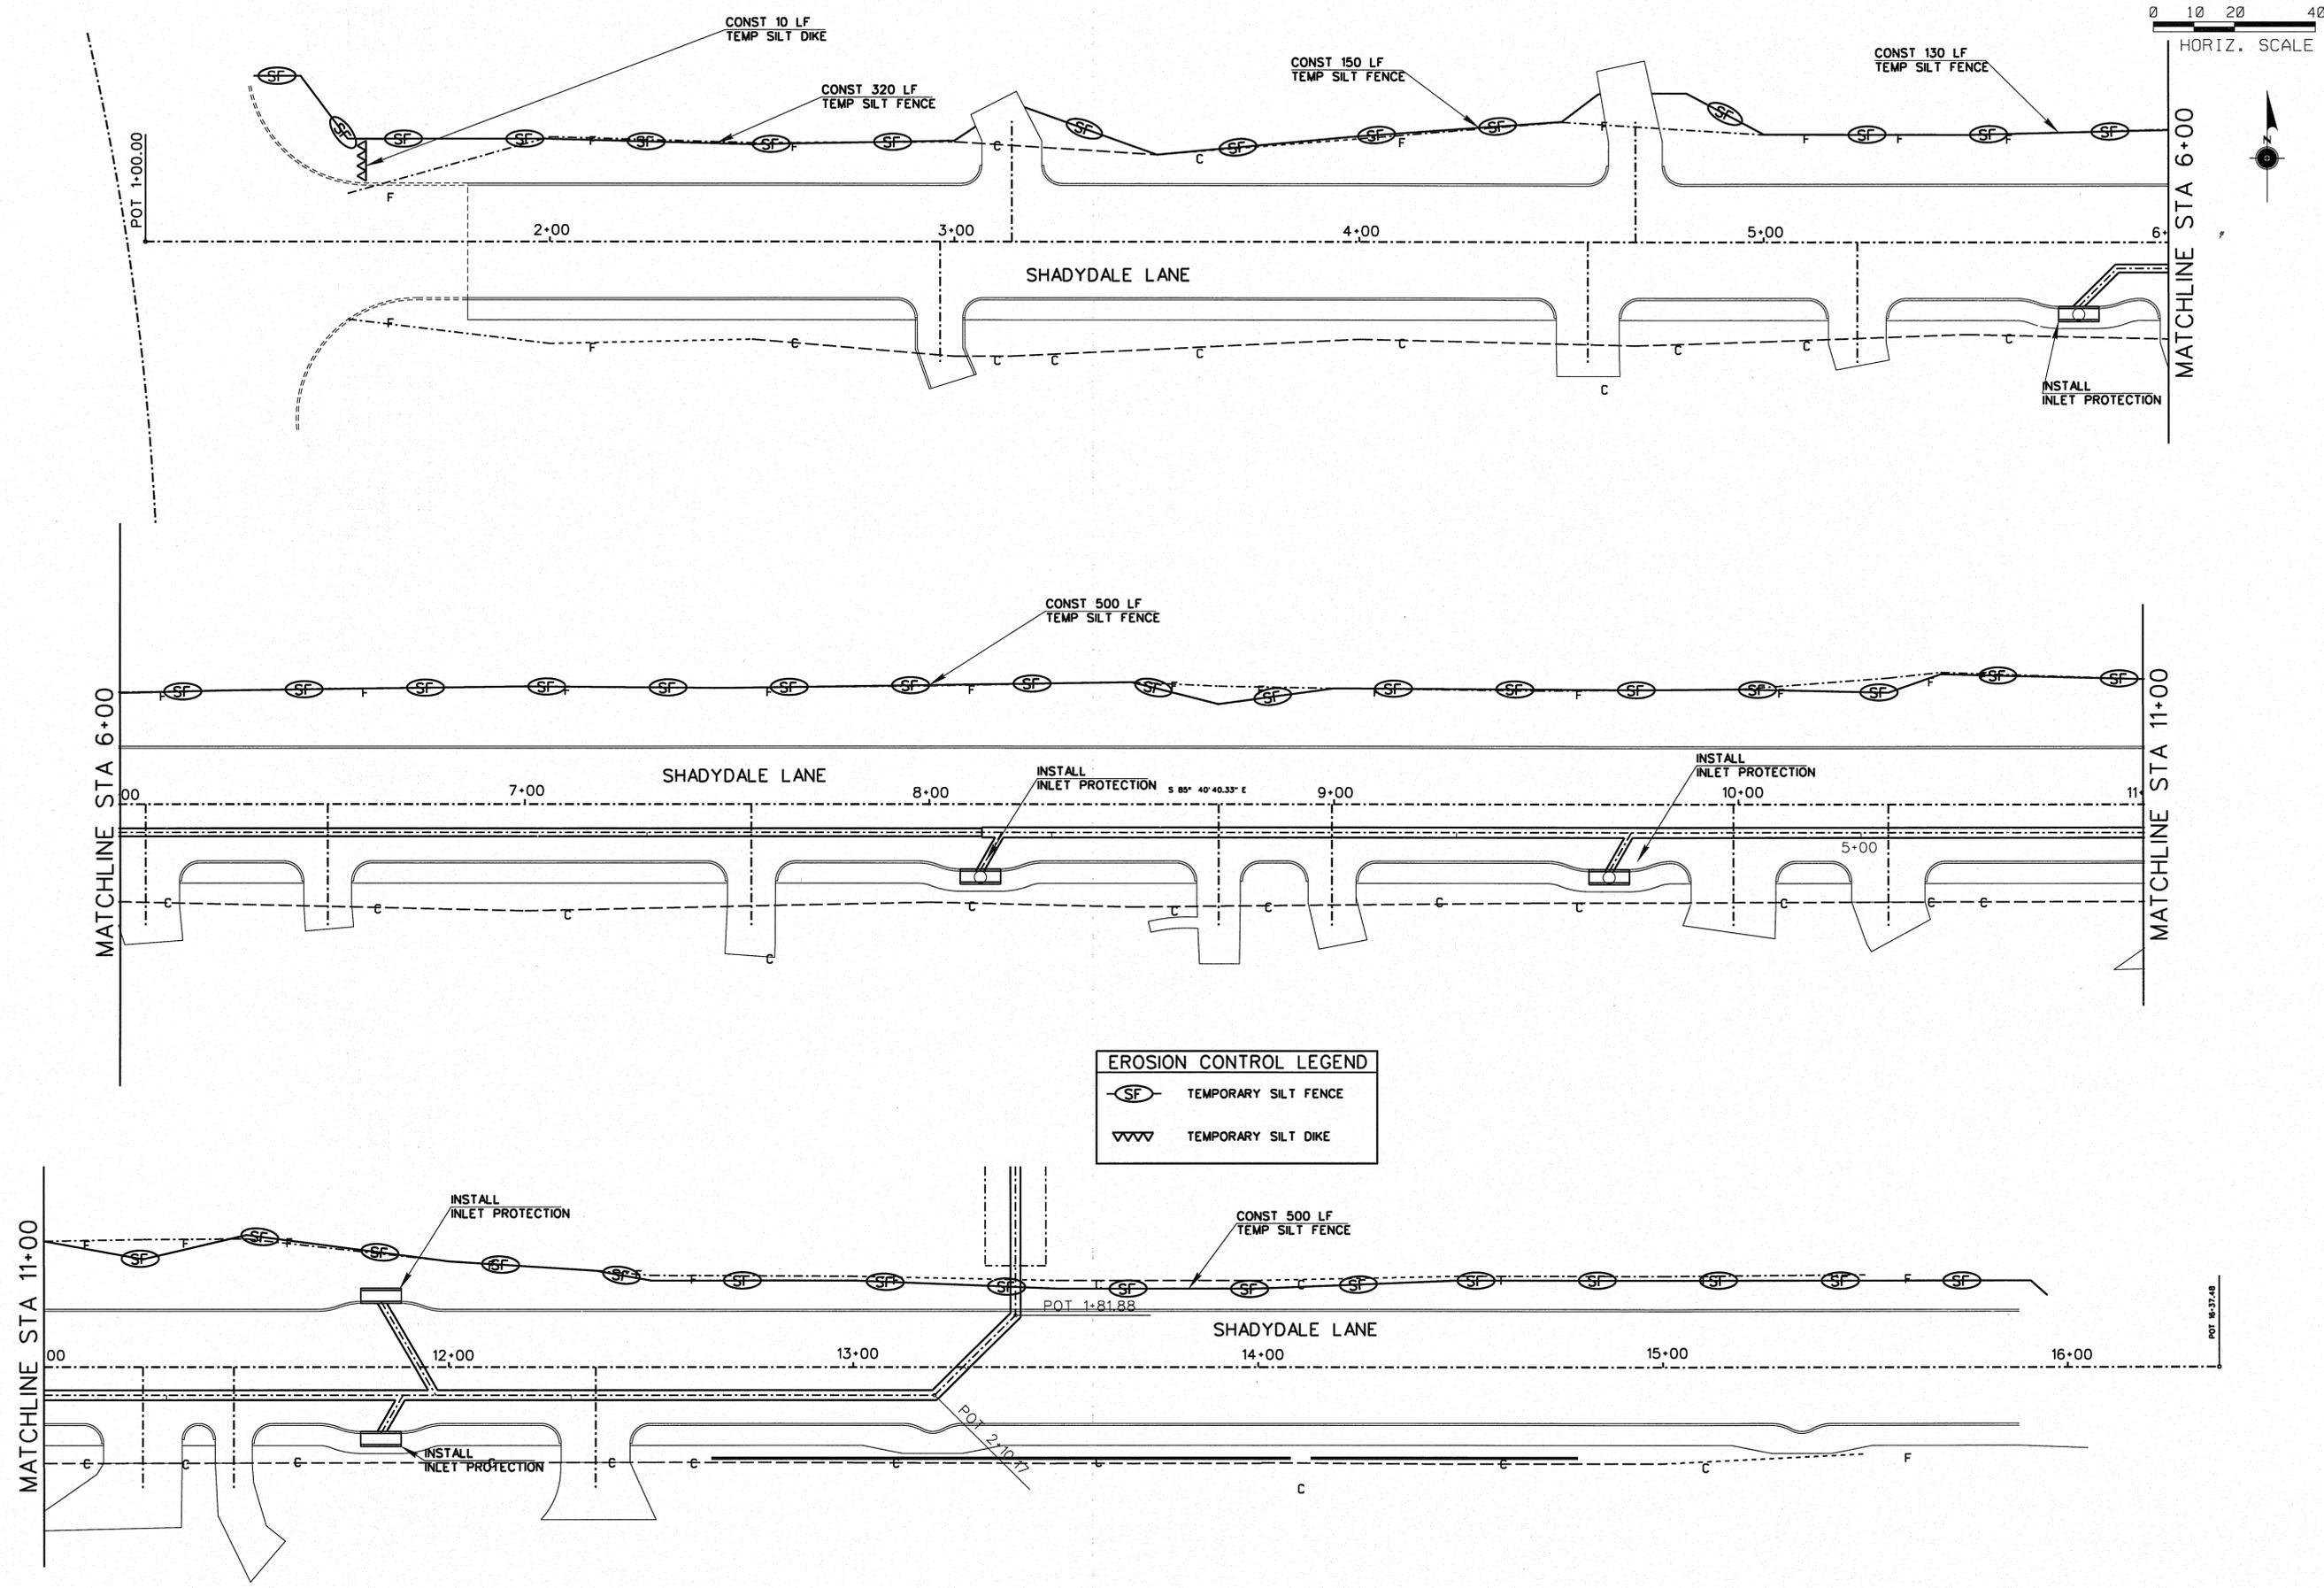

EROSION CONTROL LEGEND	
(SF)	TEMPORARY SILT FENCE
V	TEMPORARY SILT DIKE

RECORD DRAWING
 THE SEAL THAT ORIGINALLY APPEARED ON THIS DOCUMENT WAS AUTHORIZED BY TED B. SUGG, TEXAS NO 82775 ON 10-1-09
 THESE RECORD DRAWINGS WERE PREPARED BASED UPON AS CONSTRUCTED DRAWINGS PROVIDED BY THE CONTRACTOR WHO REPRESENTED THAT ALL FIELD CHANGES AND CONSTRUCTION DRAWINGS WERE INCLUDED ON APRIL 18, 2011.

CITY OF ROCKWALL
 SHADY DALE LANE
 EROSION CONTROL PLAN
 SHADYDALE LANE




NO.	REVISION	BY	DATE



DESIGN: CRH / TBS	CHECKED: PBS&J
DRAWN: CRH / TBS	APPROVED: PBS&J

TBPE REC. 4-474	8383 PRESTON ROAD, SUITE 110 DALLAS, TX 75252
PBS&J JOB NO.: 52091000	DATE: SEPTEMBER 2009
FILE: #TLES\$	

 \$TIME\$

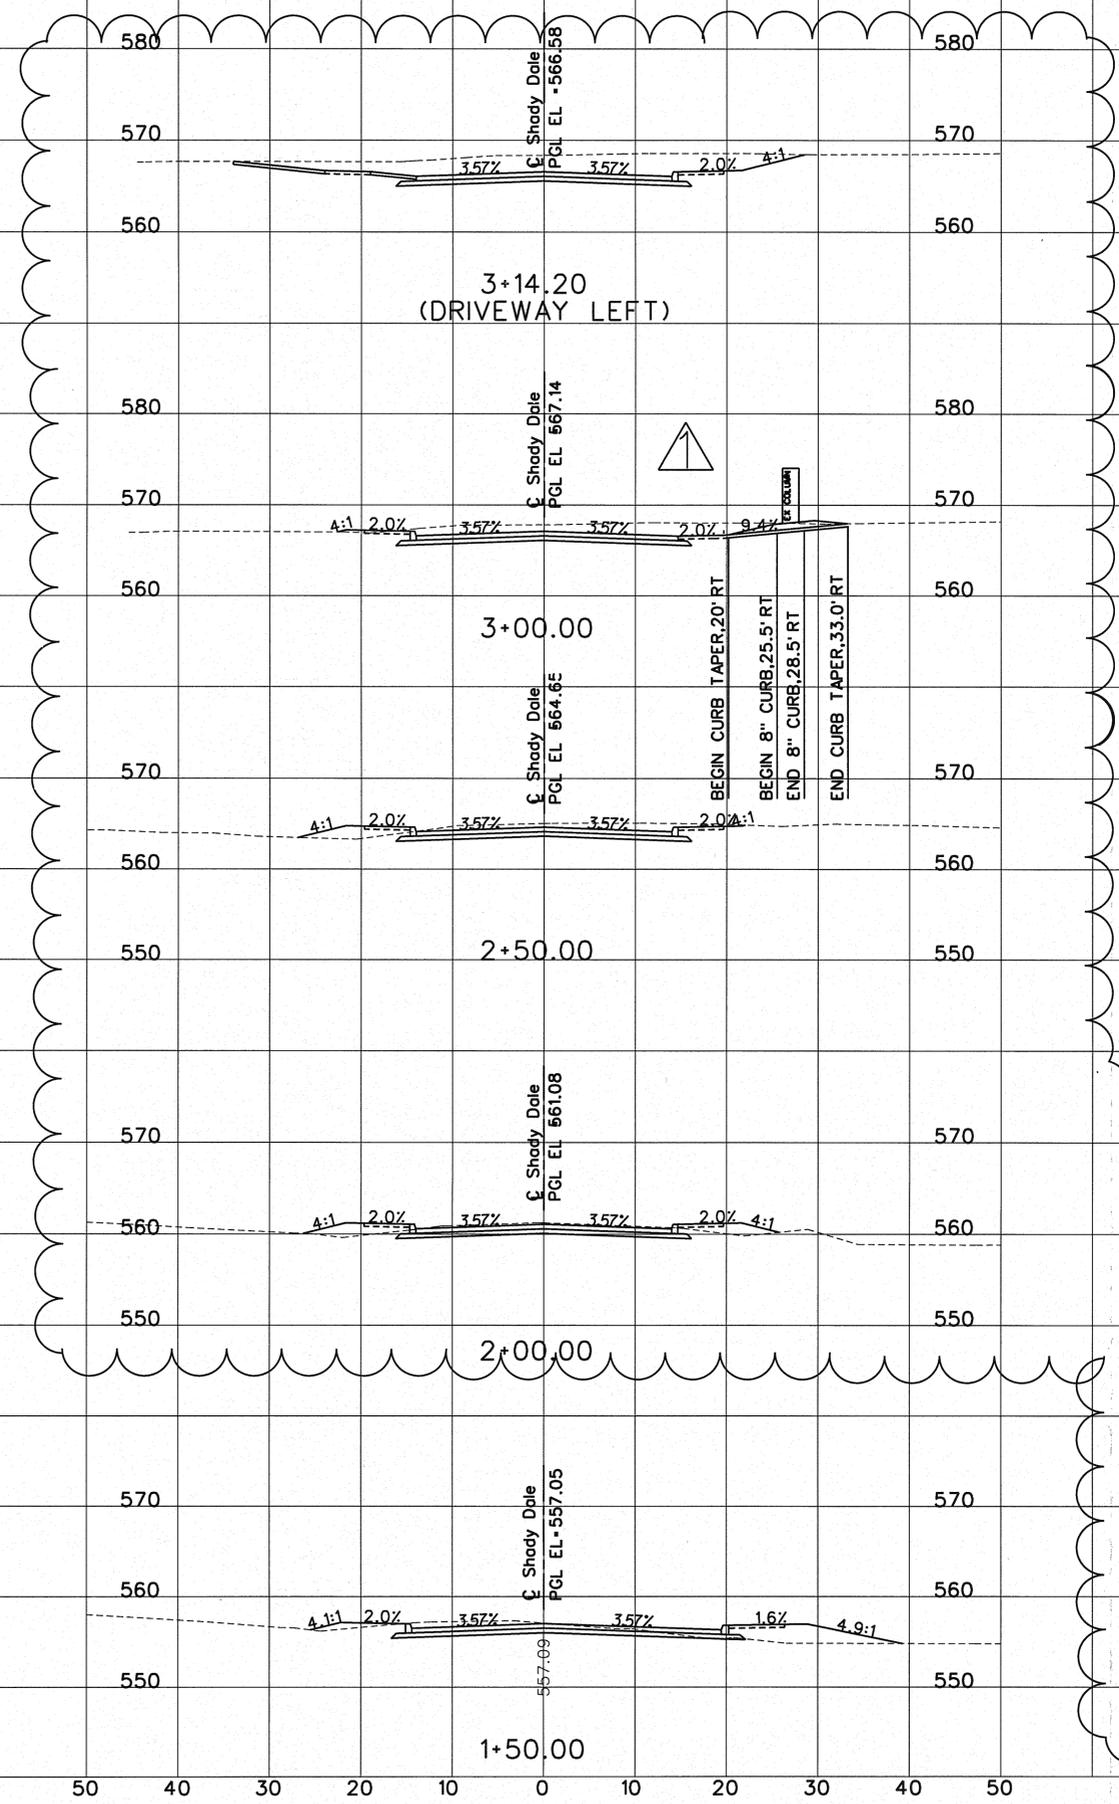

STATION	CUT	FILL	ACCUM. CUT	ACCUM. FILL
	CY	CY	CY	CY
1+50.00	0	0	0	0
2+00.00	40	42	40	42
2+50.00	81	16	121	58
3+00.00	156	3	277	61
3+14.20	59	0	336	61
3+50.00	129	0	465	61
4+00.00	109	9	574	70
4+50.00	85	26	659	96
4+68.24	31	8	690	104
5+00.00	52	11	742	115
5+23.14	42	10	784	125
5+50.00	47	12	831	137
6+00.00	89	24	920	161
6+50.00	98	24	1018	185
7+00.00	103	21	1121	206
7+50.00	118	17	1239	223
8+00.00	113	17	1352	240
8+50.00	103	19	1455	259
8+71.48	53	7	1508	266
9+00.00	74	10	1582	276
9+50.00	117	19	1699	295
10+00.00	105	18	1804	313
10+37.02	77	17	1881	330
10+50.00	25	8	1906	338
11+00.00	96	33	2002	371
11+24.42	69	11	2071	382
11+50.00	91	11	2162	393
12+00.00	142	20	2304	413
12+36.32	81	7	2385	420
12+50.00	30	1	2415	421
13+00.00	102	2	2517	423
13+50.00	110	1	2627	424
14+00.00	111	0	2738	424
14+50.00	108	1	2846	425
15+00.00	181	2	3027	427
15+50.00	0	0	3027	427

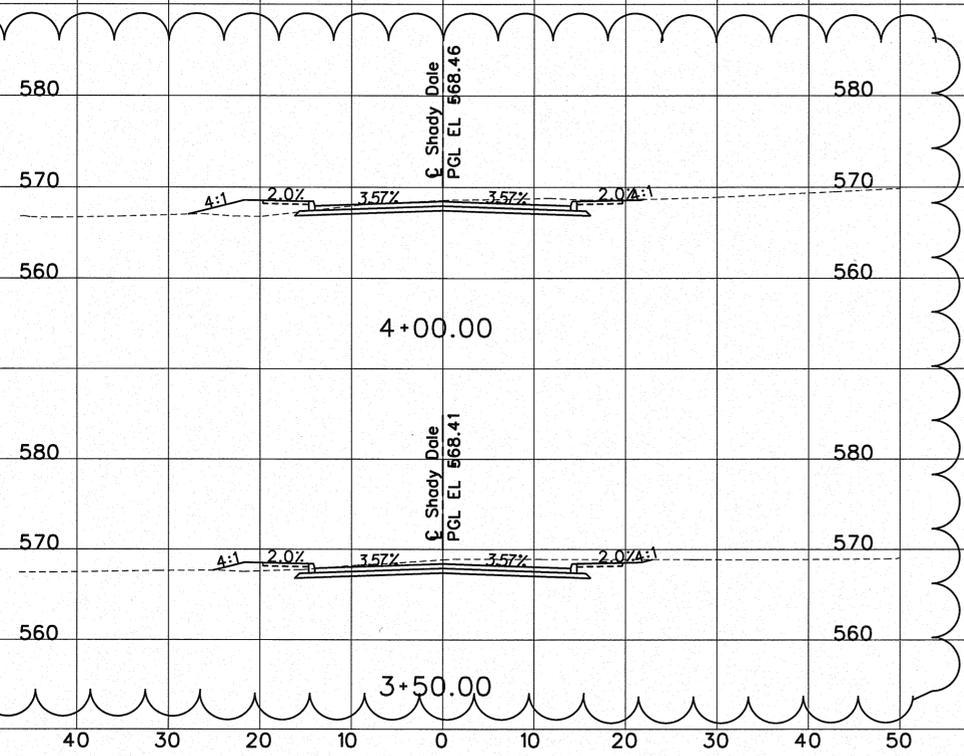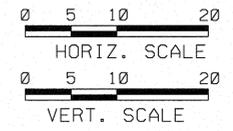


RECORD DRAWING
 THE SEAL THAT ORIGINALLY APPEARED ON THIS DOCUMENT WAS AUTHORIZED BY TED B. SUGG, TEXAS NO 82775 ON 10-1-09
 THESE RECORD DRAWINGS WERE PREPARED BASED UPON AS CONSTRUCTED DRAWINGS PROVIDED BY THE CONTRACTOR WHO REPRESENTED THAT ALL FIELD CHANGES AND CONSTRUCTION FROM THE APPROVED RECORD DRAWINGS WERE INCLUDED ON APRIL 18, 2011.

CITY OF ROCKWALL
 SHADY DALE LANE
 SHADY DALE LANE
 CROSS SECTIONS



NO.	REVISION	BY	DATE
1	REVISED DRIVE @ STA 3+00 & SECTIONS FROM 2+00 TO 4+00	TBS	3/30/10
DESIGN:	CRH / TBS	CHECKED:	PBS&J
DRAWN:	CRH / TBS	APPROVED:	PBS&J
TYPE REC:	4-474		
18383 PRESTON ROAD, SUITE 110			
DALLAS, TEXAS 75252			
972-618-7275			
PBS&J JOB NO: 52091000			
DATE: SEPTEMBER 2009			
FILE: \$FILE\$			

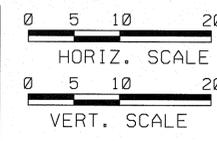



RECORD DRAWING
 THE SEAL THAT ORIGINALLY APPEARED ON THIS DRAWING IS HEREBY REVOKED. THESE RECORD DRAWINGS WERE PREPARED BY THE CONTRACTOR WHOSE RESPONSIBILITY IT IS TO REPRESENT ALL FIELD CHANGES AND DEVIATIONS FROM THE APPROVED ORIGINAL DRAWINGS. THESE RECORD DRAWINGS WERE INCLUDED ON APRIL 18, 2011.

CITY OF ROCKWALL
 SHADY DALE LANE
 SHADY DALE LANE
 CROSS SECTIONS




NO.	REVISION	DATE
1	REVISED DRIVE @ STA 4-50	5/13/10

TYPE REG. #F-474	DESIGN: CRH / TBS	CHECKED: PBS&J
18383 PRESTON ROAD SUITE 110 DALLAS, TEXAS 75292 972-818-7275	DRAWN: CRH / TBS	APPROVED: PBS&J
PBS&J JOB NO.: 52091000	DATE: SEPTEMBER 2009	FILE: #FILESS

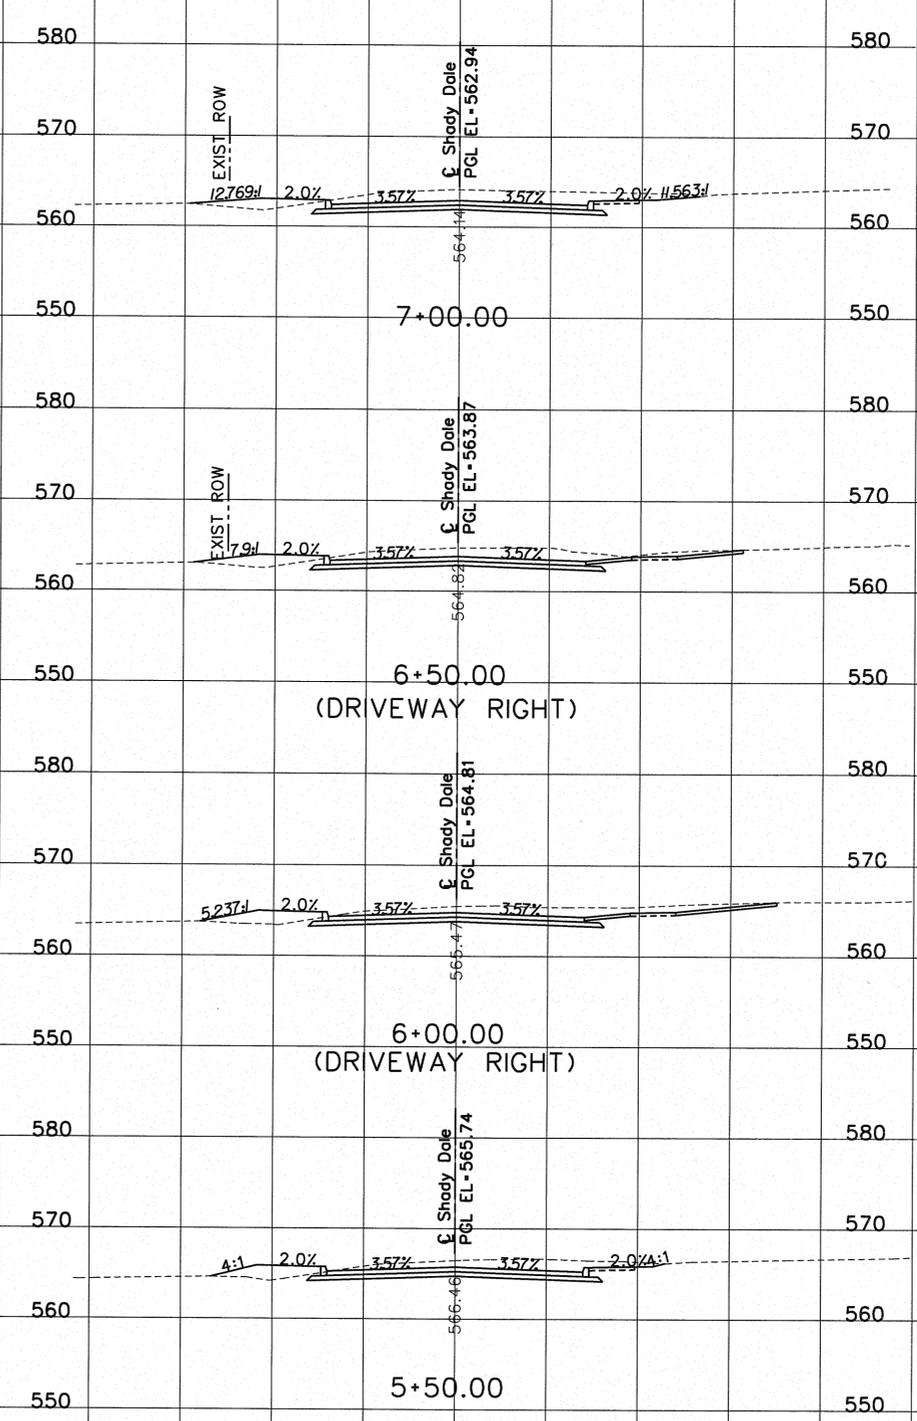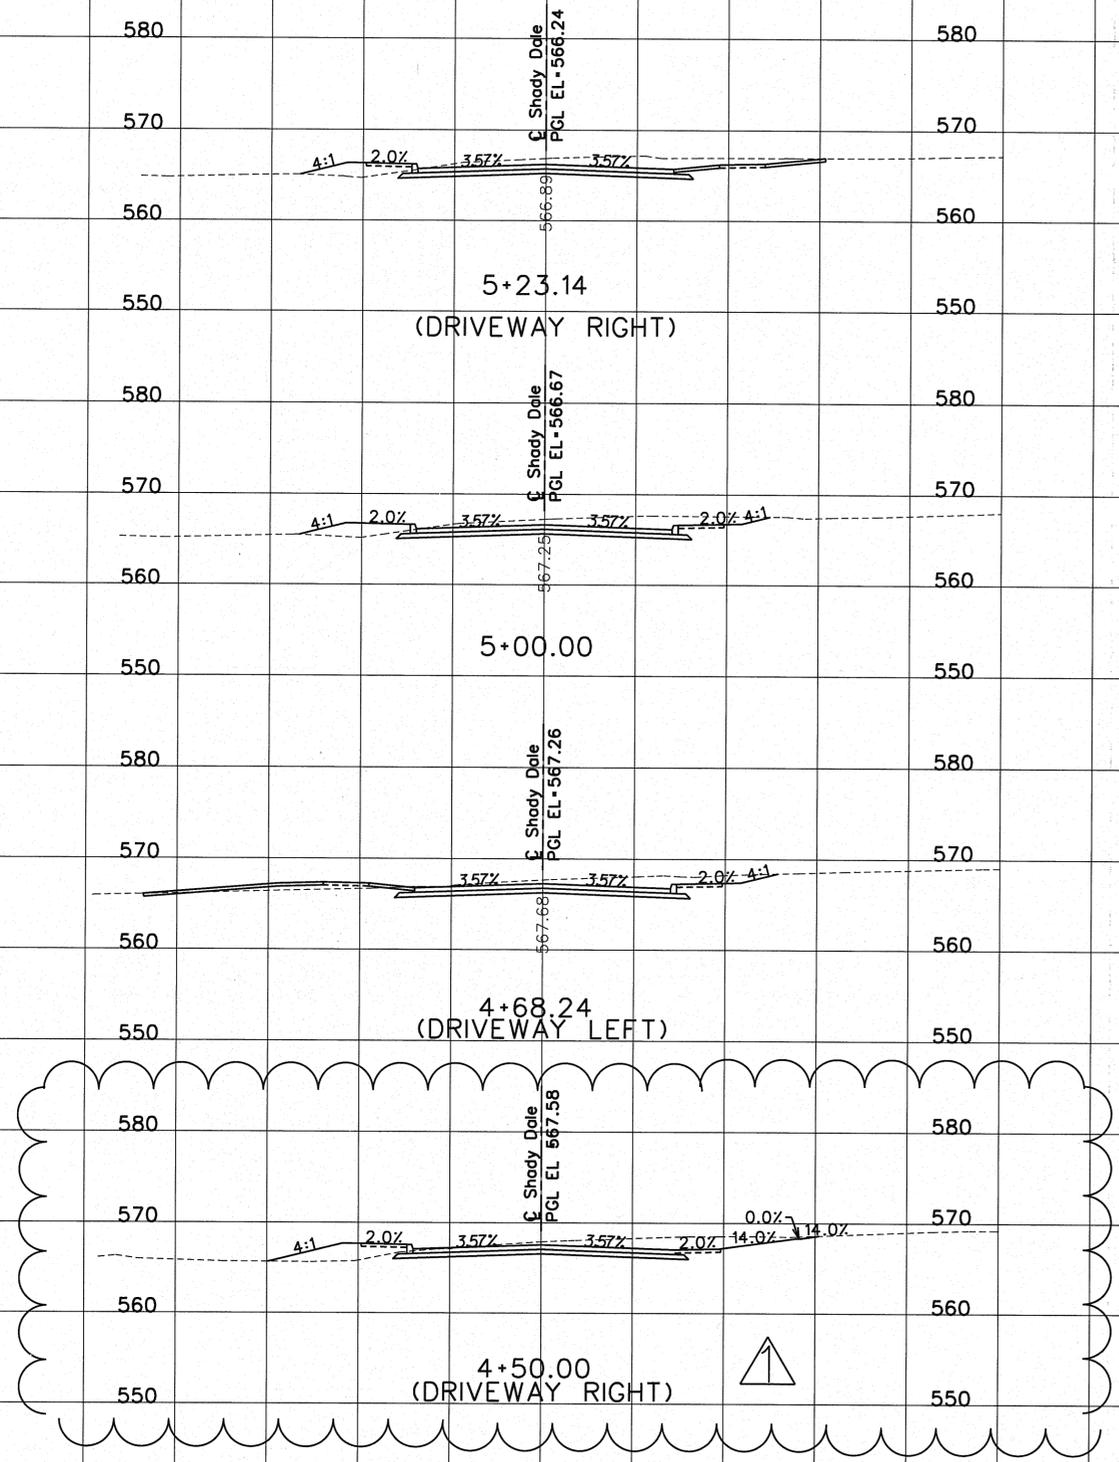


5 TIMES
 \$\$\$\$\$\$SYTIME\$\$\$\$\$\$
 \$\$\$\$\$\$DGN\$PC\$\$\$\$\$\$

81TIME\$
 \$\$\$SYTIME\$\$\$\$\$
 \$\$\$DONSPEC\$\$\$\$\$

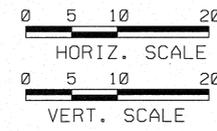

▲ REVISED CUT/FILL LIMITS, SLOPE 3:1 ON SOUTH SIDE OF ROADWAY

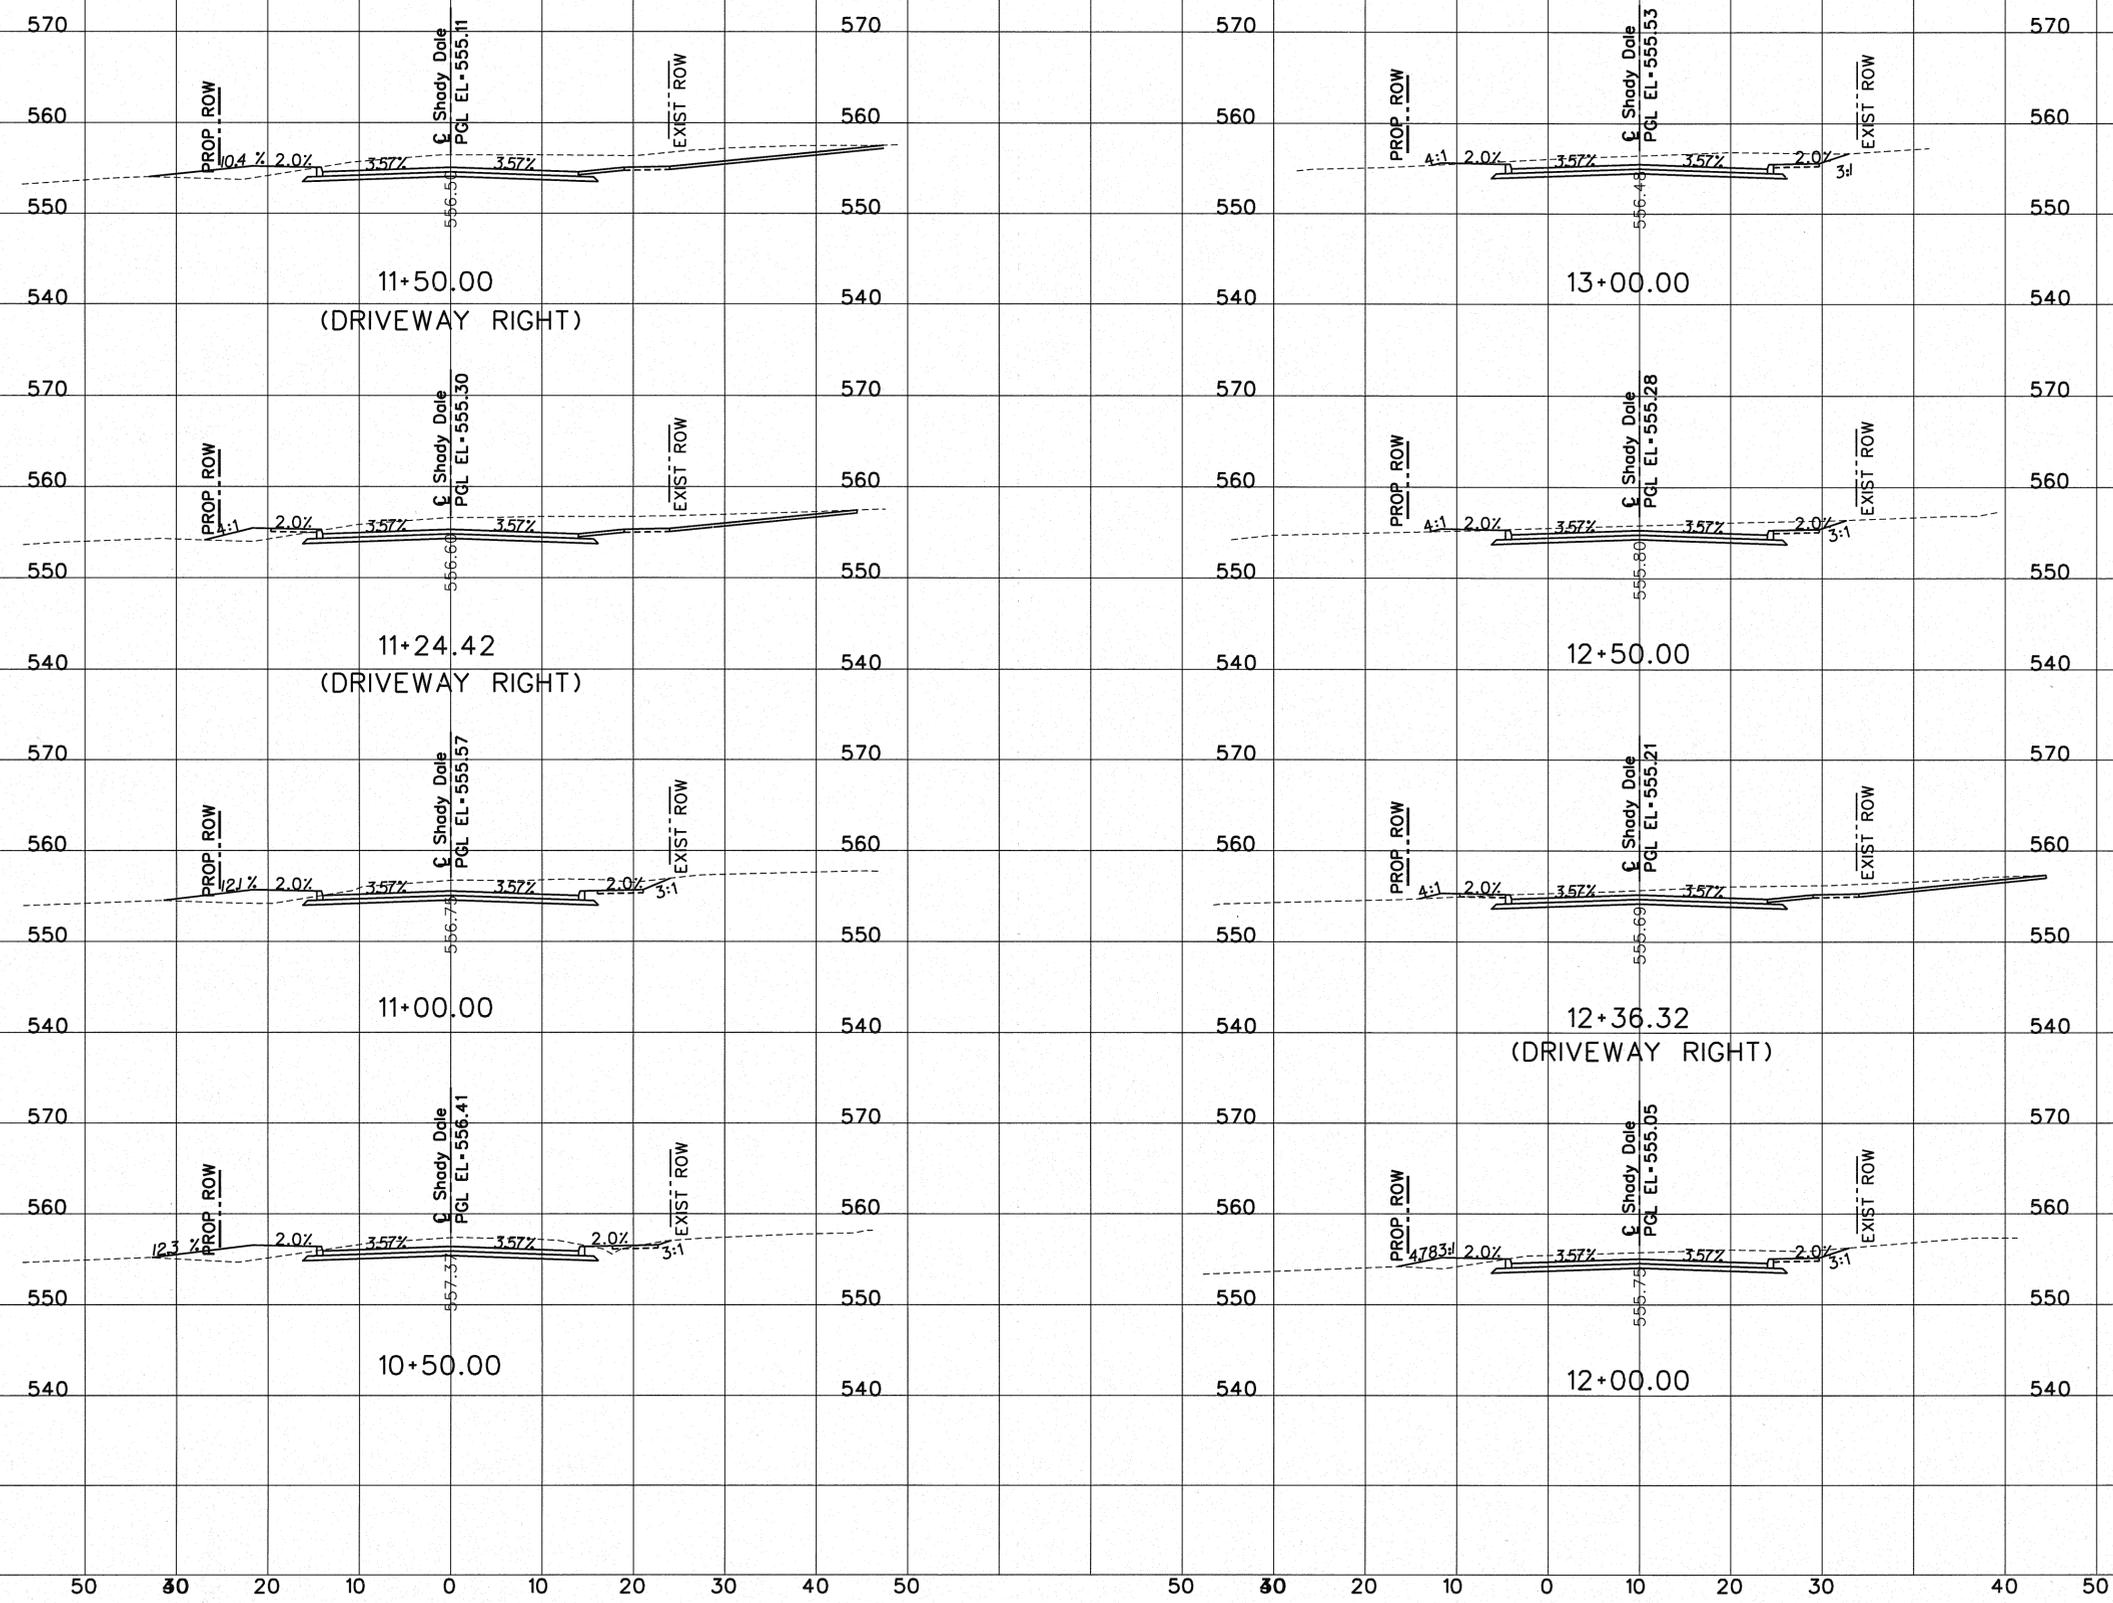

RECORD DRAWING
 THE SEAL THAT ORIGINALLY APPEARED ON THIS DOCUMENT WAS AUTHORIZED BY TED B. SUGG, TEXAS NO 82775 ON 10-1-09 THESE RECORD DRAWINGS WERE PREPARED BASED UPON THE CONSTRUCTOR DRAWINGS PROVIDED BY THE CONTRACTOR WHO OBTAINED THEM FROM THE APPROVED DIVISIONS FROM THE APPROVED DRAWINGS WERE INCLUDED ON APRIL 18, 2011.

CITY OF ROCKWALL
 SHADY DALE LANE
 SHADY DALE LANE
 CROSS SECTIONS




NO.	REVISION	BY	DATE
1	REVISED CUT/FILL LIMITS, SLOPE 3:1	TBS	11/17/09


DESIGN: CRH / TBS	CHECKED: PBS&J
DRAWN: CRH / TBS	APPROVED: PBS&J

TEPE REG. 4-474
 8383 PRESTON ROAD, SUITE 110
 DALLAS, TEXAS 75252
 PBS&J JOB NO.: 52091000
 DATE: SEPTEMBER 2009
 FILE: \$FILE\$\$

 \$TIME\$

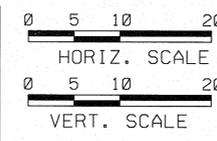

▲ REVISED CUT/FILL LIMITS, SLOPE 3:1 ON SOUTH SIDE OF ROADWAY

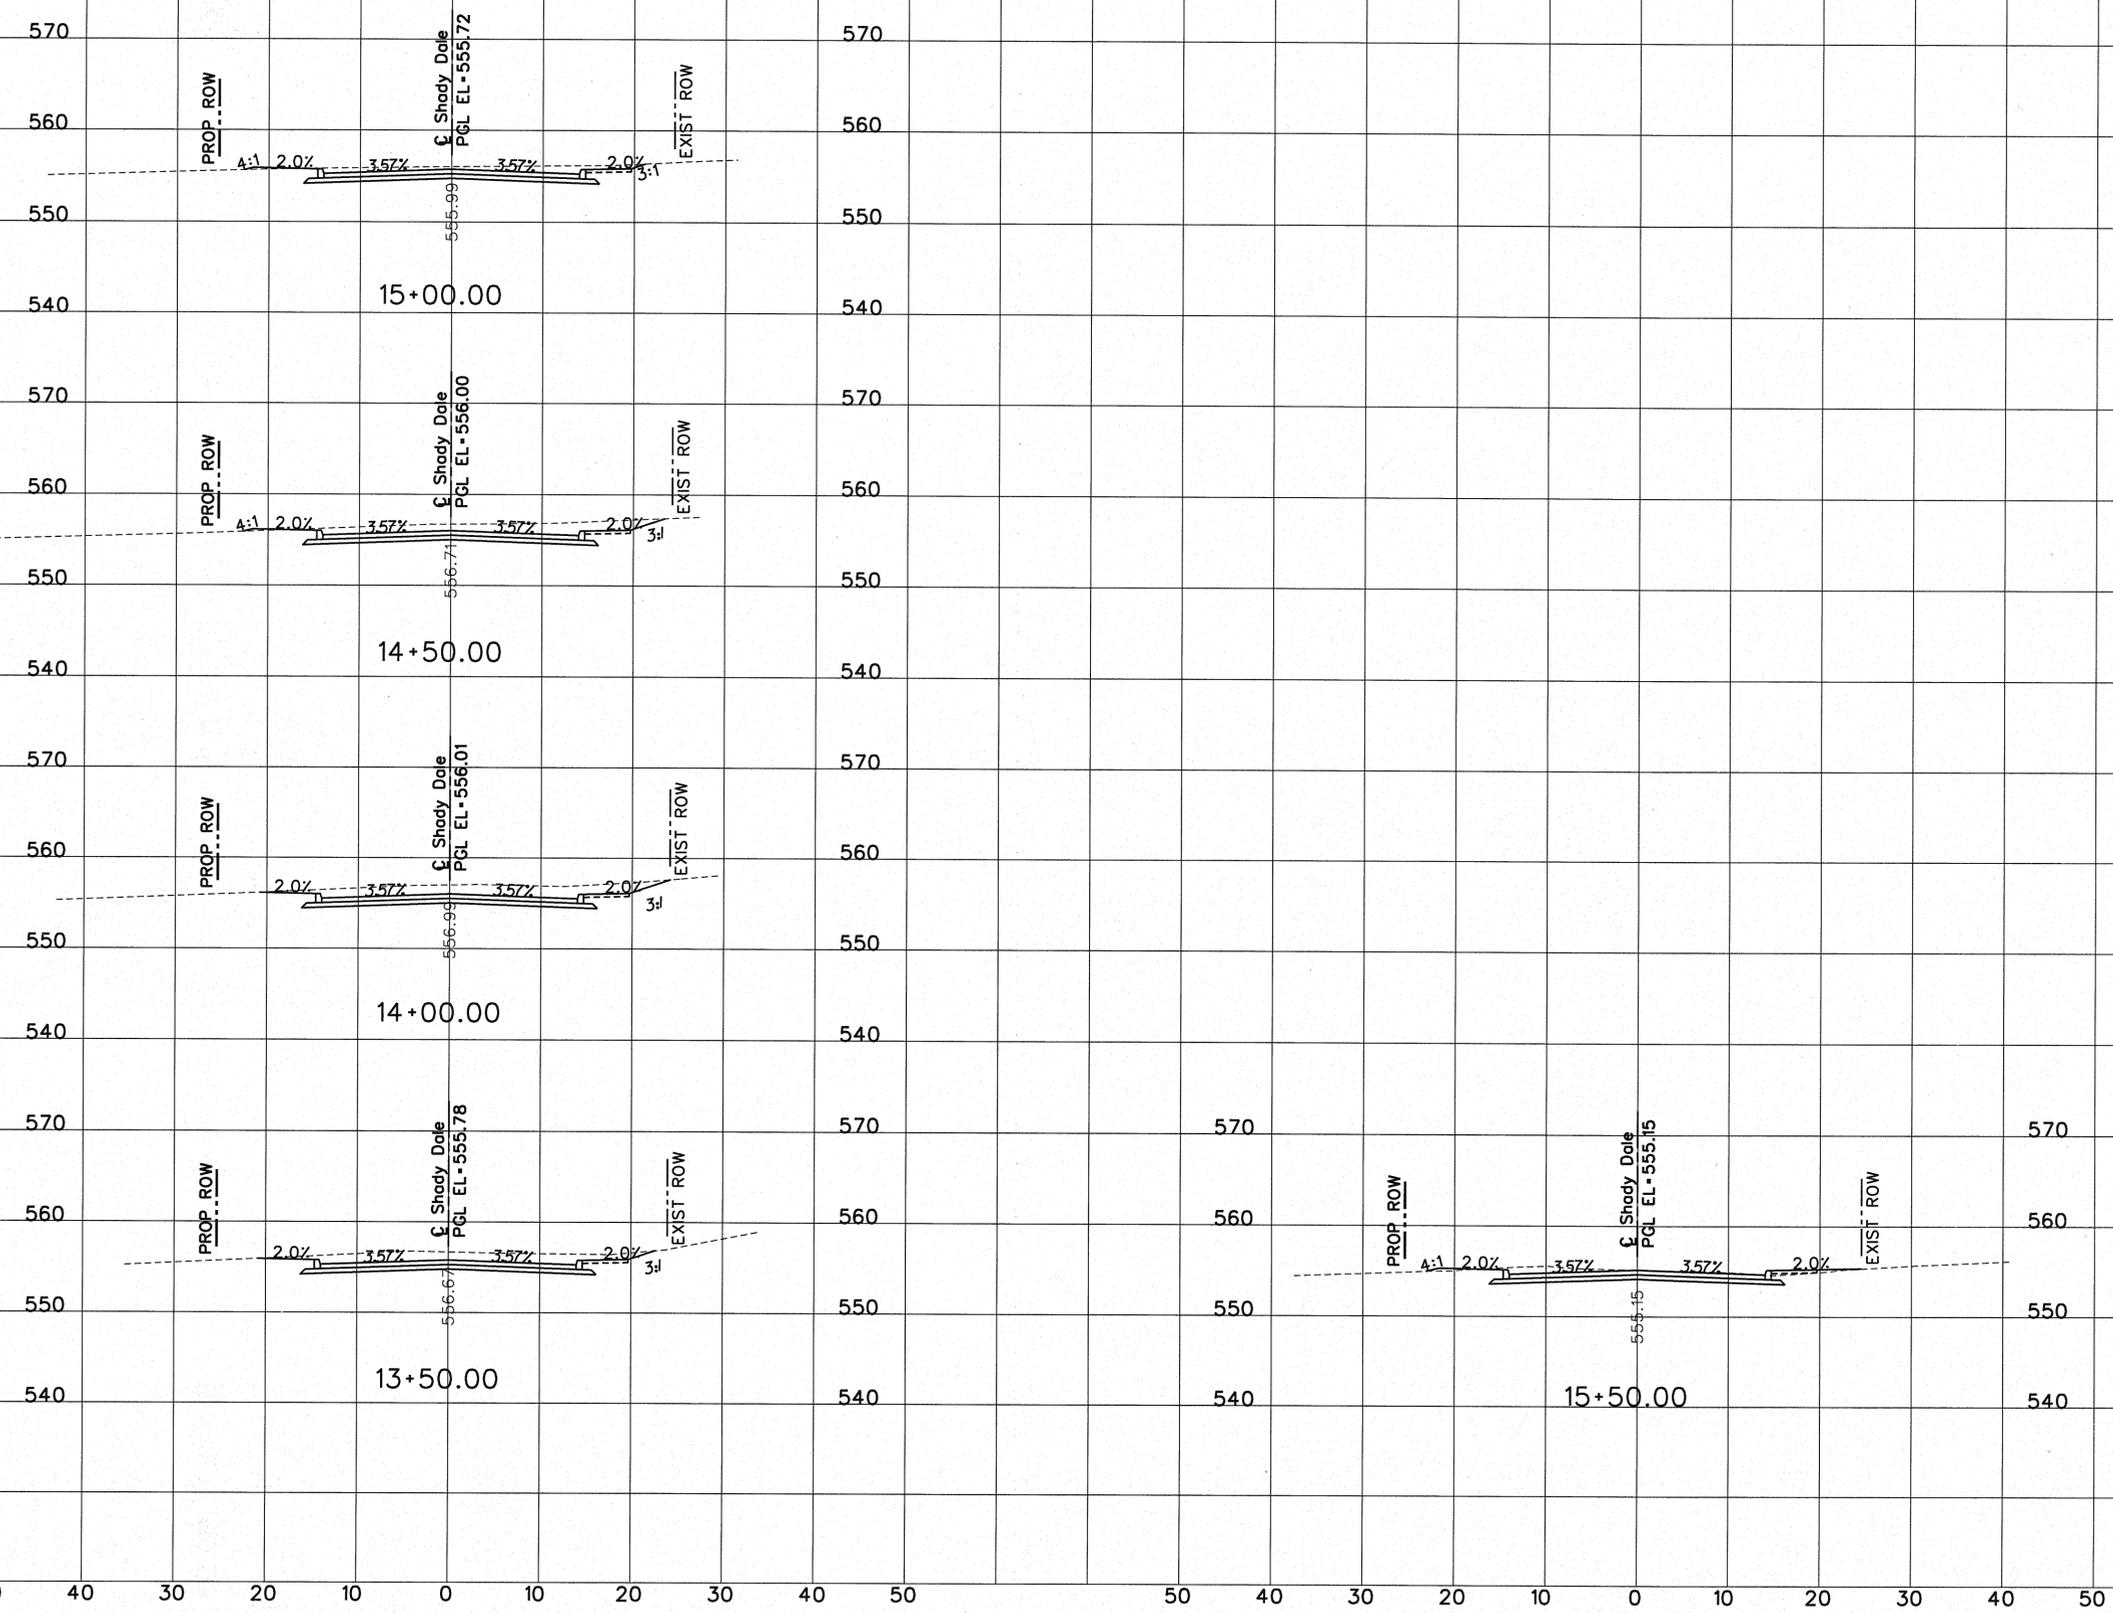

RECORD DRAWING
 THE SEAL THAT ORIGINALLY APPEARED ON THIS DRAWING IS THE SEAL OF THE ENGINEER OR ARCHITECT WHOSE NAME IS ON THE DRAWING. THESE RECORD DRAWINGS WERE PREPARED BY THE CONTRACTOR WHOSE NAME IS ON THE DRAWING. THESE RECORD DRAWINGS REPRESENTED BY THE CONTRACTOR WHOSE NAME IS ON THE DRAWING. DEVIATIONS FROM THE APPROVED ORIGINAL DRAWINGS ARE NOT TO BE CONSIDERED UNLESS INDICATED OTHERWISE. APRIL 18, 2011

CITY OF ROCKWALL
 SHADY DALE LANE
 SHADY DALE LANE
 CROSS SECTIONS



NO.	REVISION	BY	DATE
1	REVISED CUT/FILL LIMITS, SLOPE 3:1	TBS	11/17/09

DESIGN: CRH / TBS	CHECKED: PBS&J
DRAWN: CRH / TBS	APPROVED: PBS&J

TYPE REC: 4-474	DATE: 11/17/09
18383 PRESTON ROAD, SUITE 110	DATE: 11/17/09
DALLAS, TEXAS 75252	DATE: 11/17/09
972-816-7275	DATE: 11/17/09
PBS&J JOB NO.: 5209000	DATE: SEPTEMBER 2009
FILE: \$FILE\$	

