


SCALE: 1"=20'

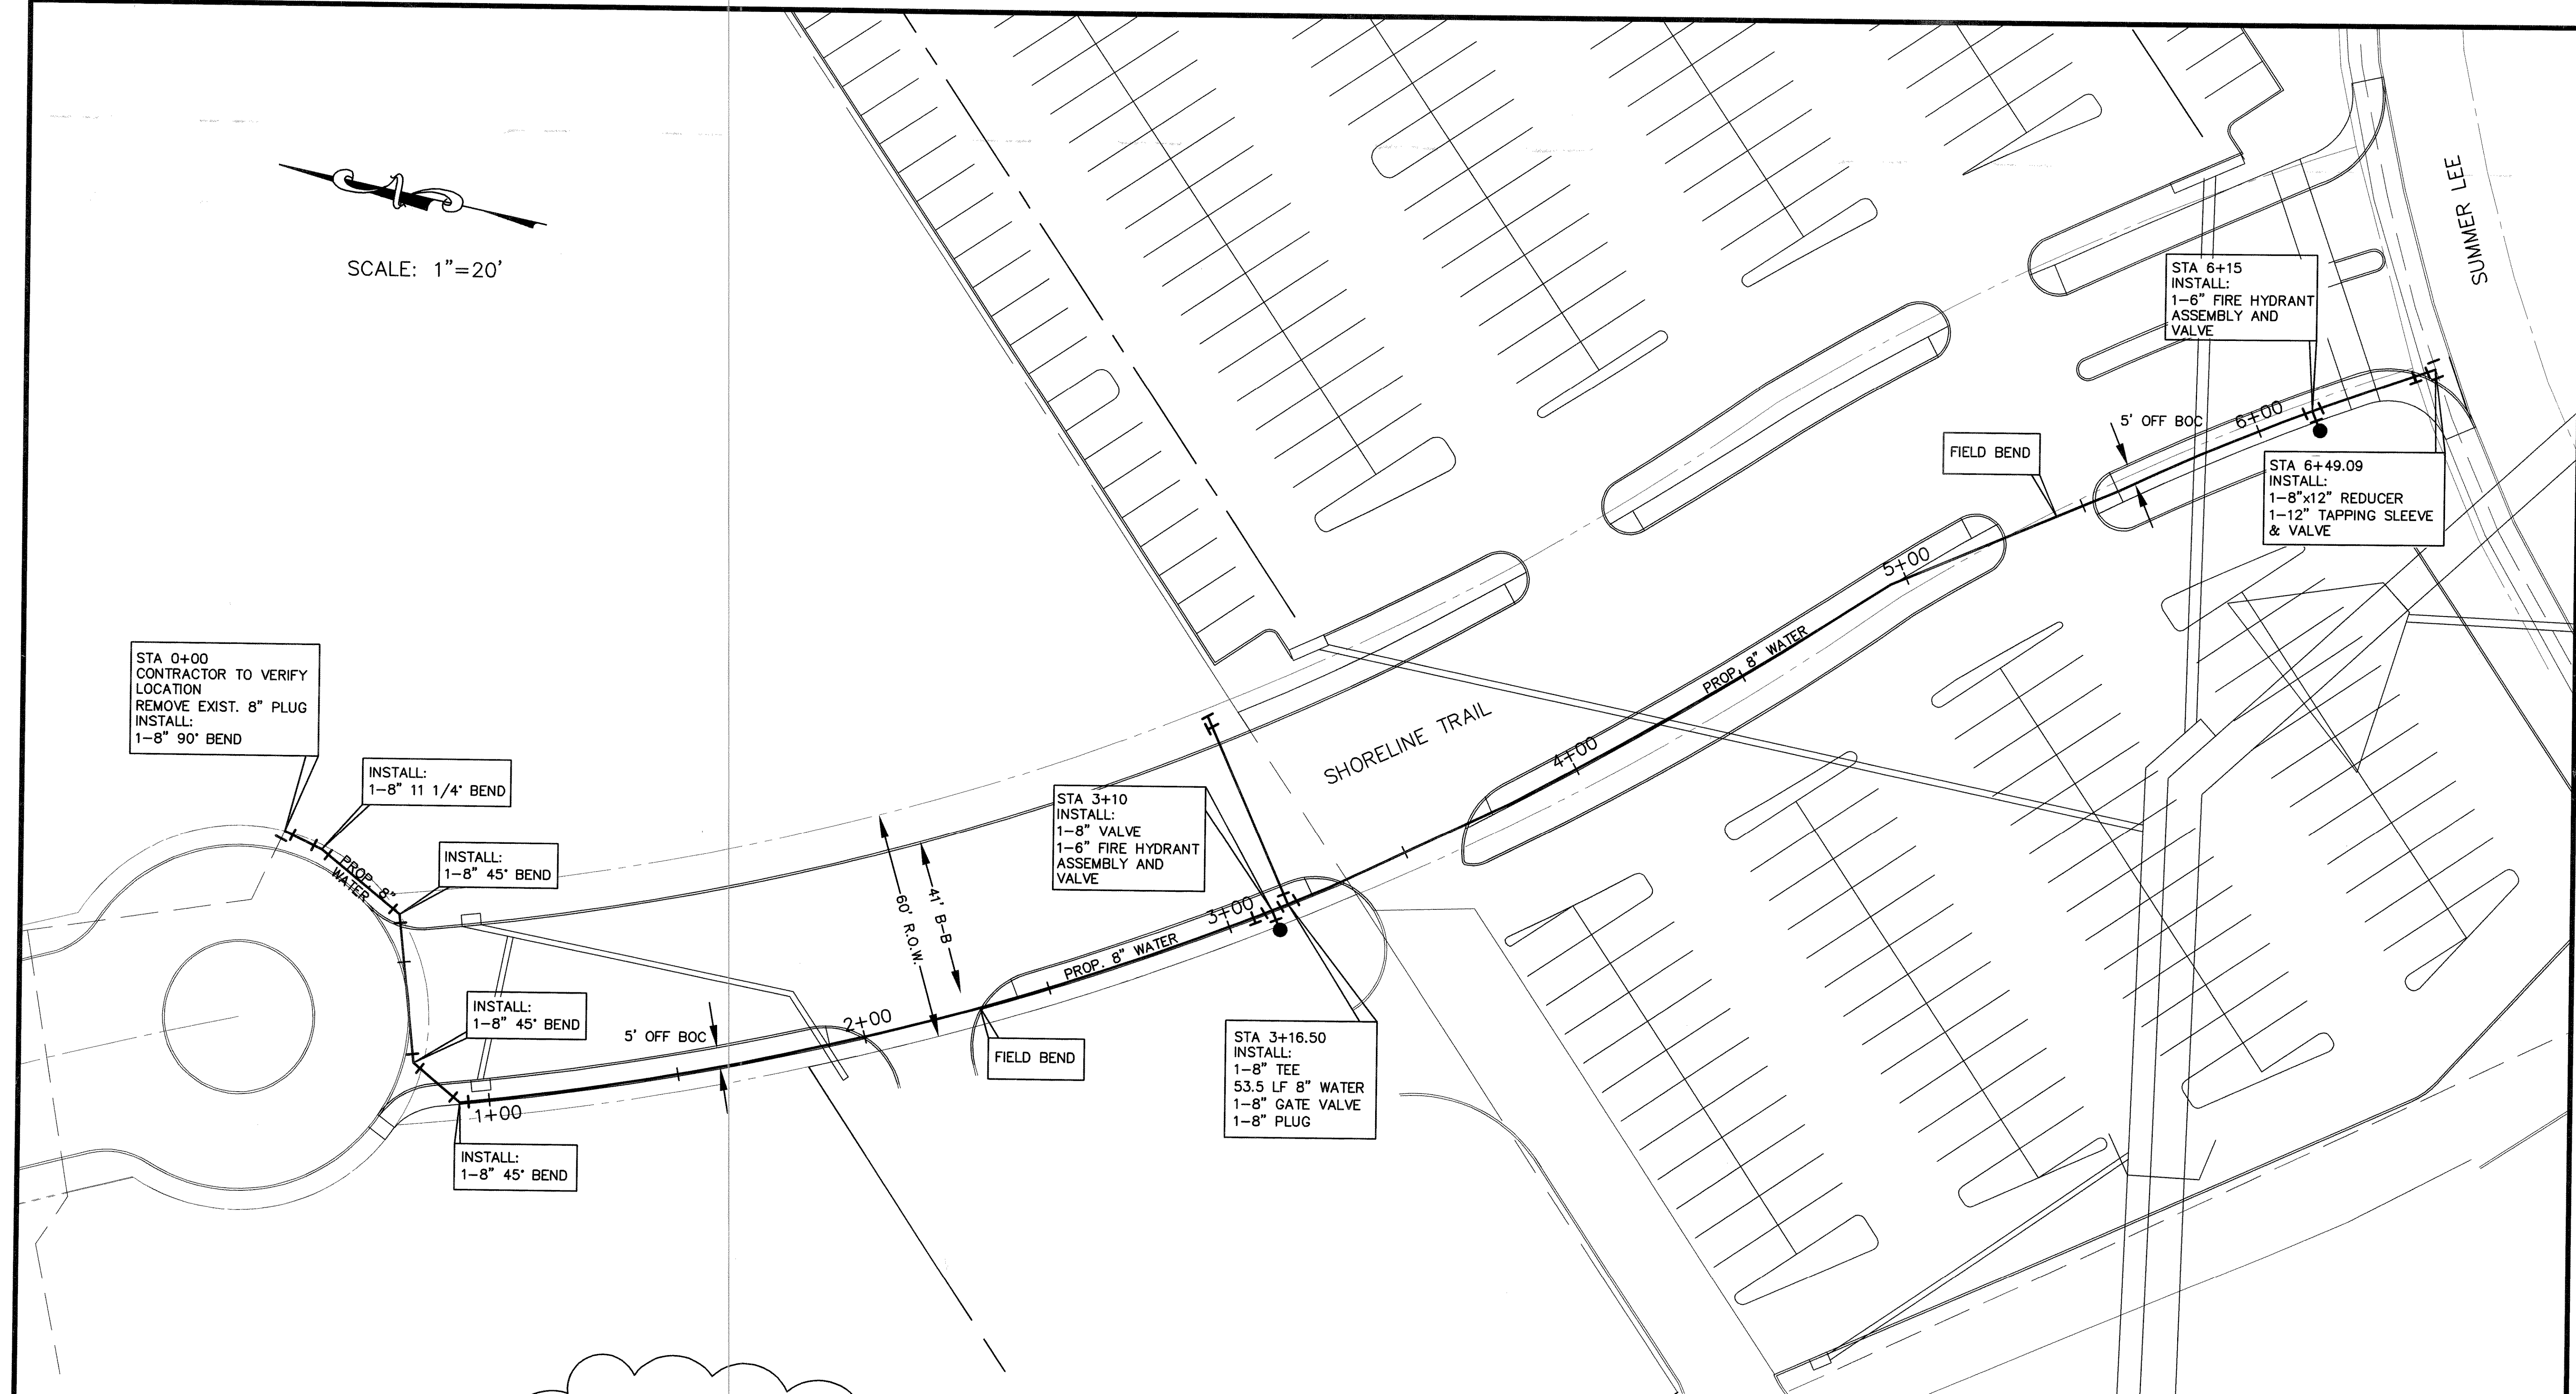

STA 0+00
CONTRACTOR TO VERIFY
LOCATION
REMOVE EXIST. 8" PLUG
INSTALL:
1-8" 90° BEND

INSTALL:
1-8" 11 1/4° BEND

INSTALL:
1-8" 45° BEND

INSTALL:
1-8" 45° BEND

INSTALL:
1-8" 45° BEND

STA 3+10
INSTALL:
1-8" VALVE
1-6" FIRE HYDRANT
ASSEMBLY AND
VALVE

STA 3+16.50
INSTALL:
1-8" TEE
53.5 LF 8" WATER
1-8" GATE VALVE
1-8" PLUG

STA 6+15
INSTALL:
1-6" FIRE HYDRANT
ASSEMBLY AND
VALVE

STA 6+49.09
INSTALL:
1-8"x12" REDUCER
1-12" TAPPING SLEEVE
& VALVE

WARNING:
CONTRACTOR RESPONSIBLE FOR
LOCATION OF ALL EXISTING UTILITIES
AND ANY REPLACEMENT, REPAIR OR
DAMAGE TO ANY EXISTING UTILITIES.
KEEP EXISTING UTILITIES IN SERVICE
AT ALL TIMES.

WATER LINE LAYOUT
SHORELINE EXTENSION
ROCKWALL, TEXAS
CITY OF ROCKWALL
"THE NEW HORIZON"

REVISION NO.	REMARKS	DATE

DESIGNED: KRL
DRAWN: ACAD
JOB NO. DATE: JAN 2007 SHEET NO. 6 OF 6

STATE OF TEXAS
KATHLEEN R. LAPPEN
94603
LICENSED PROFESSIONAL ENGINEER