

# CITY OF ROCKWALL, TEXAS

## CONSTRUCTION PLANS FOR

# SHORES NORTH DRAINAGE IMPROVEMENTS

**COUNCIL MEMBERS**

- BILL CECIL, MAYOR**
- STEPHEN STRAUGHAN, MAYOR PRO-TEM**
- GLEN FARRIS**
- MARGO NIELSEN**
- MATT SCOTT**
- CLIFF SEVIER**
- DAVID SWEET**

**CITY MANAGER**


**JULIE COUCH**

**ASSISTANT CITY MANAGER**

**RICHARD CROWLEY**

**CITY ENGINEER**

**CHUCK TODD, P.E.**

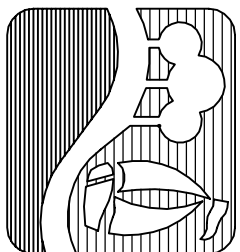

**BIRKHOFF, HENDRICKS & CONWAY, L.L.P.**  
CONSULTING ENGINEERS  
Dallas, Texas


**JANUARY 2008**

*This record drawing is a completion of the sealed engineering drawing for this project, modified by addenda, change orders and information furnished by the contractor. The information shown on the record drawings that was provided by the contractor or others not associated with the design engineer cannot be verified for accuracy or completeness. This original sealed drawing is on file at the offices of Birkhoff, Hendricks & Conway, L.L.P.*

By RYC DATE 4/07/09



*Ronald V. Conway*  
4/21/08

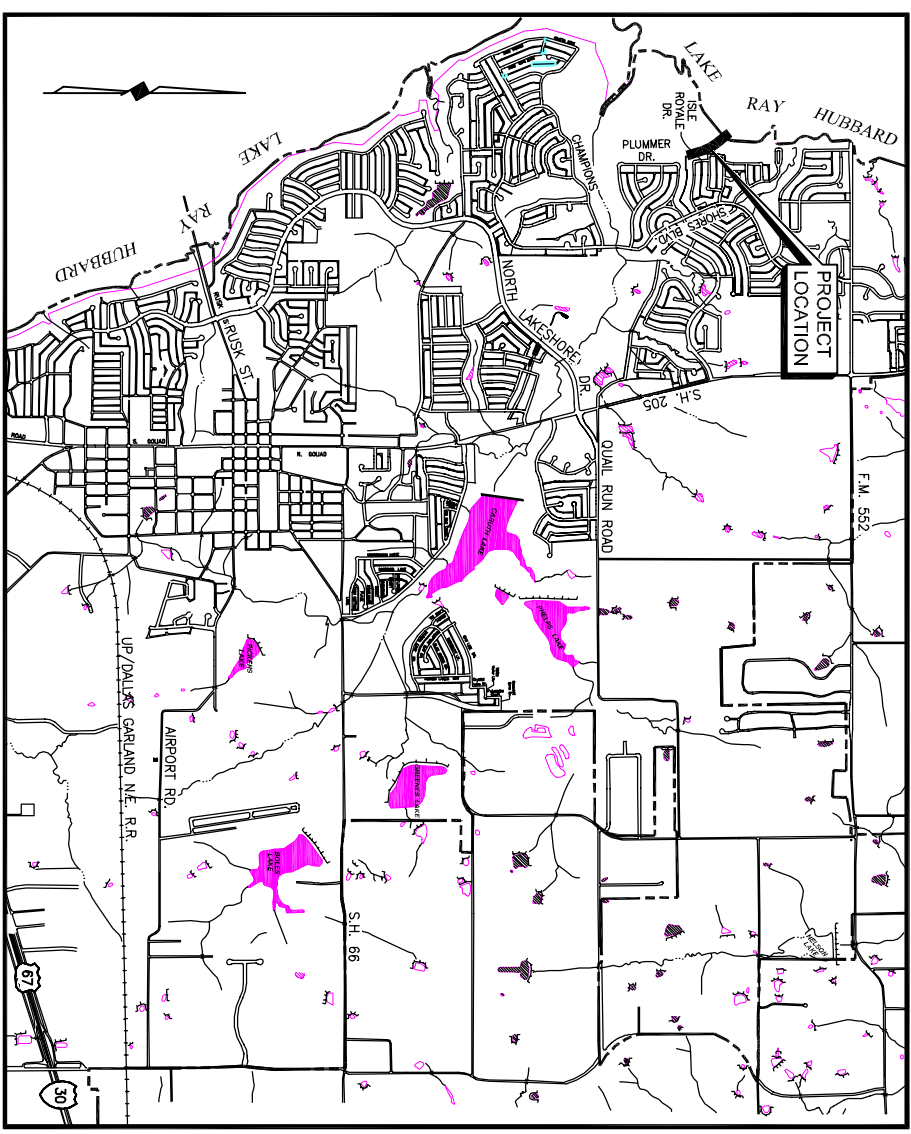

**LOCATION MAP**

<b><u>SHEET NO.</u></b>	<b><u>SHEET INDEX</u></b>	<b><u>SHEET DESCRIPTION</u></b>
1		COVER SHEET AND LOCATION MAP
2		GENERAL NOTES
3		DRAINAGE AREA MAP
4		54" STORM SEWER PLAN-PROFILE
5		48" STORM SEWER PLAN-PROFILE
		TYPICAL SECTIONS
		CROSS SECTIONS
6 - 11		STORM WATER POLLUTION PREVENTION
12 - 14		NOTES AND DETAILS
15		CONCRETE HEADWALL (CH-FW-0)