


STA. 0+00
F.L. 54" 434.90
REMOVE EXIST. HDWL.
CONNECT TO EXIST. 54" R.C.P.

STA. 5+50
F.L. 54" 434.35
CONST. 2-54" HEADWALL
BEGIN PROPOSED CHANNEL

This record drawing is a completion of the sealed engineering drawing for this project modified by addenda, change orders and information furnished by the contractor. The information shown on the record drawings that was provided by the contractor or others not associated with the design engineer cannot be verified for accuracy or completeness. This original sealed drawings are on file at the office of Birkhoff, Hendricks & Conway, L.L.P.
BY RYC DATE 4/07/09

BIRKHOFF, HENDRICKS & CONWAY, L.L.P.
CONSULTING ENGINEERS
7502 Greenville Ave., Suite 220
Dallas, Texas
(214) 361-7900

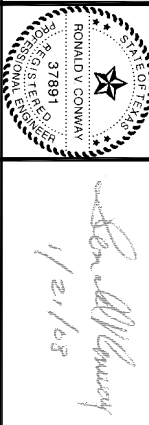

CITY OF ROCKWALL, TEXAS
SHORES NORTH DRAINAGE IMPROVEMENTS
54" STORM SEWER PLAN-PROFILE

BHC PROJECT NO. 2006-186
SHEET NO. **4**
JANUARY 2008

REVISED: 4/7/09 - WHAYS

H:\Projects\Rockwall\2006186 Shores North Drainage\Sheets\2006186-pp1.dwg

PLOT SCALE: 1:80

PLOT STYLE: 11x17.ctb

PLOTTED BY: WHAYS ON 4/7/2009

