


- NOTES:**
1. FOR MAINS 42" DIAMETER AND LARGER, LARGER, 1/8 Bc SHALL BE TAKEN AS 6".
 2. Bc = OUTSIDE DIAMETER OF PIPE
 3. Bd = TRENCH WIDTH
- CLASS "B"**

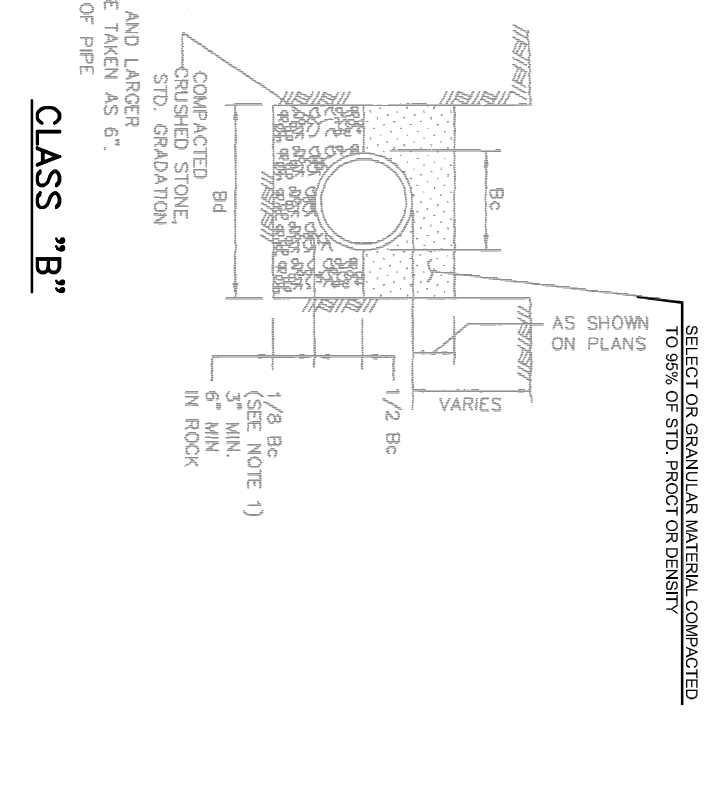

This record drawing is a compilation of the sealed engineering drawing for this project, modified by addenda, change orders and information furnished by the contractor. The information shown on the record drawings that was provided by the contractor or others not associated with the design engineer cannot be verified for accuracy or completeness. This original sealed drawings are on file at the offices of Birkhoff, Hendricks & Conway, L.L.P.

By RYC DATE 4/07/09

BIRKHOFF, HENDRICKS & CONWAY, L.L.P.
CONSULTING ENGINEERS
7502 Greenville Ave., Suite 220
Dallas, Texas
(214) 361-7900

CITY OF ROCKWALL, TEXAS
SHORES NORTH DRAINAGE IMPROVEMENTS
48" STORM SEWER PLAN-PROFILE
TYPICAL SECTIONS

BHC
PROJECT NO.
2006-186
JANUARY 2008

SHEET NO.
5

REVISION: 4/7/09 - WHXS

H:\Projects\Rockwall\2006186 Shores North Drainage\Sheets\2006186-PP2.dwg

PLOT SCALE: 1:80

PLOT STYLE: 11x17.ctb

PLOTTED BY: WHXS ON 4/7/2009