



REF: NOTATION: 01/01/000000
 PLAN: 11/11/000000
 DATE: 11/11/000000
 PROJECT: 01/01/000000

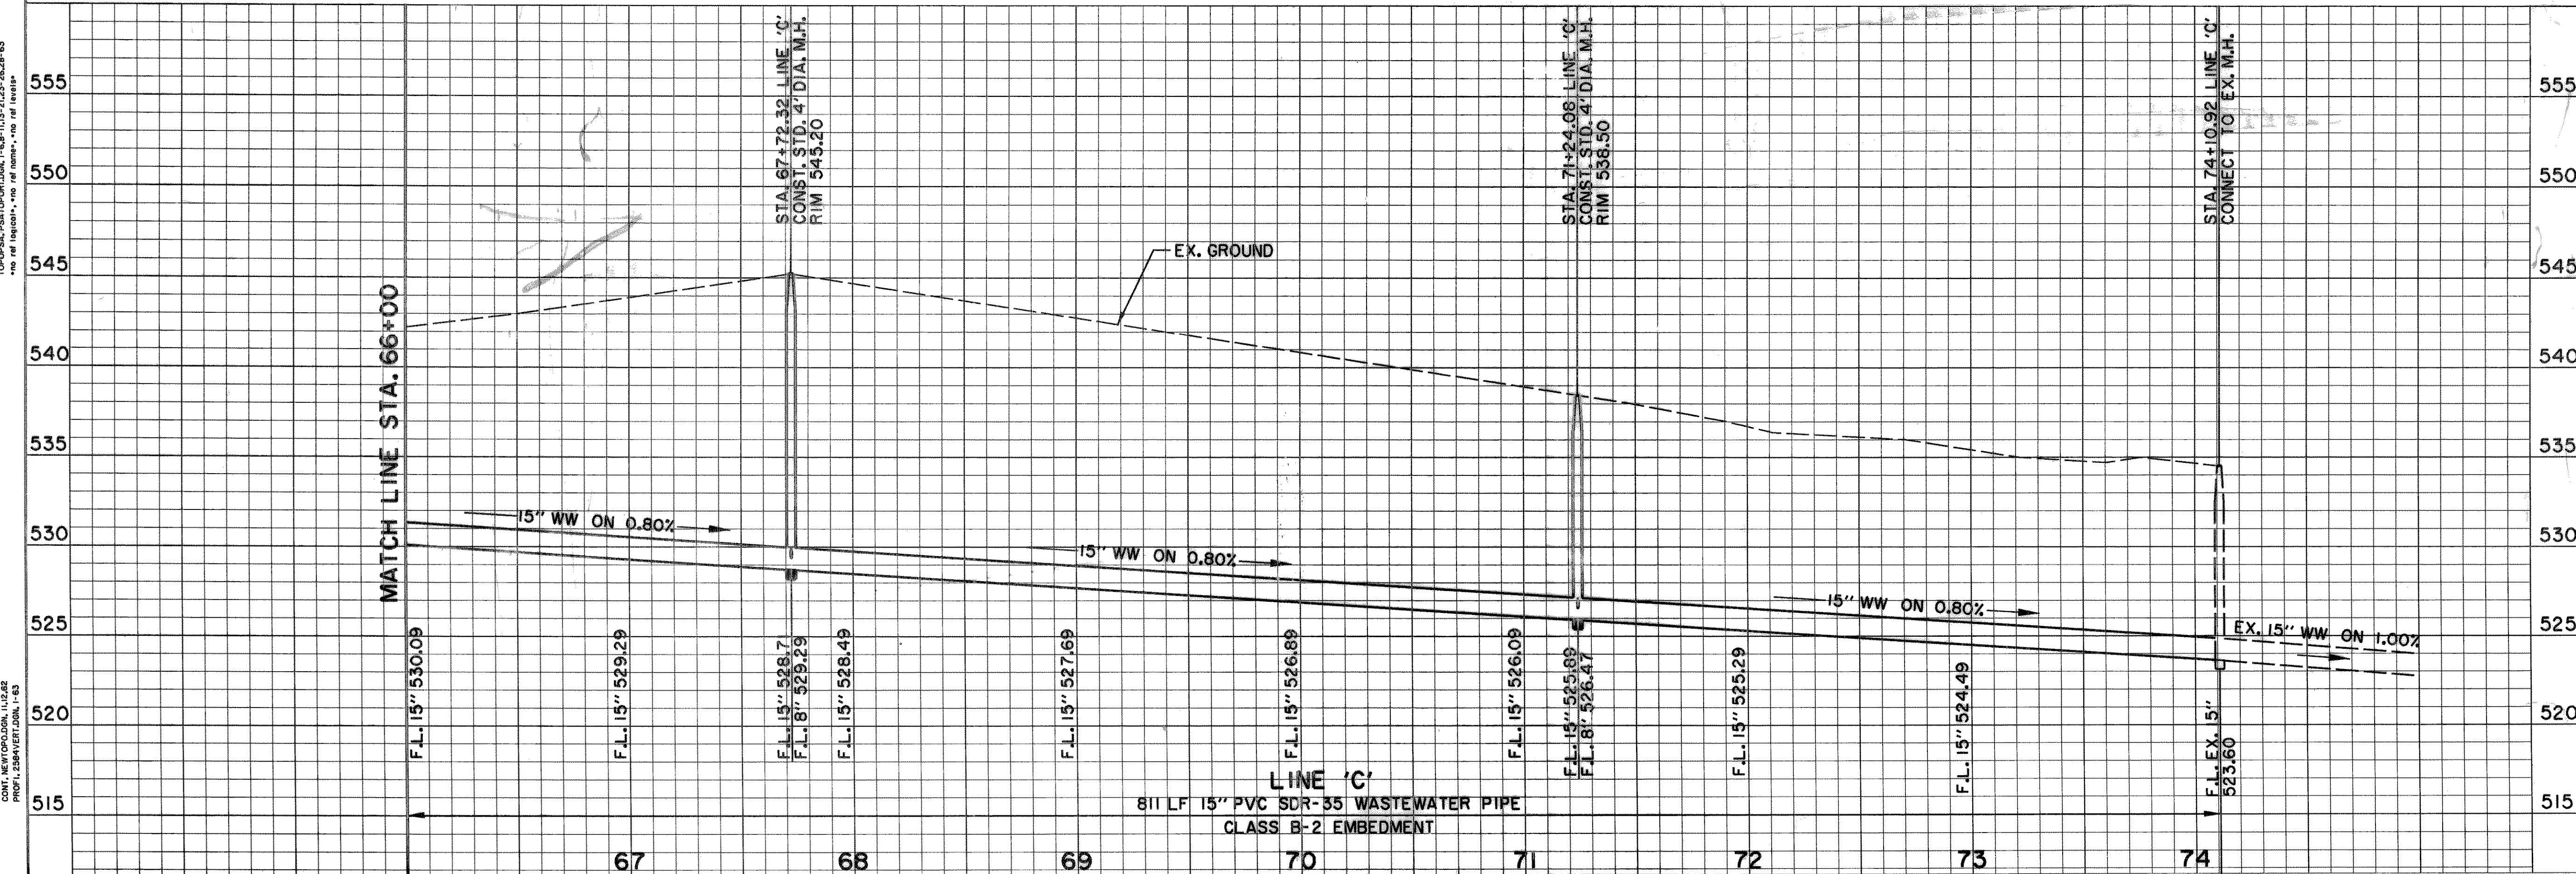

BENCHMARKS:

BM #1 'C' CUT ON TOP OF SIGNAL RIDGE WET-WELL @ BACK OF PARKING LOT SIGNAL RIDGE PHASE 4, NEAR LIFT STATION 150' +/- FROM EDGE OF LAKE RAY HUBBARD ELEVATION 450.49

BM #2 R.R. SPIKE IN POWER POLE AT NORTH WEST CORNER OF RIDGE ROAD AND THE ENTRANCE TO GLEN HILLS CEMETERY. ELEVATION 560.65

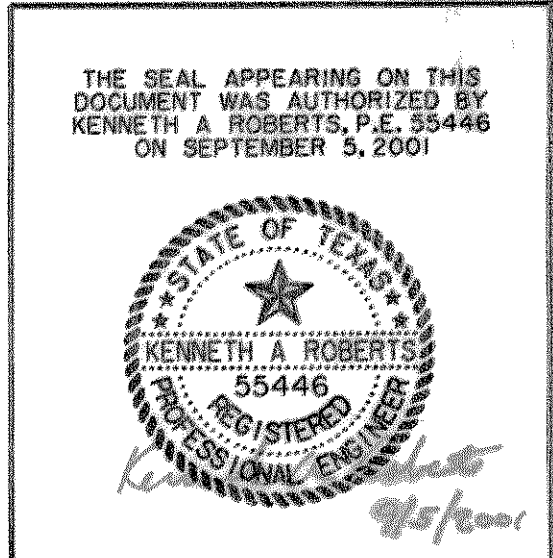

WASTEWATER PLAN & PROFILE						
STA. 66+00 TO ROCKWALL PARKWAY						
LINE 'C' - GRAVITY MAIN						
SIGNAL RIDGE						
CITY OF ROCKWALL, TEXAS						
Huff+Zollars, Inc.						
Dallas, Ft. Worth, Houston, El Paso, Albuquerque, Denver, Phoenix, Tucson, Ontario, Seattle, Tacoma						
DESIGN	DRAWN	APPR.	SCALE	DATE	PROJECT NO.	NO.
HZI	HZI	KAR	H ₁ 1"=40' V ₁ 1"=5'	SEPT 2001	01258401	14