


A ALTITUDE VALVE INSTALLATION PLAN
SCALE: 3/8" = 1'-0"

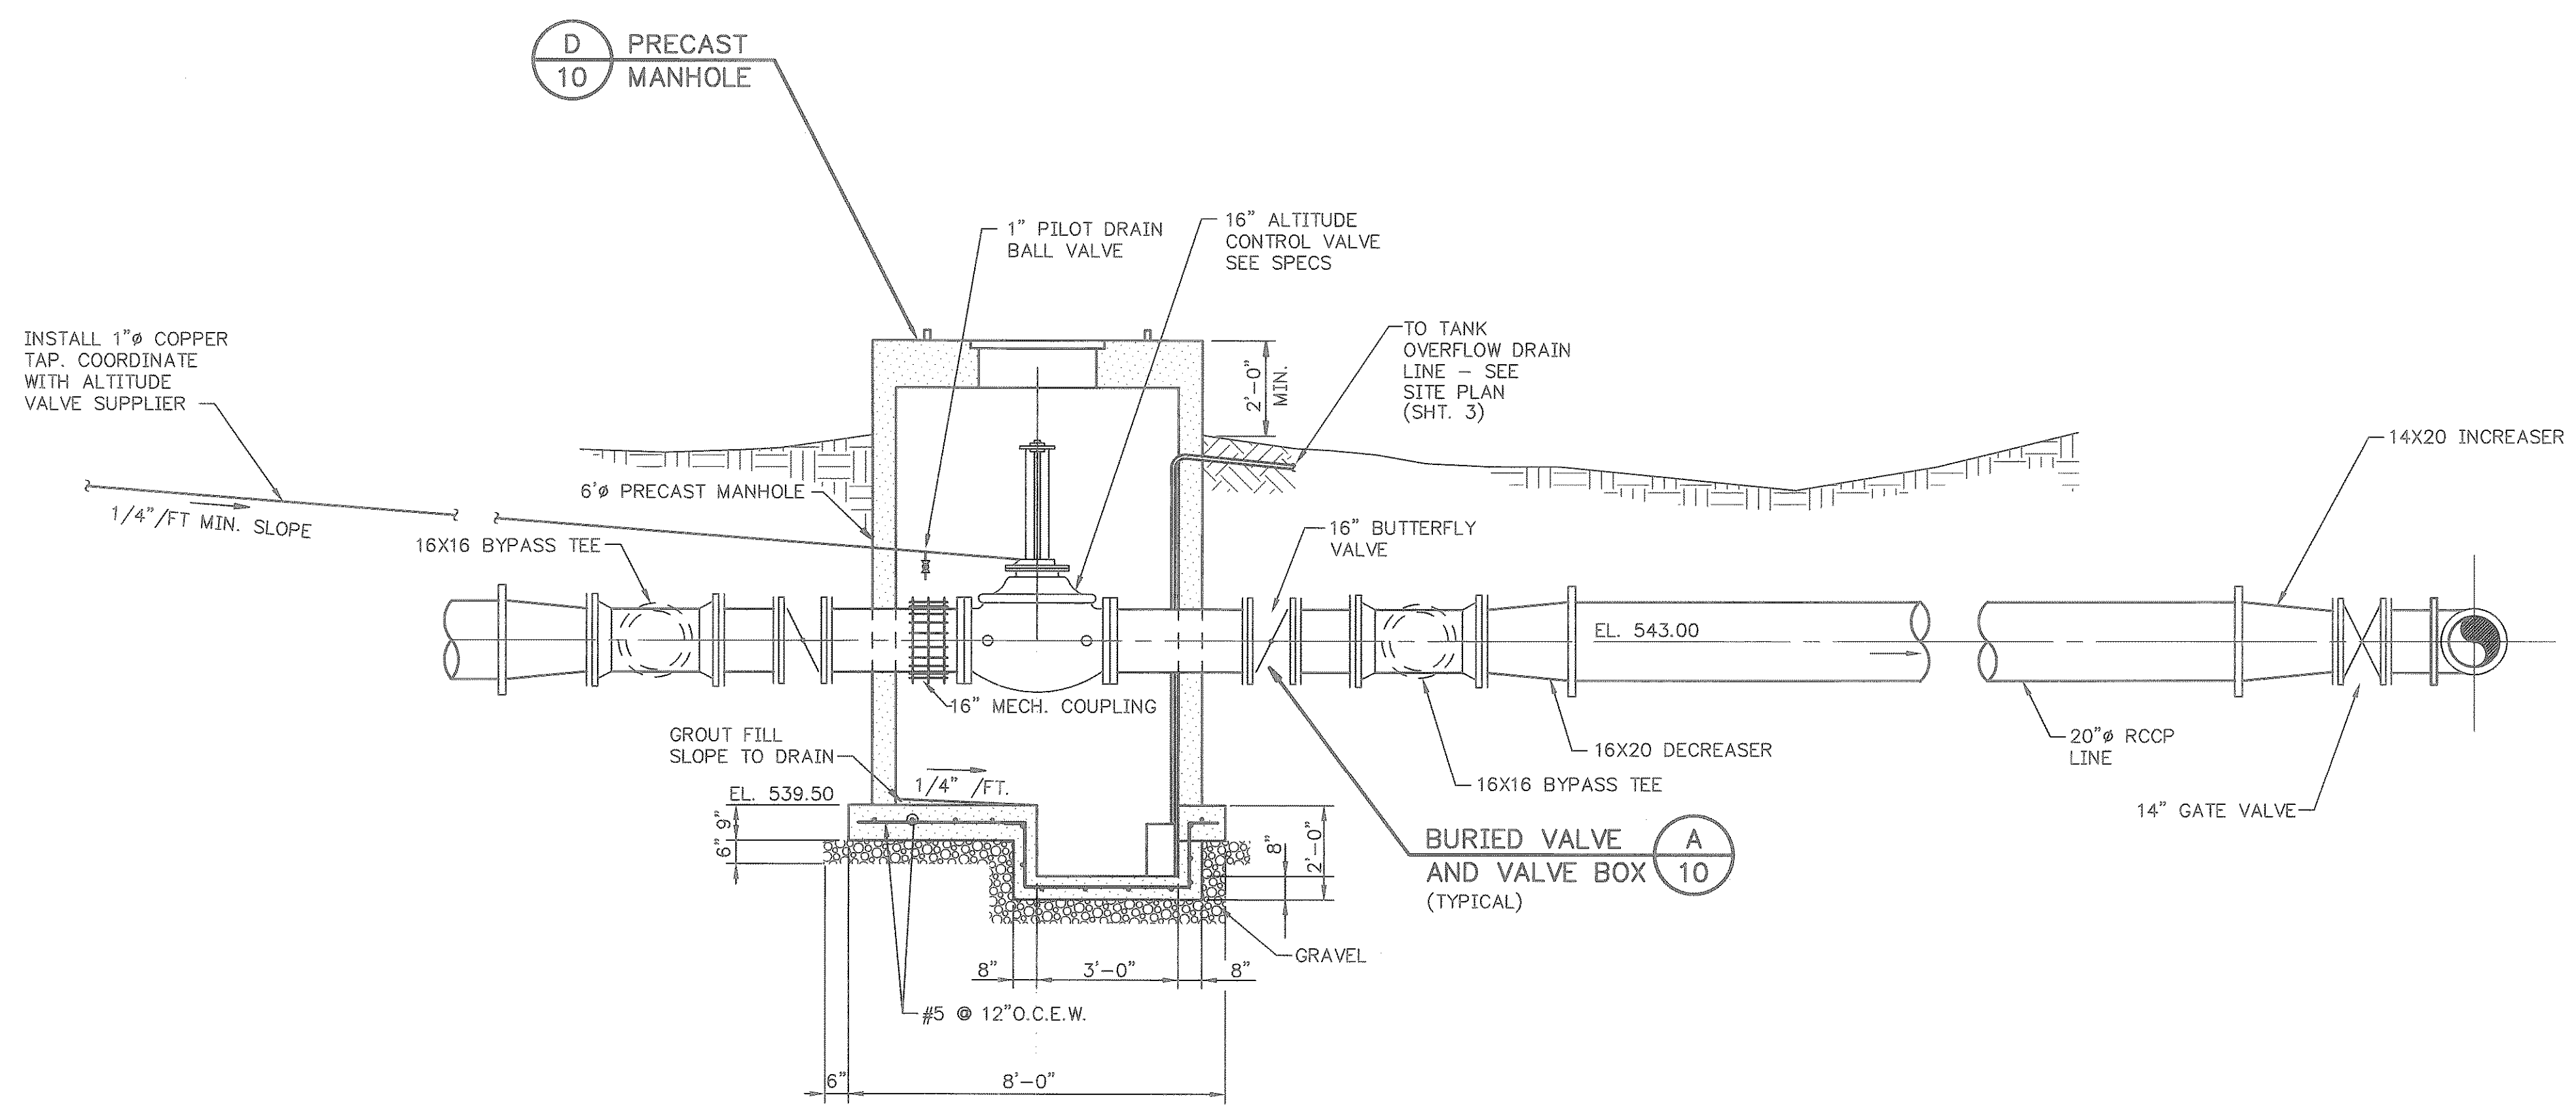

2 ALTITUDE VALVE INSTALLATION SECTION
SCALE: 3/8" = 1'-0"

THESE DOCUMENTS HAVE BEEN PREPARED BASED ON INFORMATION PROVIDED BY OTHERS. THE ACCURACY AND/OR COMPLETENESS OF THIS INFORMATION WAS VERIFIED BY THE CONTRACTOR.

No.	Date	Revisions	App.

Chiang, Patel and Associates, Inc.
Consulting Engineers • Planners • Project Managers
Dallas, Texas

RECORD DRAWING
PHILIP S. YERBY, P.E. #51735
CHIANG, PATEL & YERBY, INC.

CITY OF ROCKWALL
"THE NEW HORIZON"

CITY OF ROCKWALL
SOUTHSIDE ELEVATED
STORAGE TANK
**ALTITUDE VALVE AND
STORM DRAIN DETAILS**

Scale: AS SHOWN Date: FEB. 1994
Designed by: R. O'CONNELL
Drawn by: R. TUNNELL
Checked by:
Approved by: F. RASOR
Project No. CR0 9357.20

I:\CRO9357\7-96\9357\SH07.dwg Mon Aug 05 05:43:32 1996

08/05/96 05:43:32