

CITY OF ROCKWALL



CITY OF ROCKWALL
"THE NEW HORIZON"

ENGINEERING PLANS

FOR

SOUTHSIDE ELEVATED STORAGE TANK

JULY, 1996

CITY COUNCIL MEMBERS

ALMA K. WILLIAMS	MAYOR
GEORGE HATFIELD	PRO-TEM
DALE MORGAN	
BRUCE OPPERMANN	
JACK PAPPA	
NELL WELBORN	
TODD WHITE	

CITY MANAGER

JULIE COUCH

DIRECTOR OF COMMUNITY DEVELOPMENT

W.L. DOUPHRATE II, P.E.

PREPARED FOR:
CITY OF ROCKWALL
205 WEST RUSK
ROCKWALL, TEXAS 75087




Chiang, Patel and Associates, Inc.
Consulting Engineers • Planners • Project Managers
Dallas, Texas

No.	Date	Revisions	App.

RECORD DRAWING
PHILIP S. YERBY, P.E. #51735
CHIANG, PATEL & YERBY, INC.

CITY OF ROCKWALL
"THE NEW HORIZON"

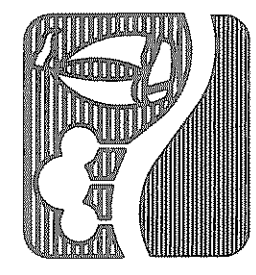

CITY OF ROCKWALL
SOUTHSIDE ELEVATED
STORAGE TANK
COVER SHEET

Scale: 1"=1'-0"	Date: JUL. 1996
Designed by: R. O'CONNELL	
Drawn by: R. TUNNELL	
Checked by: P. YERBY	
Approved by: F. RASOR	
Project No. CR0_9357.20	

THESE DOCUMENTS HAVE BEEN PREPARED BASED ON INFORMATION PROVIDED BY OTHERS. THE ACCURACY AND/OR COMPLETENESS OF THIS INFORMATION WAS VERIFIED BY THE CONTRACTOR.

I:\0609357\7-96\0357\5101 - Mon Aug 05 09:37:07 1996

02/25/96 8:57:50AM DWG