




N 7016377.23
E 2593010.98

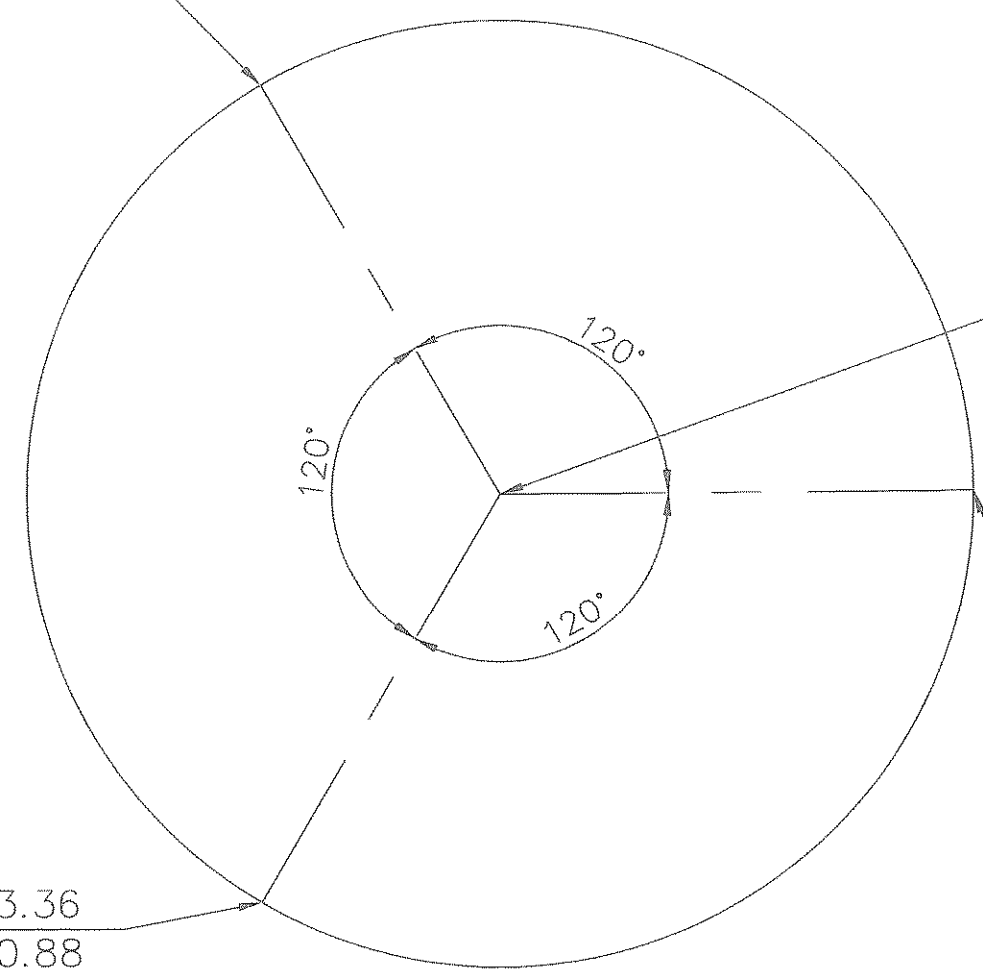


LOGO LOCATION PLAN

SCALE: N.T.S.
(TYP.)

GENERAL NOTE:

COLORS SHOWN WERE TAKEN FROM TNEDEC COLOR CHART. SUBMIT PROPOSED PAINT COLORS TO OWNER FOR APPROVAL PRIOR TO PAINTING LOGO ON TANK.

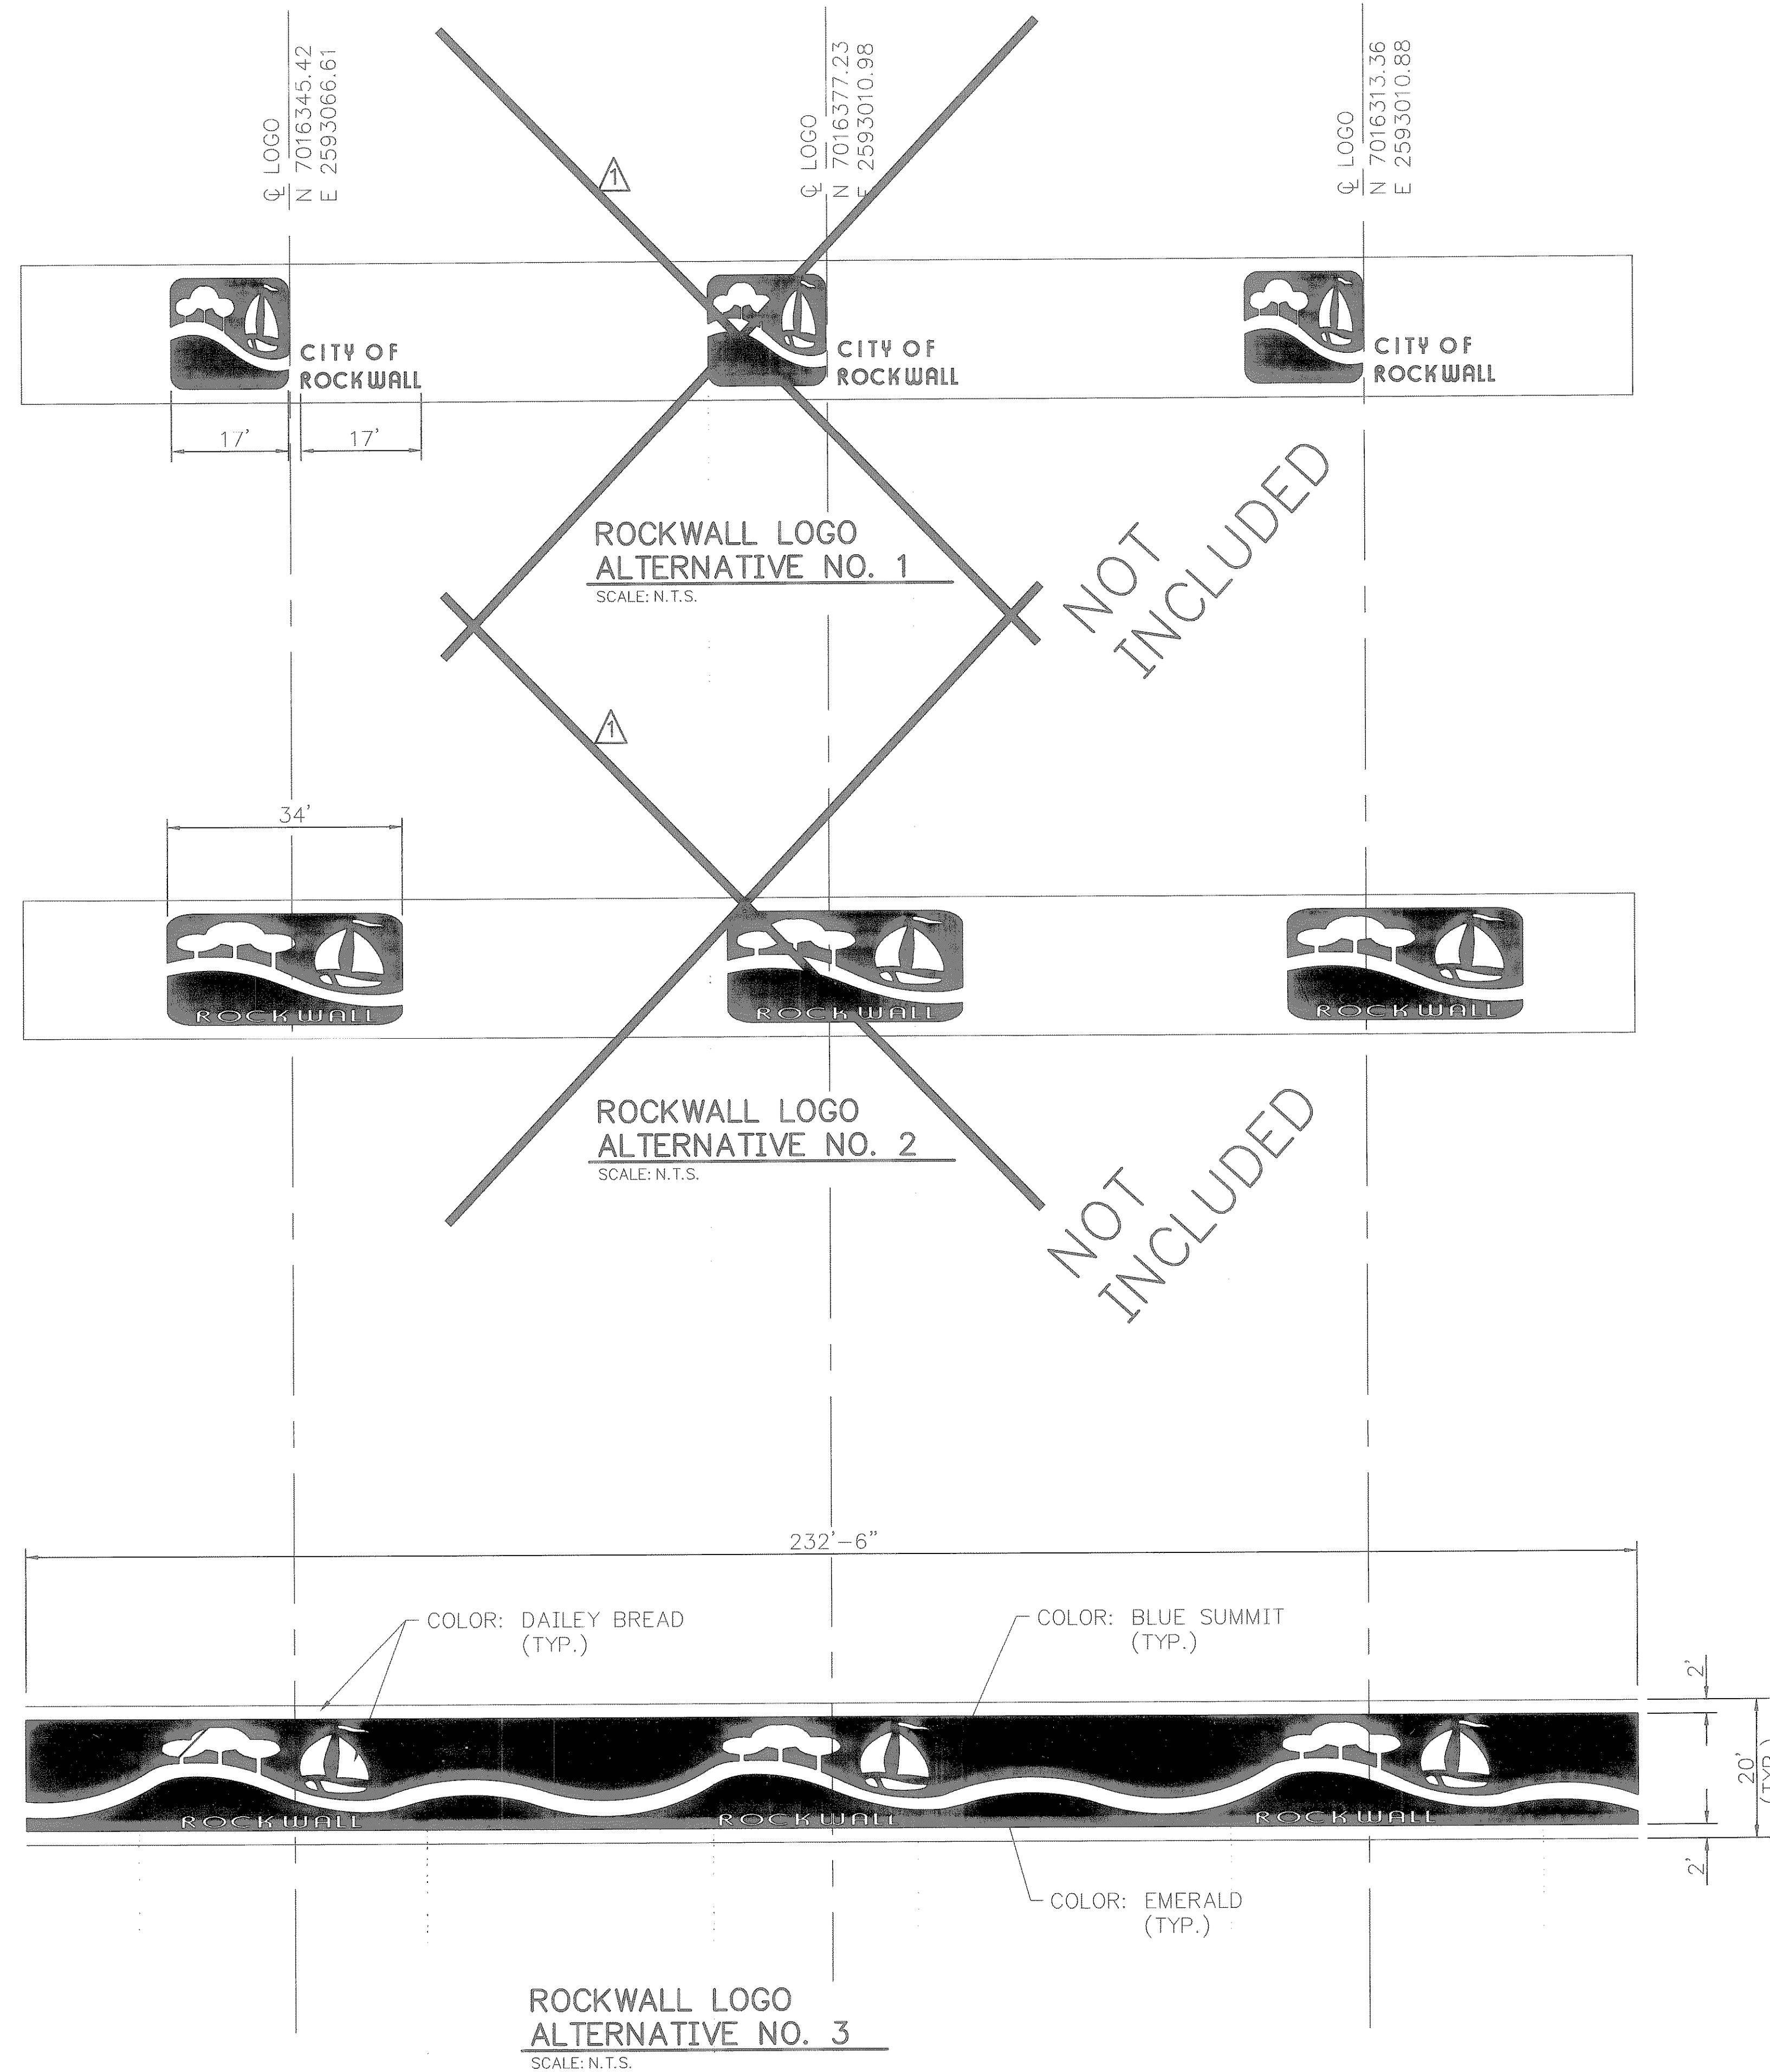

ROCKWALL LOGO ALTERNATIVE NO. 3

SCALE: N.T.S.

THESE DOCUMENTS HAVE BEEN PREPARED BASED ON INFORMATION PROVIDED BY OTHERS. THE ACCURACY AND/OR COMPLETENESS OF THIS INFORMATION WAS VERIFIED BY THE CONTRACTOR.

No.	Date	Revisions	App.

Chiang, Patel and Associates, Inc.
Consulting Engineers • Planners • Project Managers
Dallas, Texas

RECORD DRAWING
PHILIP S. YERBY, P.E. #51735
CHIANG, PATEL & YERBY, INC.

CITY OF ROCKWALL
"THE NEW HORIZON"

CITY OF ROCKWALL
SOUTHSIDE ELEVATED
STORAGE TANK
PAINTED LOGO ALTERNATIVES

Scale: AS NOTED Date: FEB. 1994
Designed by: R. O'CONNELL
Drawn by: T. GRANT
Checked by: P. YERBY
Approved by: F. RASOR
Project No. CRO 9357.20

I:\CRO9357-98\93575108 Mon Aug 05 08:44:56 1996

14892.R 8/25/98.DWG