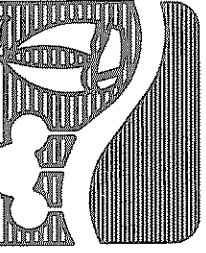


No.	Date	Revisions	PSY	App.
1	3-3-94			

Chiang, Patel and Associates, Inc.
 Consulting Engineers • Planners • Project Managers
 Dallas, Texas



RECORD DRAWING
 PHILIP S. YERBY, P.E. #51735
 CHIANG, PATEL & YERBY, INC.

CITY OF ROCKWALL
 "THE NEW HORIZON"


CITY OF ROCKWALL
 SOUTHSIDE ELEVATED
 STORAGE TANK
SITE PLAN

Scale: 1" = 20'-0"
 Date: FEB, 1994
 Designed by: R. O'CONNELL
 Drawn by: R. TUNNELL
 Checked by: P. YERBY
 Approved by: F. RASOR
 Project No.: CRO 9357.20

SHEET
3
 OF 14

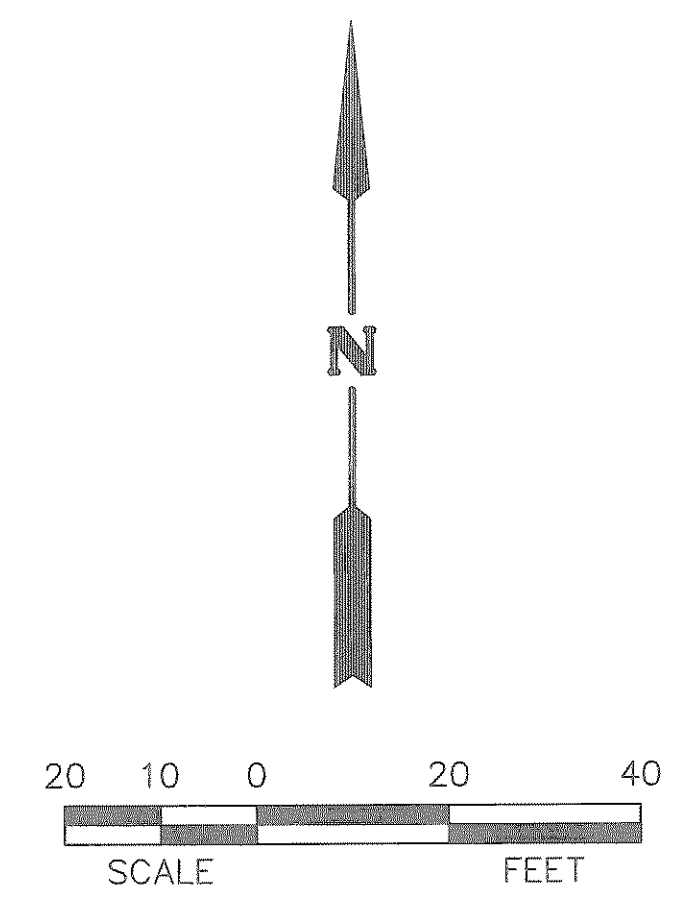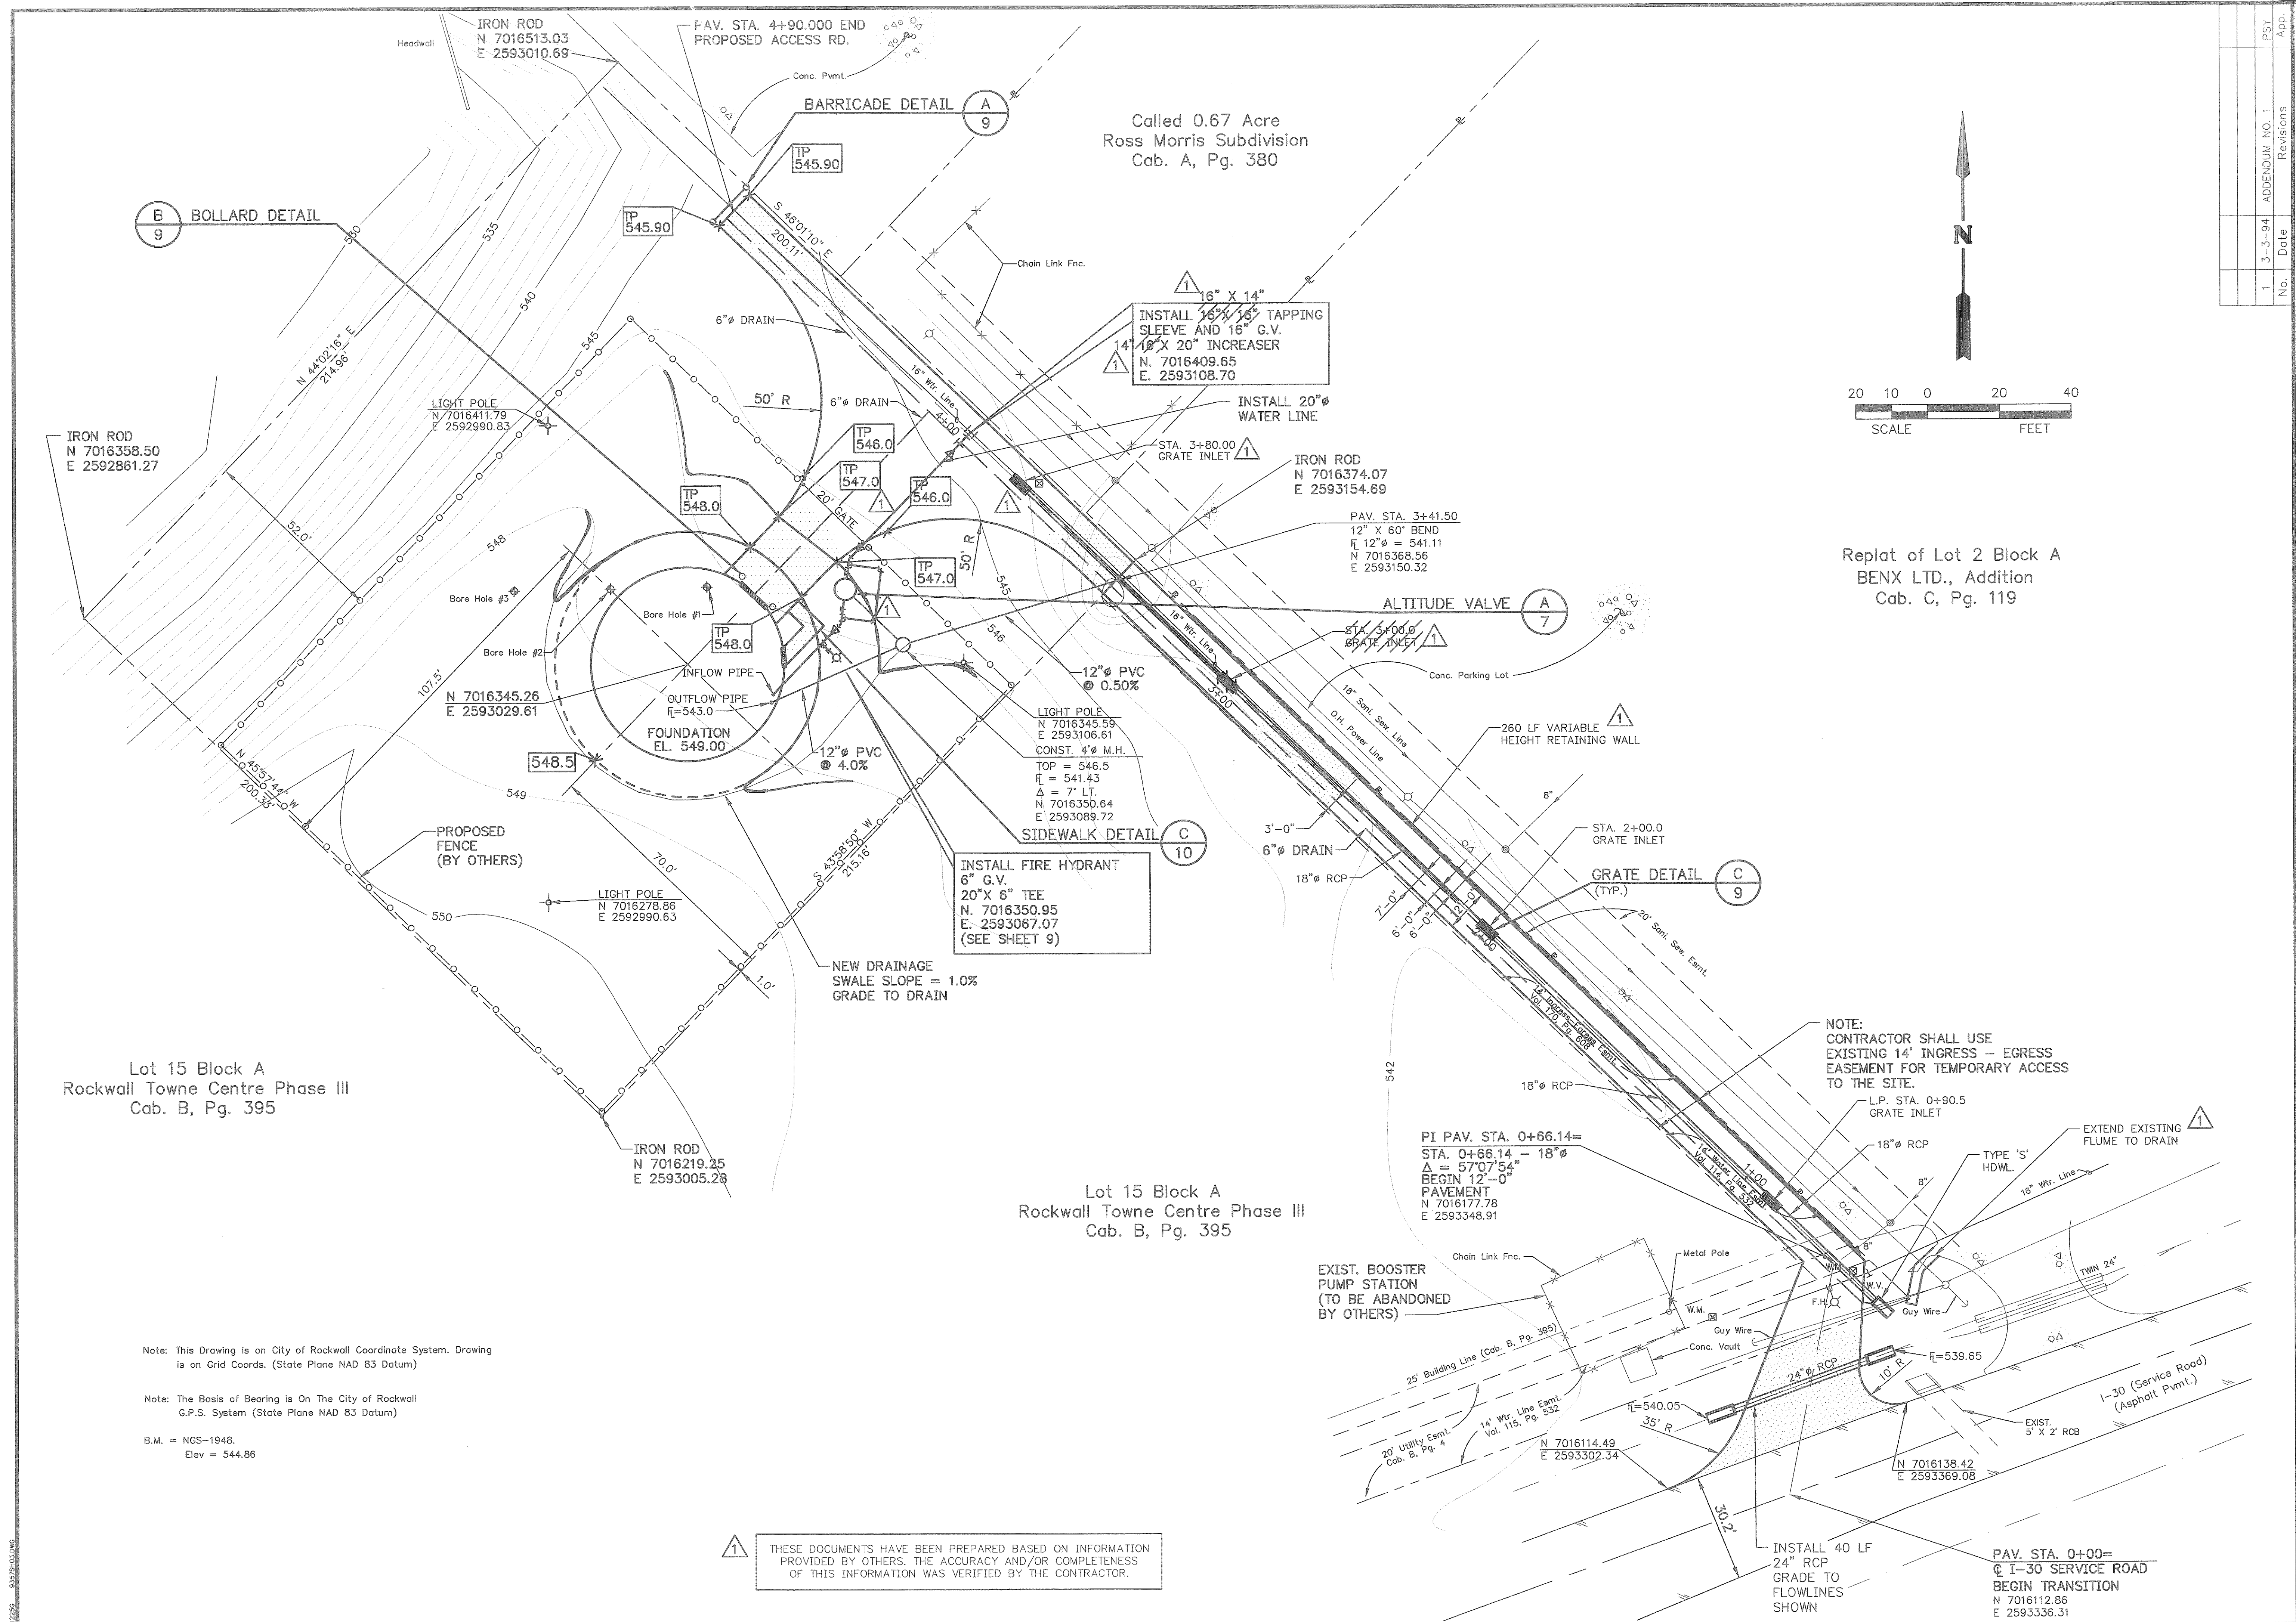

Replot of Lot 2 Block A
 BENX LTD., Addition
 Cab. C, Pg. 119

Lot 15 Block A
 Rockwall Towne Centre Phase III
 Cab. B, Pg. 395

Lot 15 Block A
 Rockwall Towne Centre Phase III
 Cab. B, Pg. 395

Note: This Drawing is on City of Rockwall Coordinate System. Drawing is on Grid Coords. (State Plane NAD 83 Datum)

Note: The Basis of Bearing is On The City of Rockwall G.P.S. System (State Plane NAD 83 Datum)

B.M. = NGS-1948.
 Elev = 544.86

THESE DOCUMENTS HAVE BEEN PREPARED BASED ON INFORMATION PROVIDED BY OTHERS. THE ACCURACY AND/OR COMPLETENESS OF THIS INFORMATION WAS VERIFIED BY THE CONTRACTOR.

NOTE:
 CONTRACTOR SHALL USE EXISTING 14' INGRESS - EGRESS EASEMENT FOR TEMPORARY ACCESS TO THE SITE.

EXIST. BOOSTER PUMP STATION (TO BE ABANDONED BY OTHERS)

PAV. STA. 0+00=
 @ I-30 SERVICE ROAD
 BEGIN TRANSITION
 N 7016112.86
 E 2593336.31

I:\CRO\9357\17-96\193575\403 Mon Aug 05 08:24:36 1996