




A BARRICADE DETAIL
SCALE: NTS

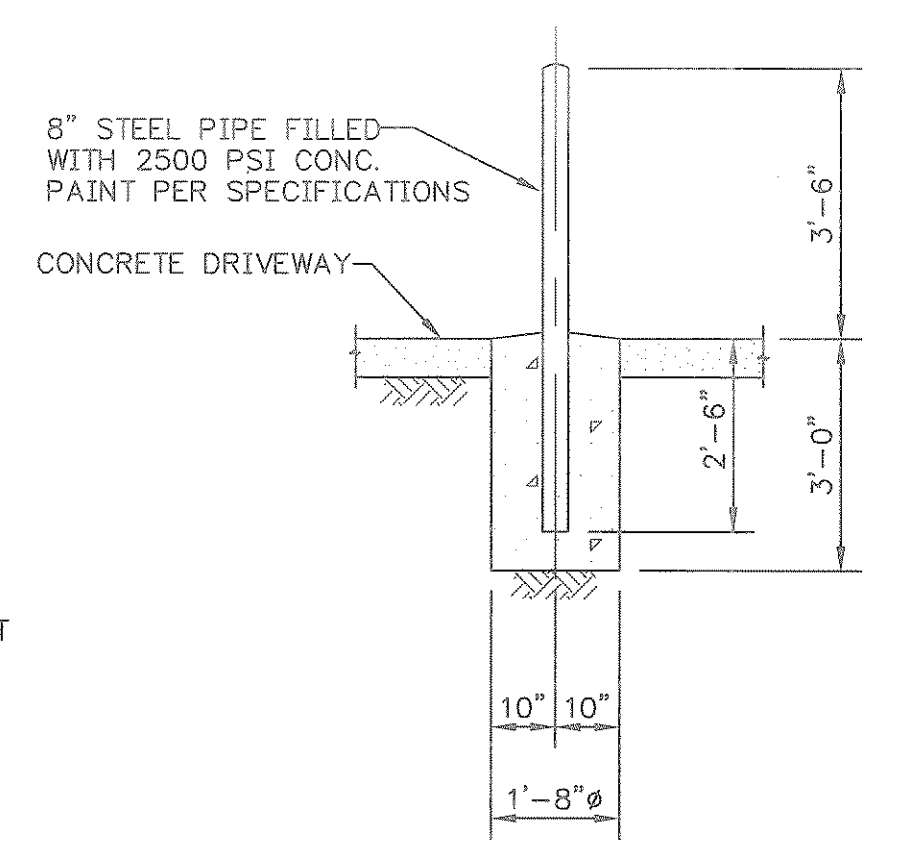


B BOLLARD DETAIL
SCALE: NTS

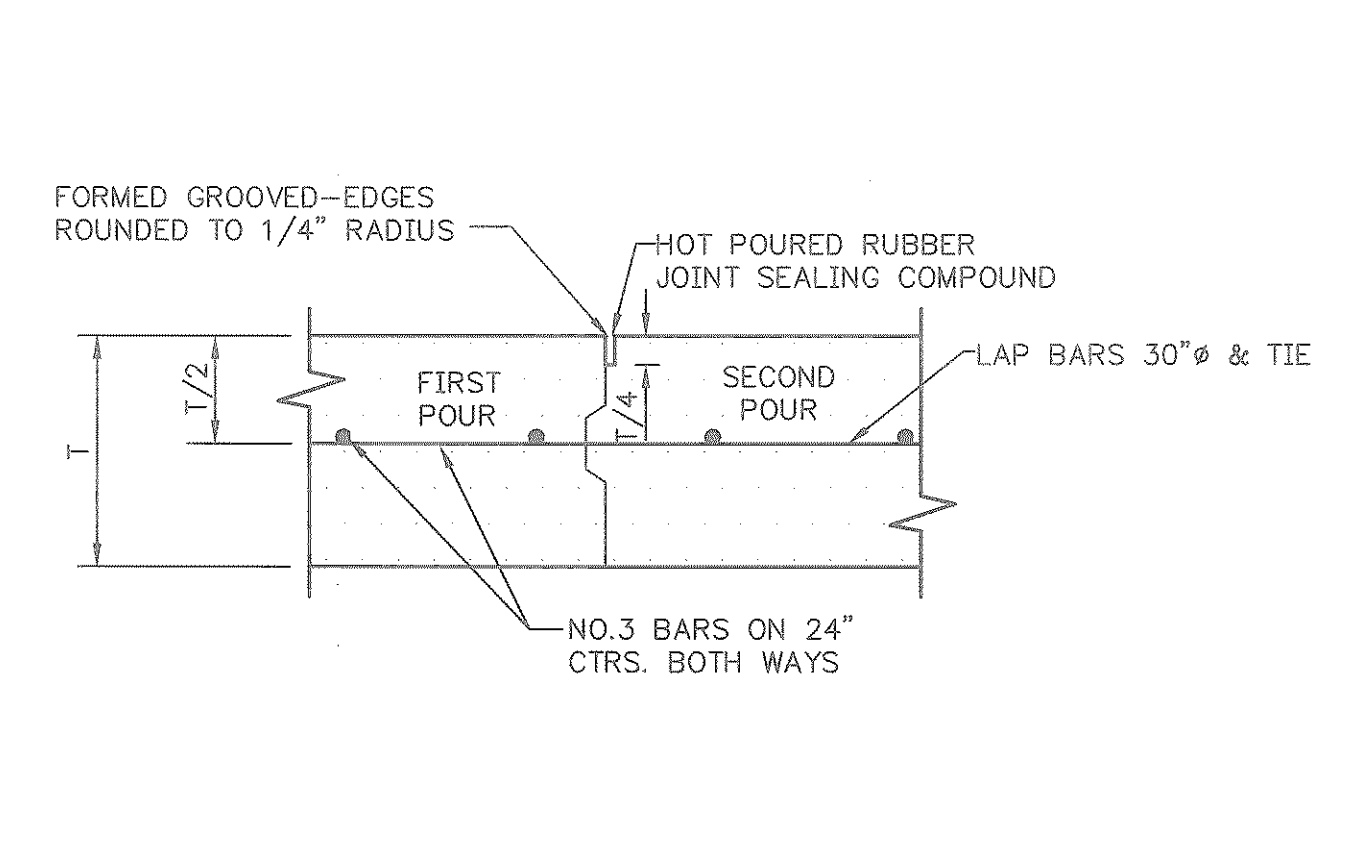


CONSTRUCTION JOINT
SCALE: NTS

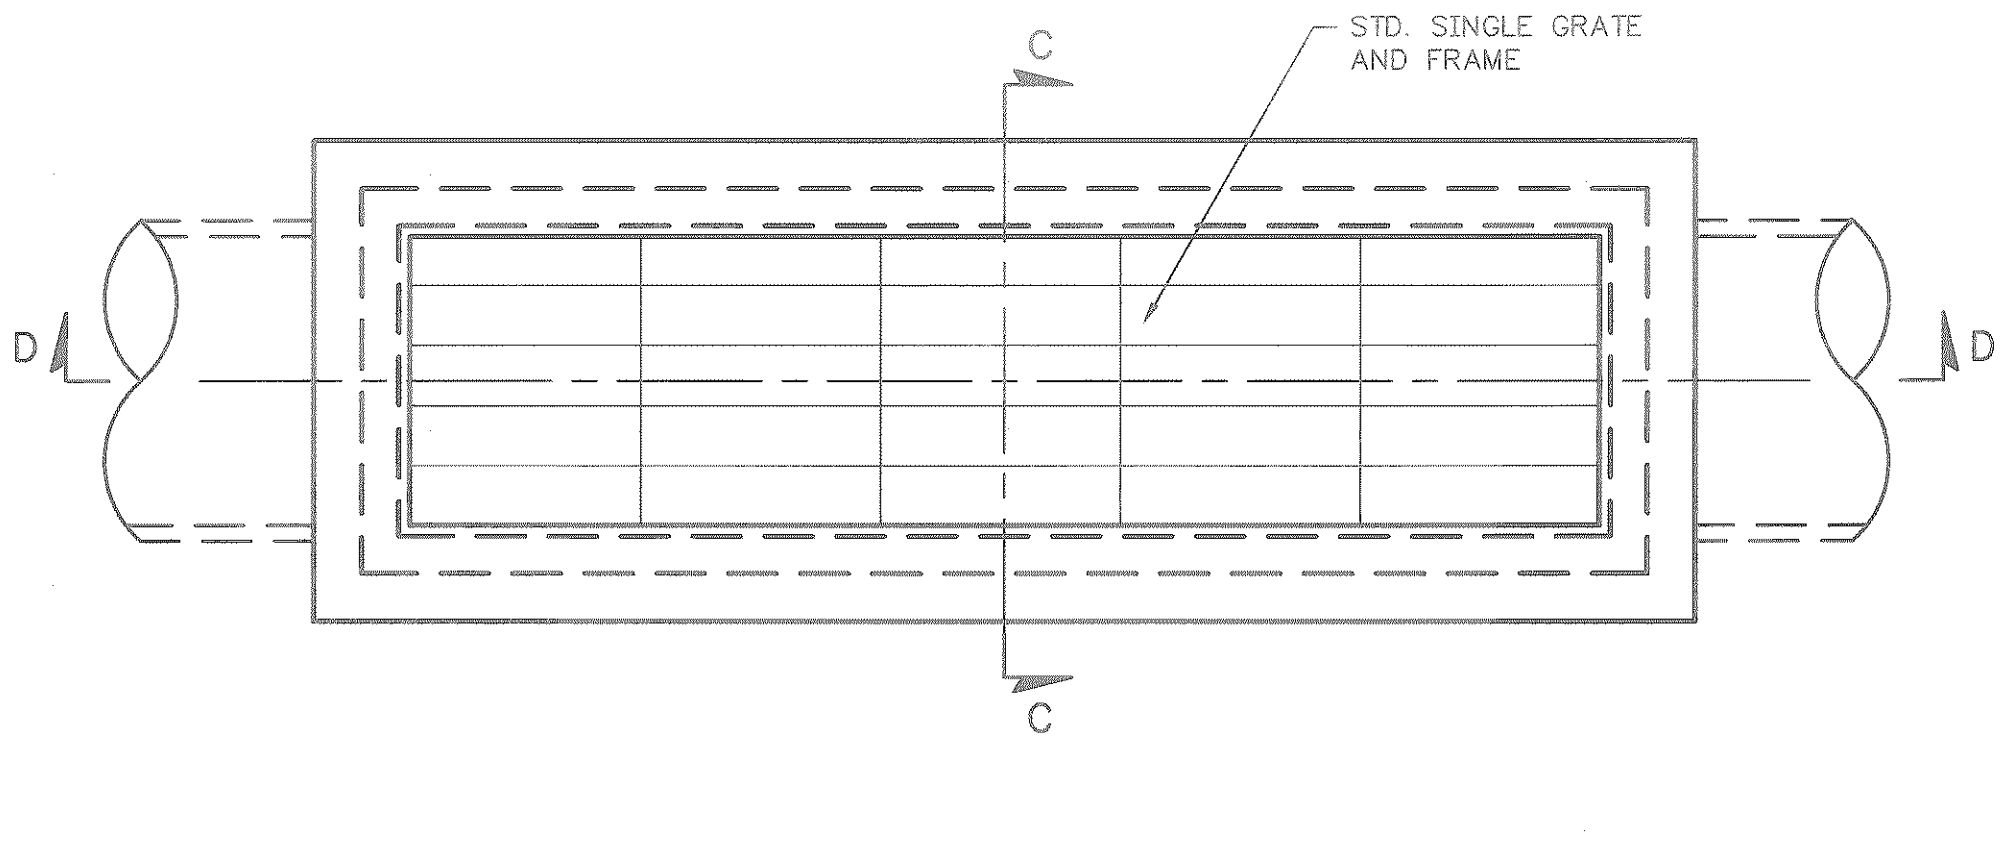


C GRATE INLET
SCALE: NTS

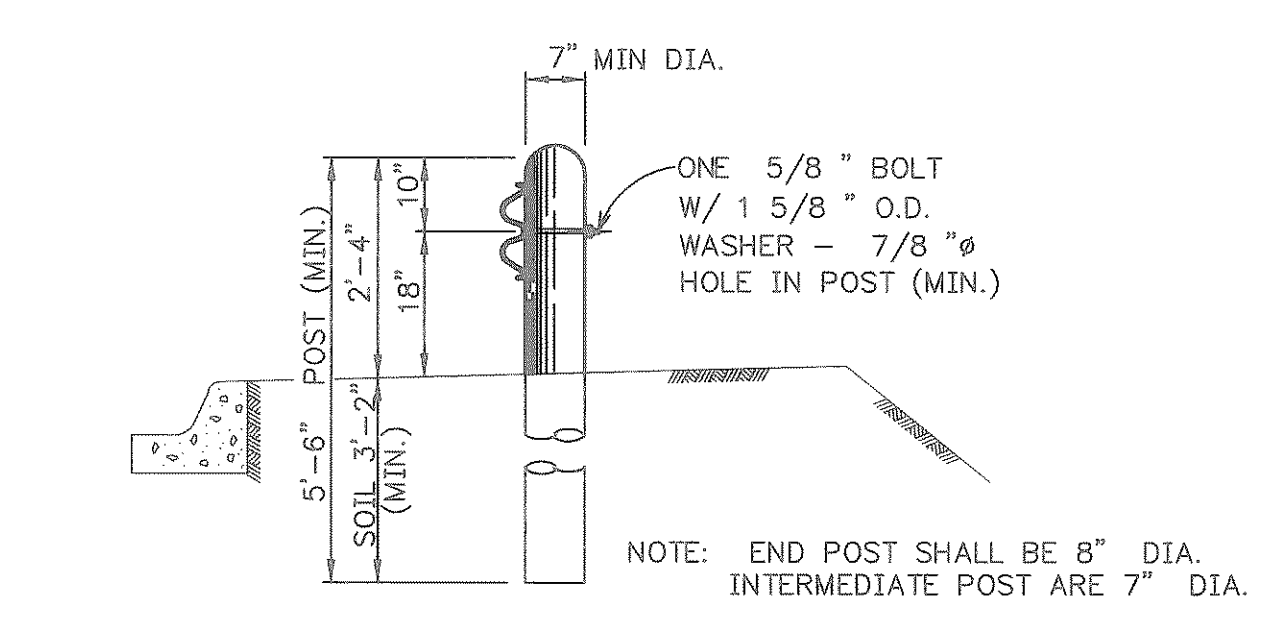


POST SECTION
SCALE: NTS

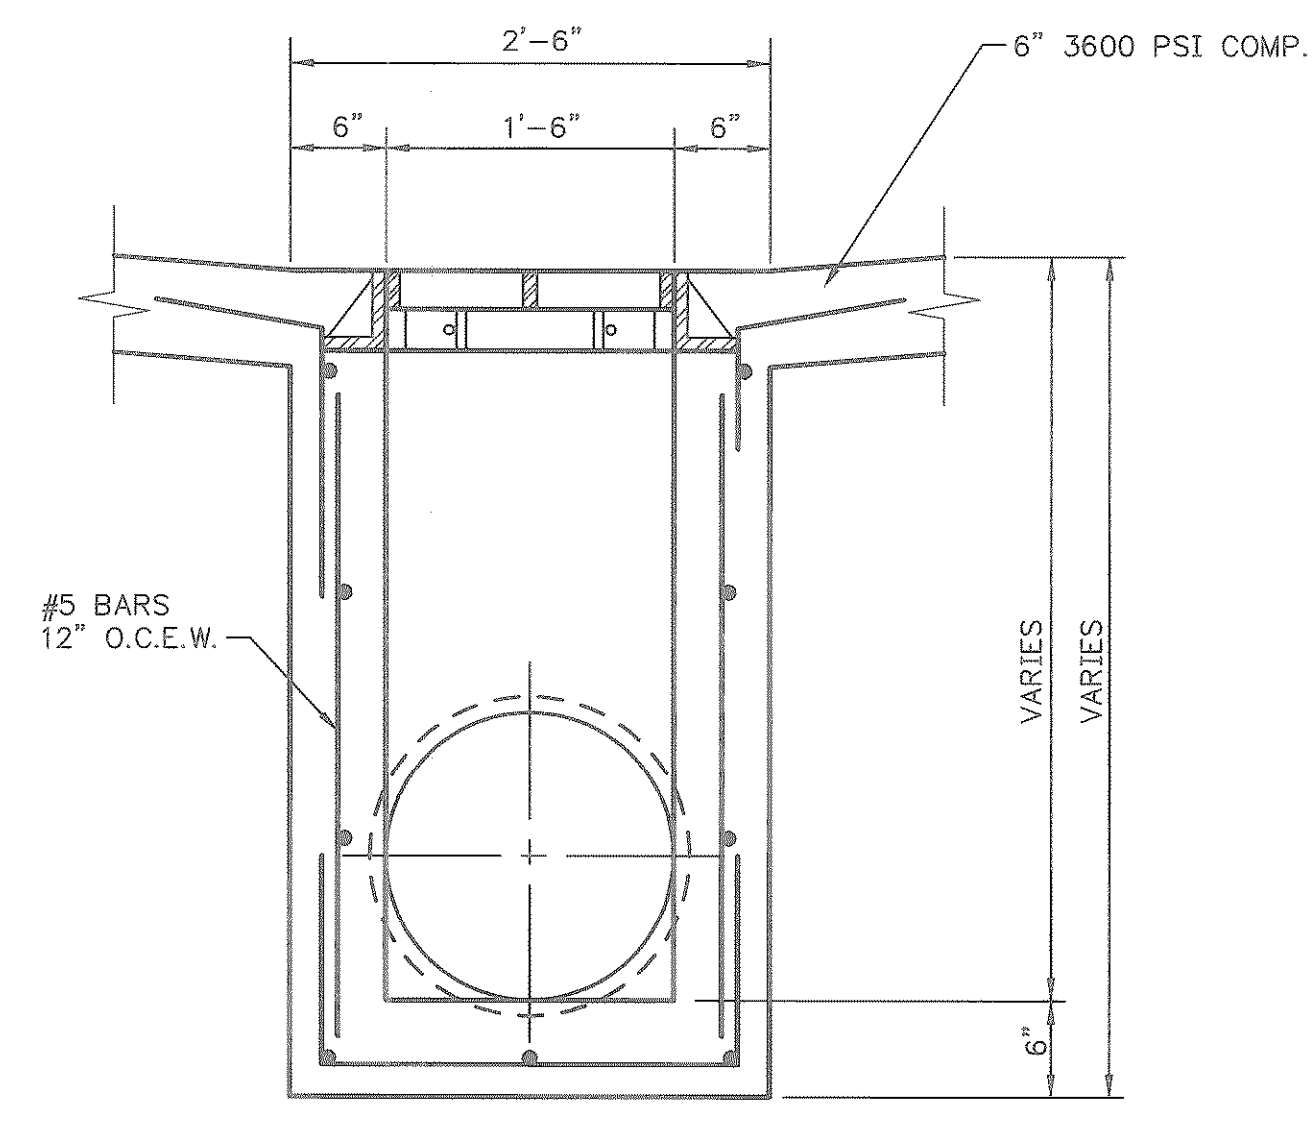


SECTION C-C
SCALE: NTS

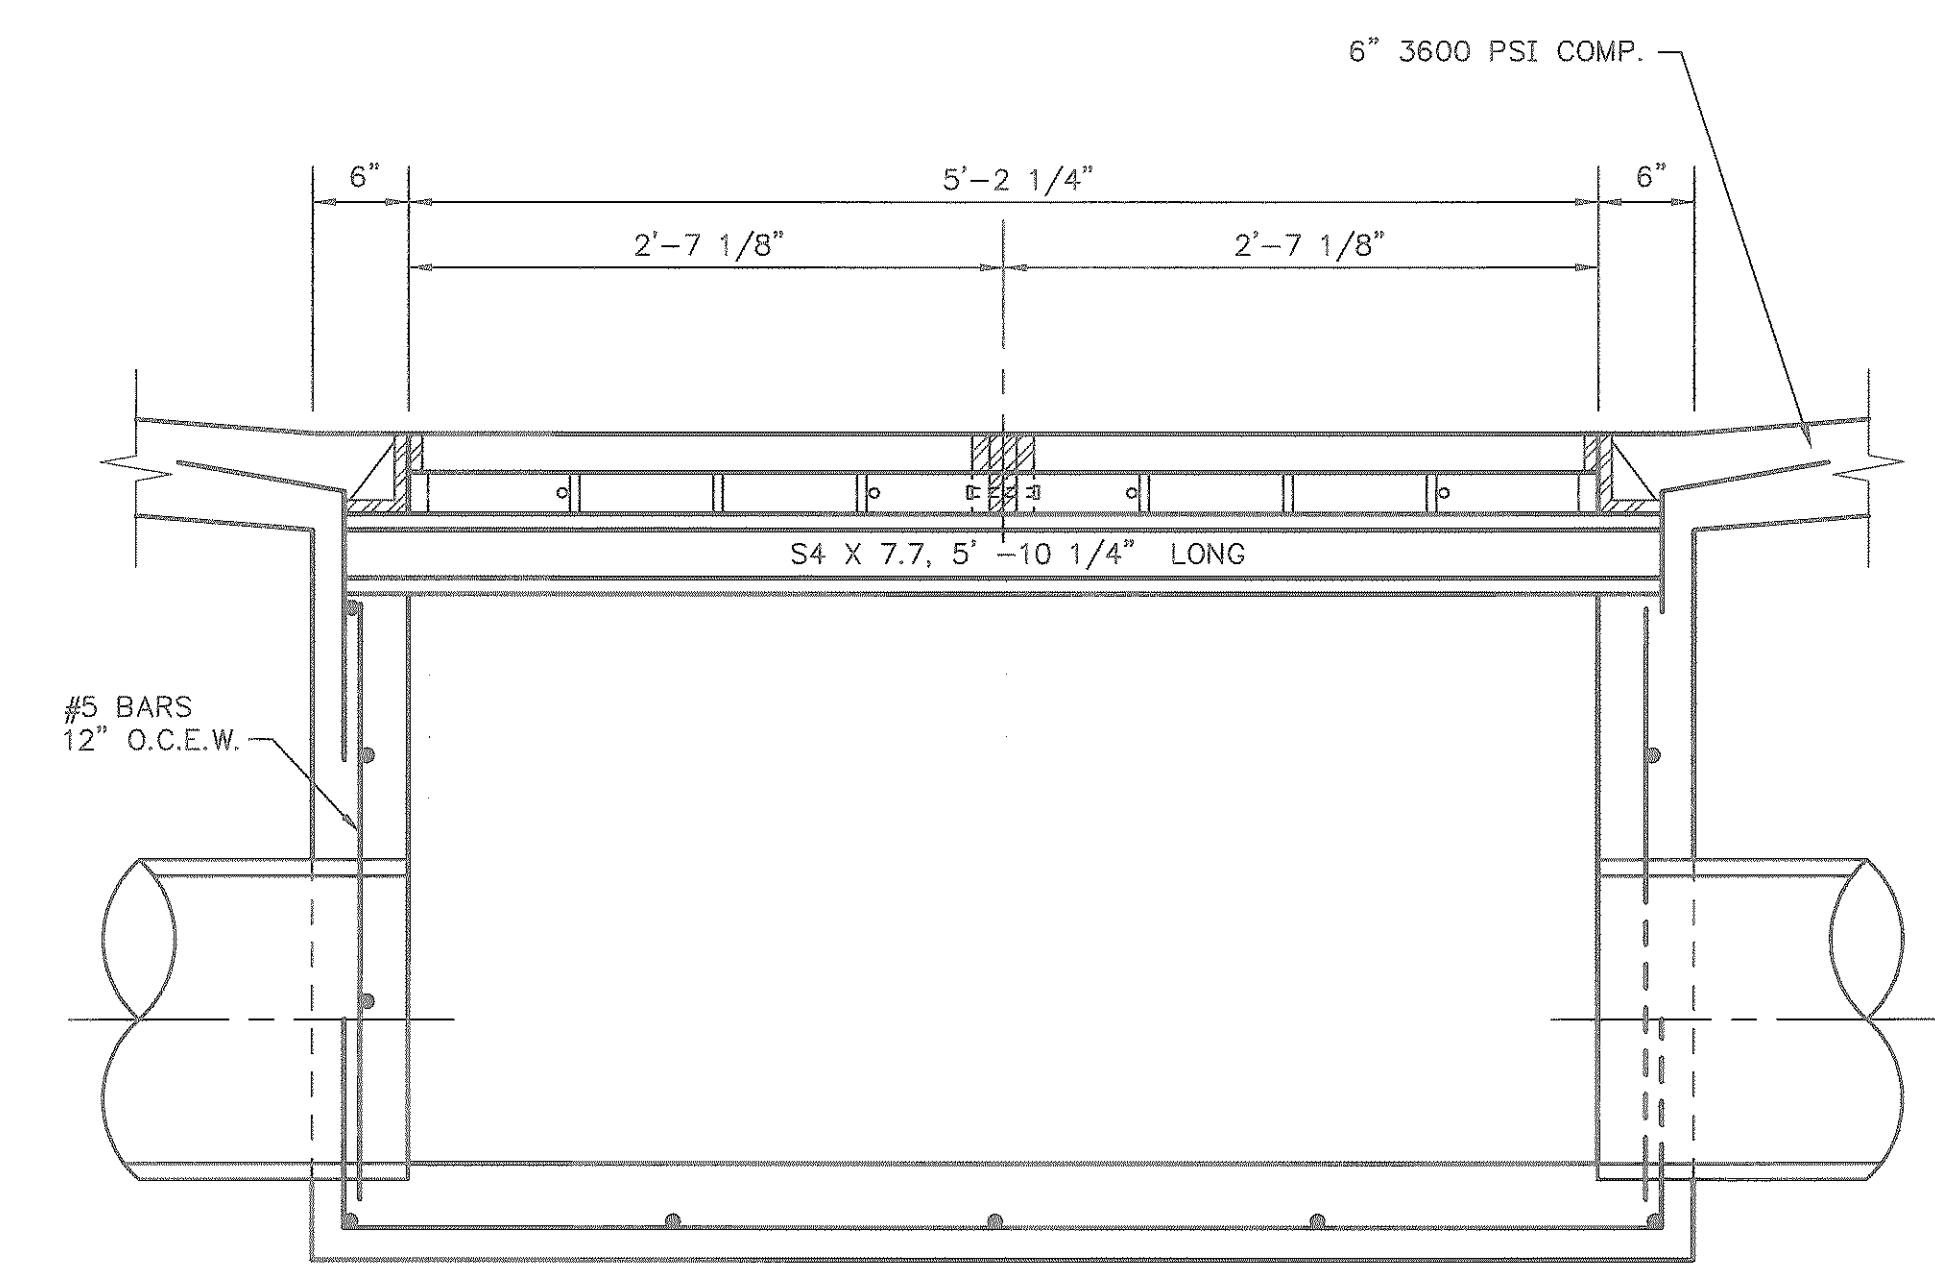


SECTION D-D
SCALE: NTS

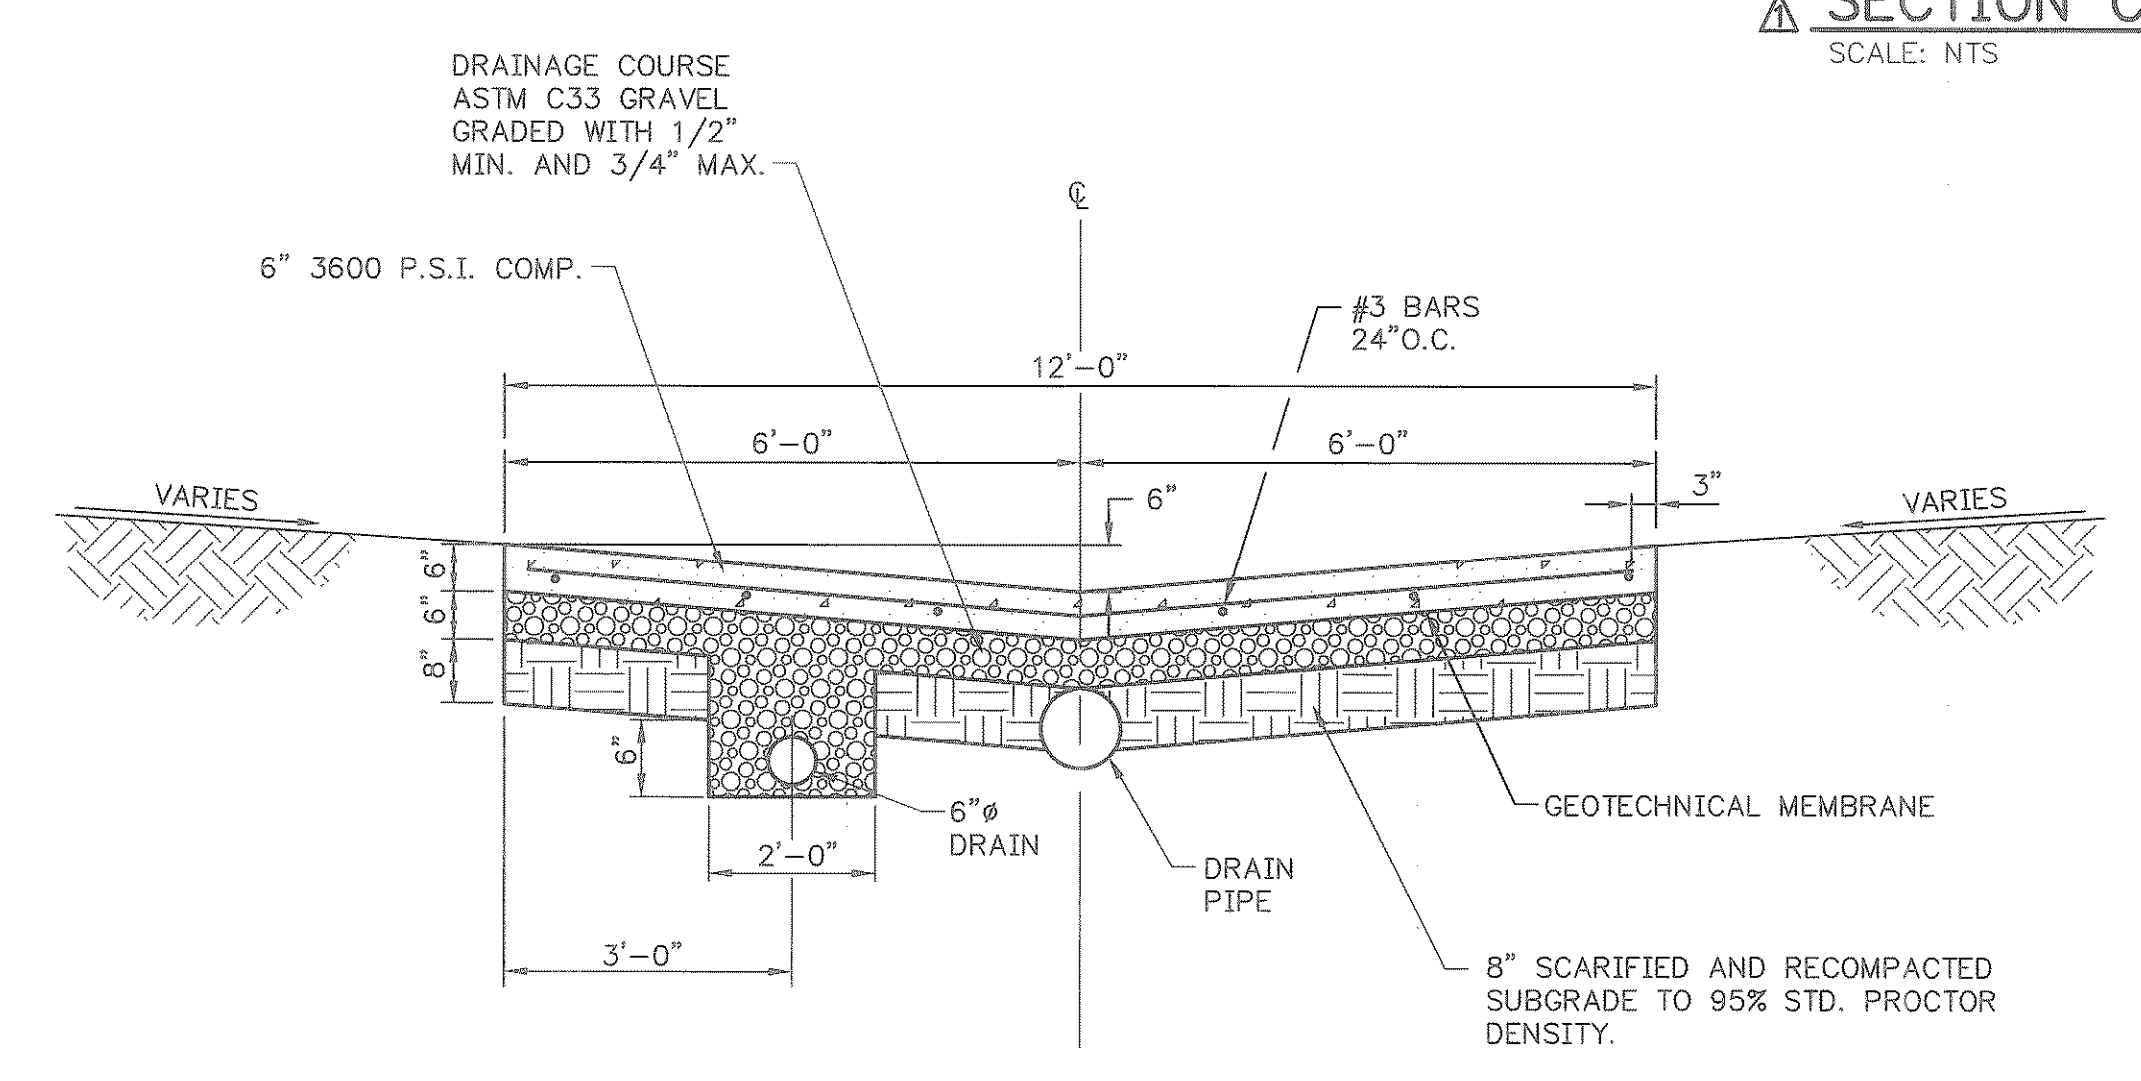

PAVING SECTION
SCALE: 1/2" = 1'-0"

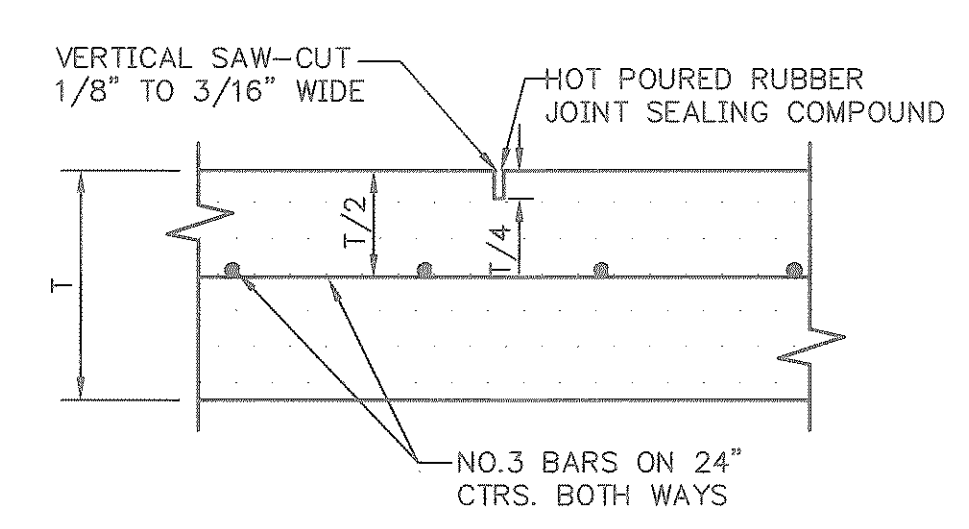

SAWED DUMMY JOINT
SCALE: NTS

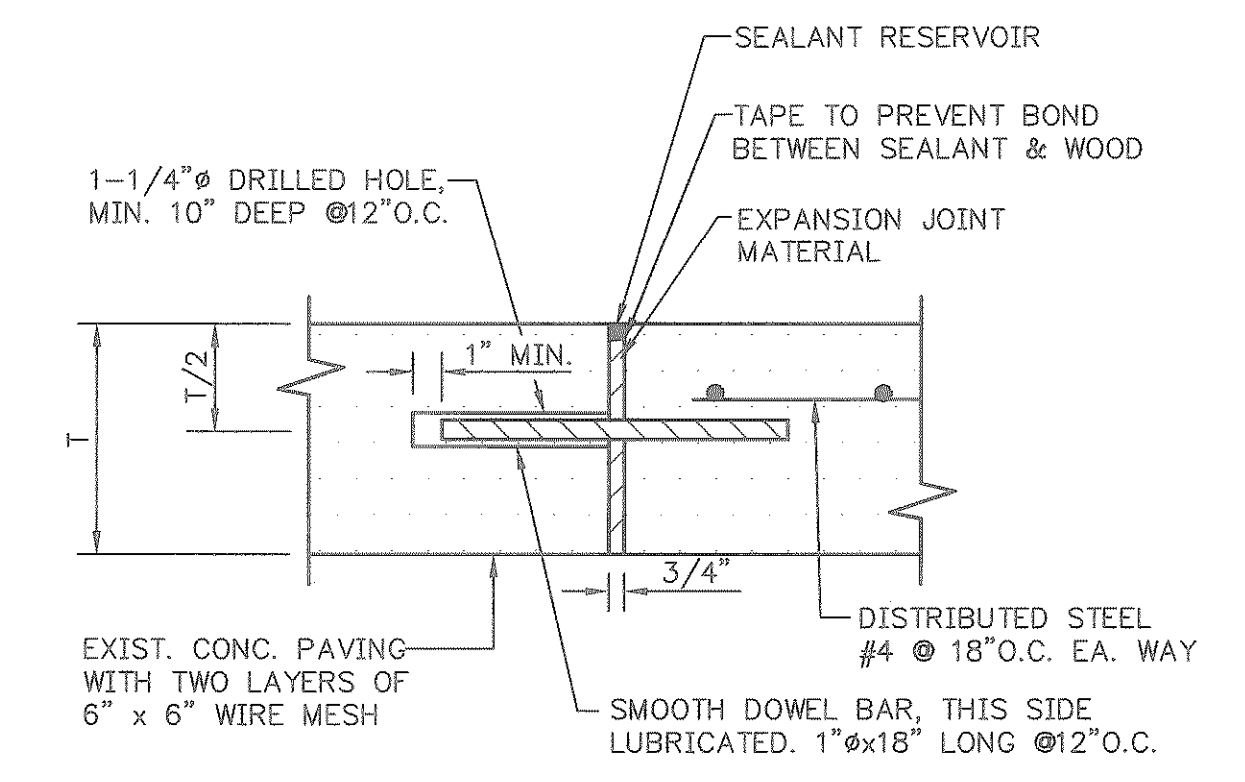

TRANSVERSE EXPANSION JOINT
SCALE: NTS

THESE DOCUMENTS HAVE BEEN PREPARED BASED ON INFORMATION PROVIDED BY OTHERS. THE ACCURACY AND/OR COMPLETENESS OF THIS INFORMATION WAS VERIFIED BY THE CONTRACTOR.

No.	Date	Revisions	App.

Chiang, Patel and Associates, Inc.
Consulting Engineers & Planners • Project Managers
Dallas, Texas

RECORD DRAWING
PHILIP S. YEBBY, P.E. #61735
CHIANG, PATEL & YEBBY, INC.

CITY OF ROCKWALL
"THE NEW HORIZON"

CITY OF ROCKWALL
SOUTHSIDE ELEVATED
STORAGE TANK
STANDARD DETAILS I

Scale: AS NOTED Date: FEB. 1994
Designed by: R. O'CONNELL
Drawn by: R. TUNNELL
Checked by: F. RASOR
Approved by: F. RASOR
Project No. CRO 9357.20

SHEET
9
OF 14