

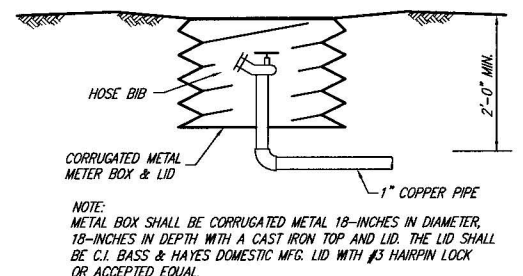



TYPICAL FIRE HYDRANT INSTALLATION
NO SCALE

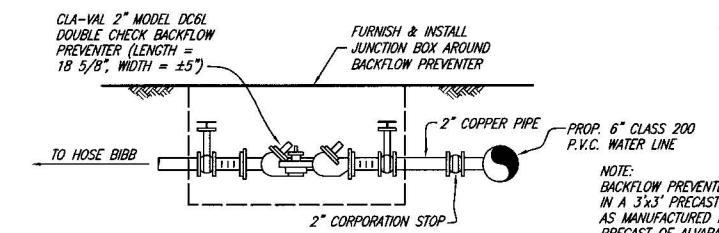

HOSE BIB & BOX
NO SCALE

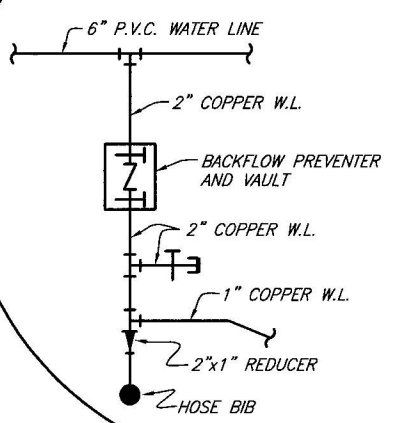


BACKFLOW PREVENTER ASSEMBLY
NO SCALE

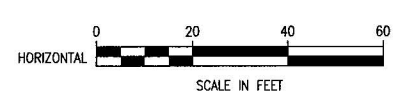

This record drawing is a compilation of the sealed engineering drawing for this project; modified by addenda, change orders and information furnished by the contractor. The information shown on the record drawings that was provided by the contractor or others not associated with the design engineer cannot be verified for accuracy or completeness. This original sealed drawings are on file at the offices of Birkhoff, Hendricks & Conway, L.L.P.
BY P.A.C. DATE 1/18/07

THESE DOCUMENTS ARE FOR BIDDING, CONSTRUCTION, AND PERMIT PURPOSES.
DATE: 5/10/02

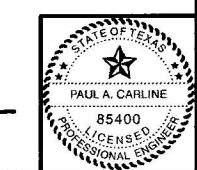

CITY OF ROCKWALL, TEXAS
SPRINGER ROAD ELEVATED STORAGE TANK
YARD PIPING PLAN

BIRKHOFF, HENDRICKS & CONWAY, L.L.P.
CONSULTING ENGINEERS
Dallas, Texas

DESIGNED BY: P.A.C. PROJECT: 2001180 SHEET NO. 2
DRAWN BY: B. H. & C. DATE: MAY, 2002 OF 15 SHEETS

h:\Projects\Rockwall\2001180\Sheets\2001180-02.dwg 01/18/07 GAD