


# CITY OF ROCKWALL, TEXAS

CONSTRUCTION PLANS FOR:

## SPRINGER ROAD 2.0 M.G. COMPOSITE ELEVATED STORAGE TANK

### 780 SERVICE AREA

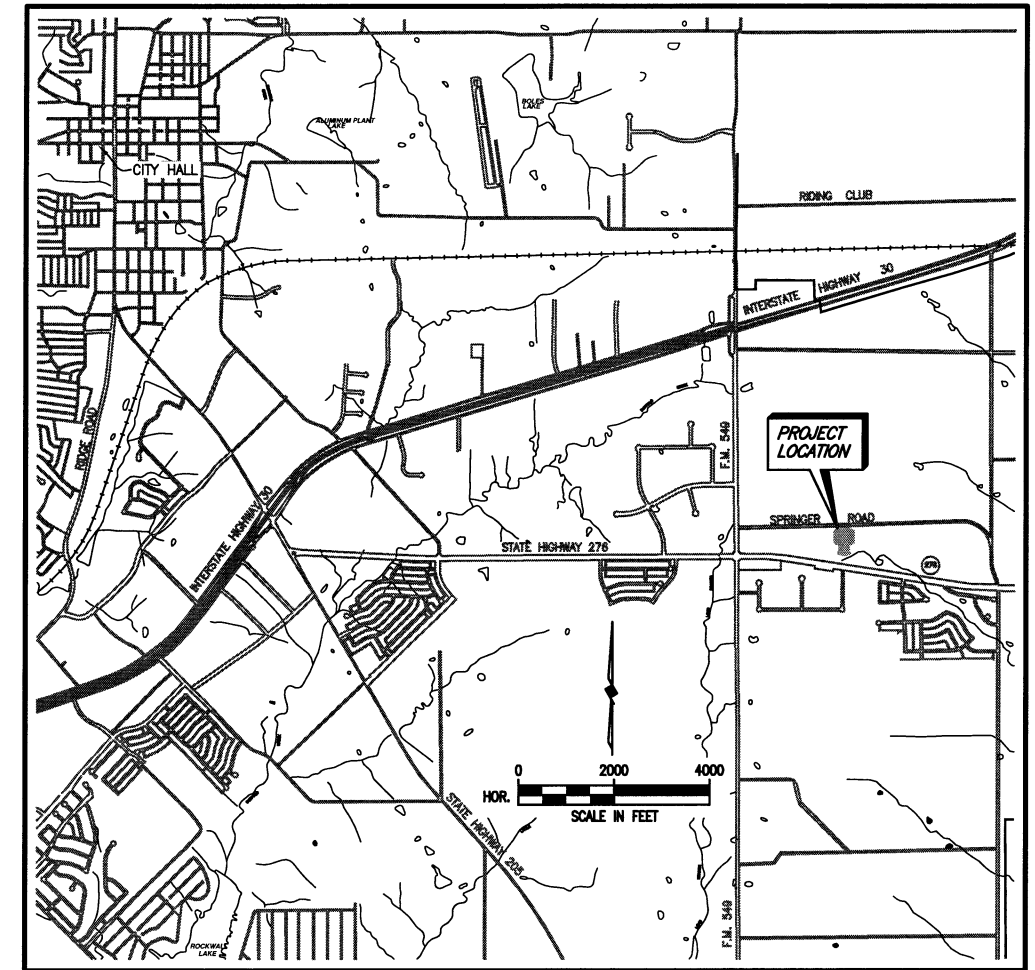


**LOCATION MAP**

**SHEET INDEX**

<u>SHEET NO.</u>	<u>SHEET DESCRIPTION</u>
—	COVER SHEET & LOCATION MAP
1	SITE PLAN, PAVING PLAN & BORING LOCATIONS
2	YARD PIPING PLAN
3	GRADING PLAN, WATER LINE PROFILE
4	FLOOR PLANS
5	STAIR & ELEVATOR DETAILS
6	TANK SECTIONS & DETAILS
7	TANK ELEVATION & DETAILS
8	LOG OF BORINGS & GENERAL NOTES
9-10	MISCELLANEOUS DETAILS
E1	ELECTRICAL SITE PLAN
E2	ELECTRICAL FLOOR PLANS & DETAILS
E3	TANK ELEVATION & ELECTRICAL DETAILS
E4	ELECTRICAL DETAILS
E5	ELECTRICAL SCHEMATICS


*This record drawing is a compilation of the sealed engineering drawing for this project; modified by addenda, change orders and information furnished by the contractor. The information shown on the record drawings that was provided by the contractor or others not associated with the design engineer cannot be verified for accuracy or completeness. This original sealed drawings are on file at the offices of Birkhoff, Hendricks & Conway, L.L.P.*  
 BY P.A.C. DATE 1/18/07

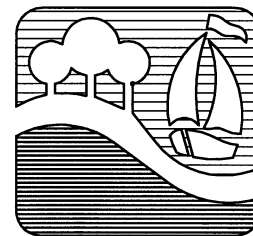

**BIRKHOFF, HENDRICKS & CONWAY, L.L.P.**  
 CONSULTING ENGINEERS  
 Dallas, Texas

MAY, 2002

THESE DOCUMENTS ARE FOR  
 BIDDING, CONSTRUCTION  
 AND PERMIT PURPOSES.  
 DATE: 5/20/02

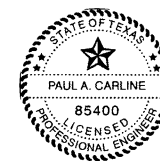

COUNCIL MEMBERS

- KEN JONES, MAYOR
- BILL CECIL, MAYOR PRO-TEM
- BOB COTTI
- JOHN KING
- BILLY MORRIS
- RON COLESON
- TERRY RAULSTON

CITY MANAGER

JULIE COUCH

ASSISTANT CITY MANAGER

RICHARD CROWLEY

CITY ENGINEER

CHUCK TODD, P.E.