


These plans and related specifications were prepared for construction of this specific project only. Reuse of these documents is not permitted without written authorization of Birkhoff, Hendricks & Conway, L.L.P.

REVISED TO CONFORM TO CONSTRUCTION RECORDS BY P.A.C. DATE 01/18/2005

FIELD CHANGE No. 1 REVISED WATER LINE ALIGNMENT 11/05/03

CITY OF ROCKWALL, TEXAS
 SPRINGER ROAD WATER LINE
 PLAN & PROFILE
 STA. 25+00 TO STA. 30+00
 BIRKHOFF, HENDRICKS & CONWAY, L.L.P.
 CONSULTING ENGINEERS
 Dallas, Texas

THESE DOCUMENTS ARE FOR BIDDING, CONSTRUCTION, AND PERMIT PURPOSES.
 DATE: 11/12/03

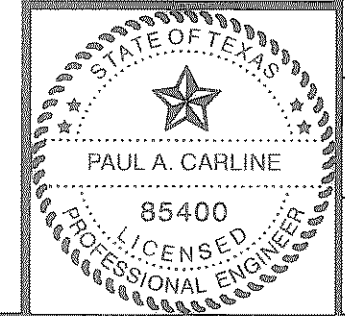

DESIGNED BY:	P.A.C.	PROJECT:	2001-178	SHEET NO.	6
DRAWN BY:	B.H.C.	DATE:	NOVEMBER, 2003	OF 10 SHEETS	

11/12/03 .jlc
 H:\Projects\Rockwall\2001178\Springer_Road\Streets\2001178-506.dwg
 FULL SCALE 1=20
 XREF: 01178swr-BASE, SPRINGER_PROF