

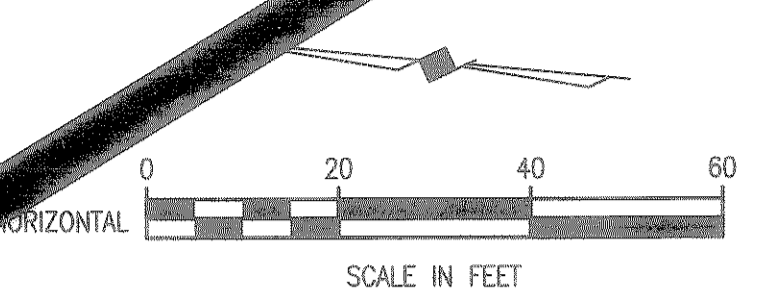


H:\Projects\Rockwall\2001178\Springer_Road\REV-071003\2001178-S09.dwg XREF: 01178swl-BASE_SPRINGER_PROF FULL SCALE 1=20 8/26/03 JLC

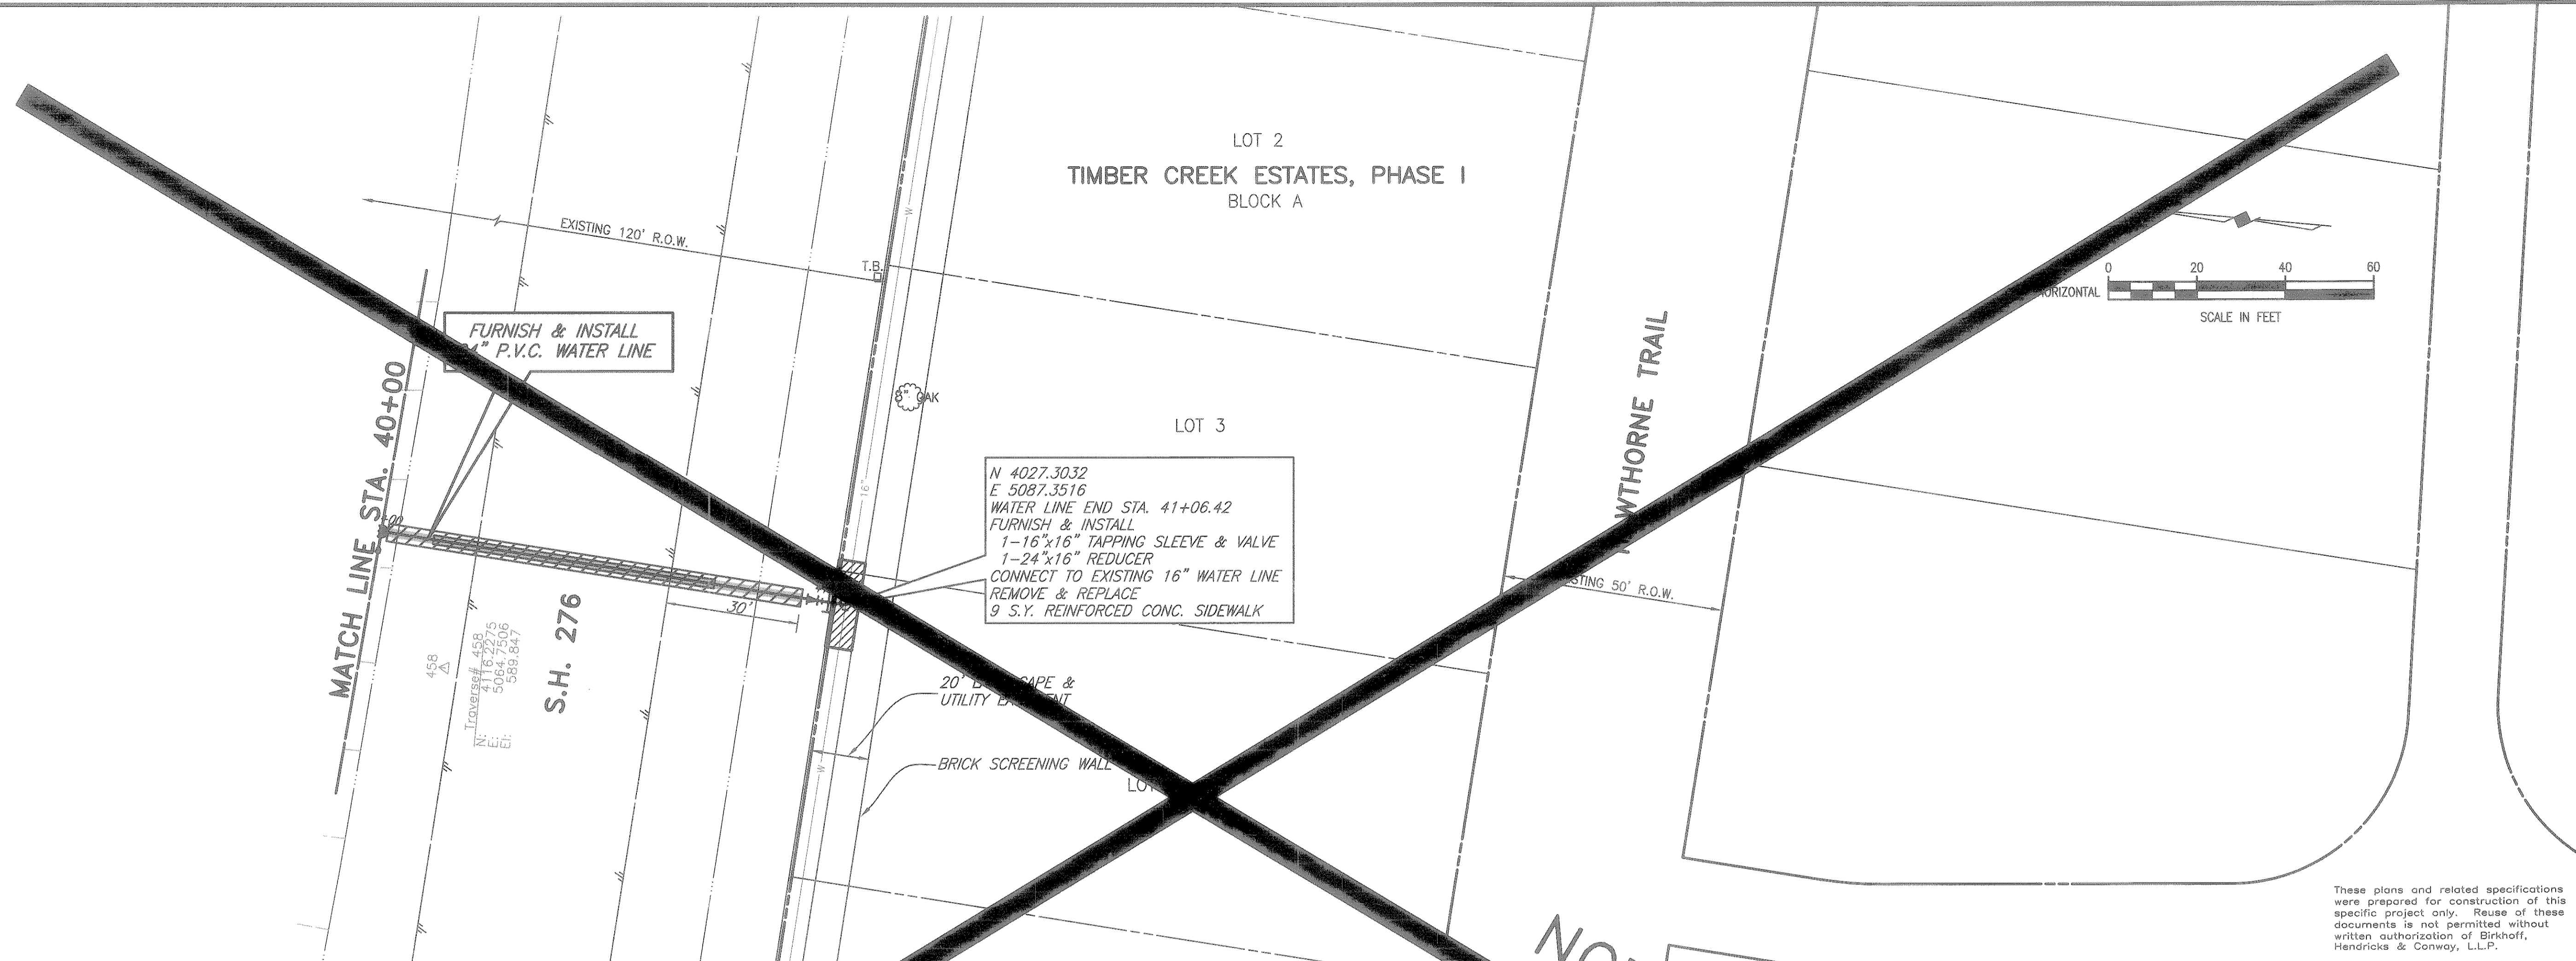

These plans and related specifications were prepared for construction of this specific project only. Reuse of these documents is not permitted without written authorization of Birkhoff, Hendricks & Conway, L.L.P.


NOT CONSTRUCTED

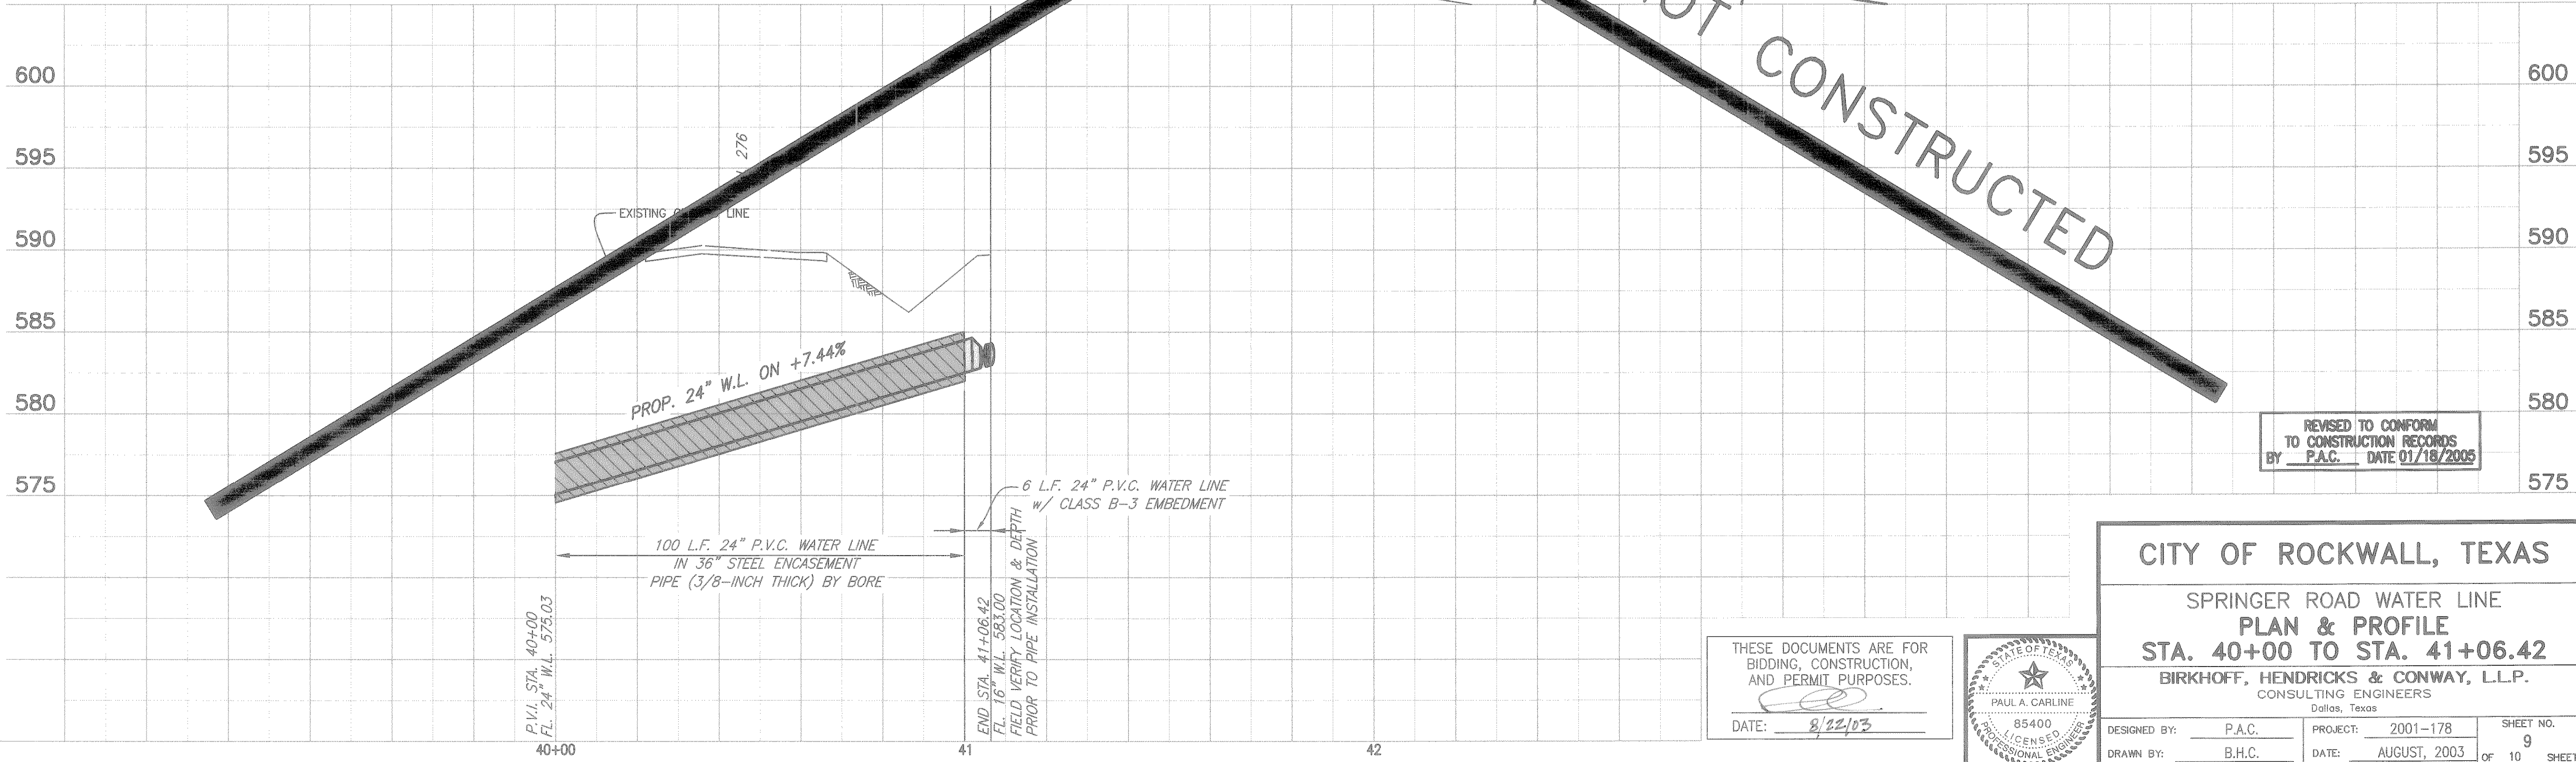

REVISED TO CONFORM TO CONSTRUCTION RECORDS BY P.A.C. DATE 01/18/2005

CITY OF ROCKWALL, TEXAS
SPRINGER ROAD WATER LINE
PLAN & PROFILE
STA. 40+00 TO STA. 41+06.42
BIRKHOFF, HENDRICKS & CONWAY, L.L.P.
CONSULTING ENGINEERS
Dallas, Texas

THESE DOCUMENTS ARE FOR BIDDING, CONSTRUCTION, AND PERMIT PURPOSES.
DATE: 8/22/03

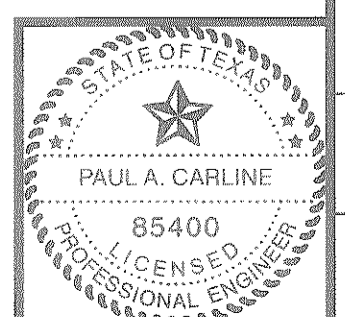

DESIGNED BY: P.A.C. PROJECT: 2001-178 SHEET NO. 9
DRAWN BY: B.H.C. DATE: AUGUST, 2003 OF 10 SHEETS