


CITY OF ROCKWALL, TEXAS

CONSTRUCTION PLANS FOR: SQUABBLE CREEK TO BUFFALO CREEK WASTEWATER TRANSFER SECTION III

SQUABBLE CREEK FORCE MAIN

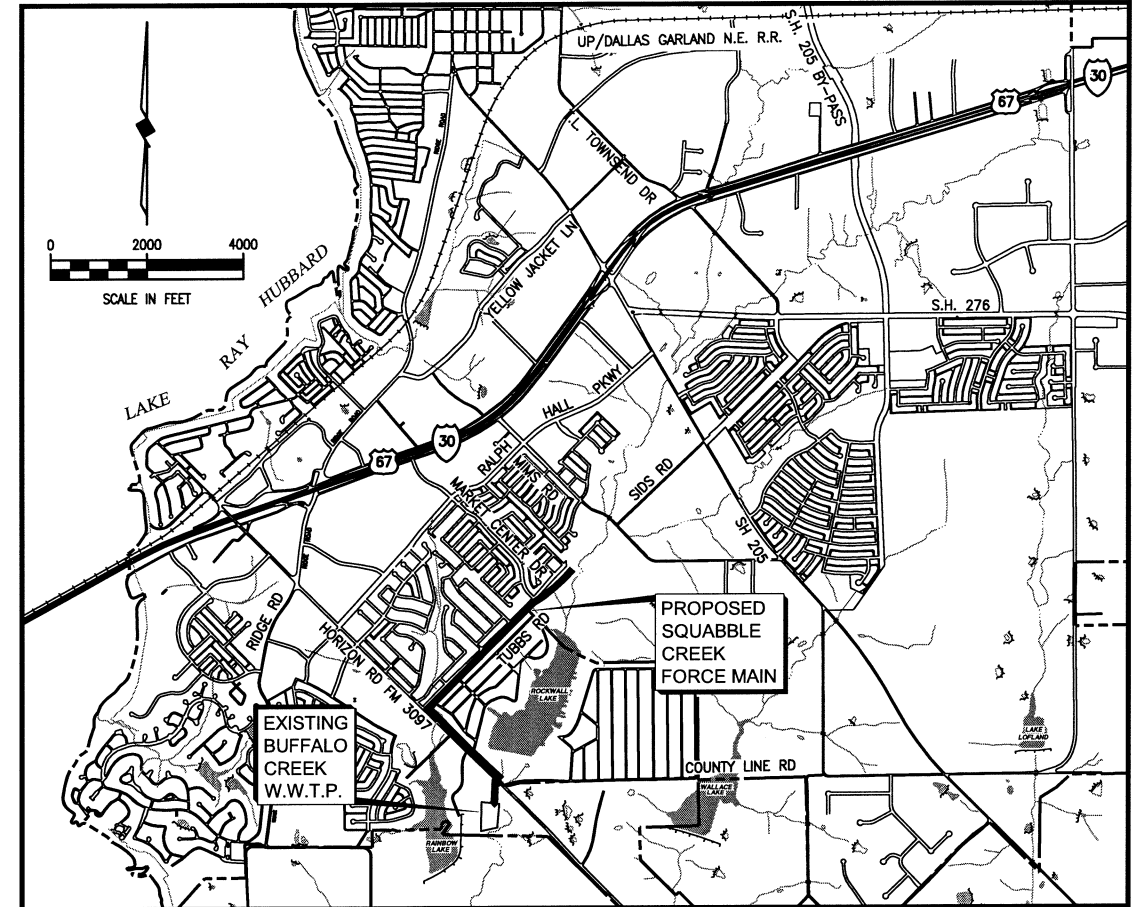

LOCATION MAP

COUNCIL MEMBERS

- BILL CECIL, MAYOR
- DAVID SWEET, MAYOR PRO-TEM
- MATT SCOTT
- CLIFF SEVIER
- GLEN FERRIS
- MARK RUSSO
- MARGO NIELSEN



CITY MANAGER

JULIE COUCH

ASSISTANT CITY MANAGER

RICHARD CROWLEY

CITY ENGINEER

CHUCK TODD, P.E.

BIRKHOFF, HENDRICKS & CARTER, L.L.P.

PROFESSIONAL ENGINEERS
Texas Firm 526
Dallas, Texas

April, 2010



[Handwritten Signature]
4/2/10

SHEET INDEX

SHEET NO.	SHEET DESCRIPTION
-	COVER SHEET AND LOCATION MAP
1	GENERAL NOTES
2	PLAN-PROFILE STA. - 0+58 TO STA. 5+00
3	PLAN-PROFILE STA. 5+00 TO STA. 10+00
4	PLAN-PROFILE STA. 10+00 TO STA. 15+00
5	PLAN-PROFILE STA. 15+00 TO STA. 20+00
6	PLAN-PROFILE STA. 20+00 TO STA. 25+50
7	PLAN-PROFILE STA. 25+50 TO STA.30+00
8	PLAN-PROFILE STA. 30+00 TO STA. 35+00
9	PLAN-PROFILE STA. 35+00 TO STA. 40+00
10	PLAN-PROFILE STA. 40+00 TO STA. 45+00
11	PLAN-PROFILE STA. 45+00 TO STA. 50+00
12	PLAN-PROFILE STA. 50+00 TO STA. 55+00
13	PLAN-PROFILE STA. 55+00 TO STA. 60+00
14	PLAN-PROFILE STA. 60+00 TO STA. 65+00
15	PLAN-PROFILE STA. 65+00 TO STA. 68+50
16	DETAILS
17	JUNCTION BOX DETAILS

This record drawing is a compilation of the sealed engineering drawing for this project; modified by addenda, change orders and information furnished by the contractor. The information shown on the record drawings that was provided by the contractor or others not associated with the design engineer cannot be verified for accuracy or completeness. This original sealed drawings are on file at the offices of Birkhoff, Hendricks & Carter, L.L.P.
BY PAC DATE 06/13/2011