
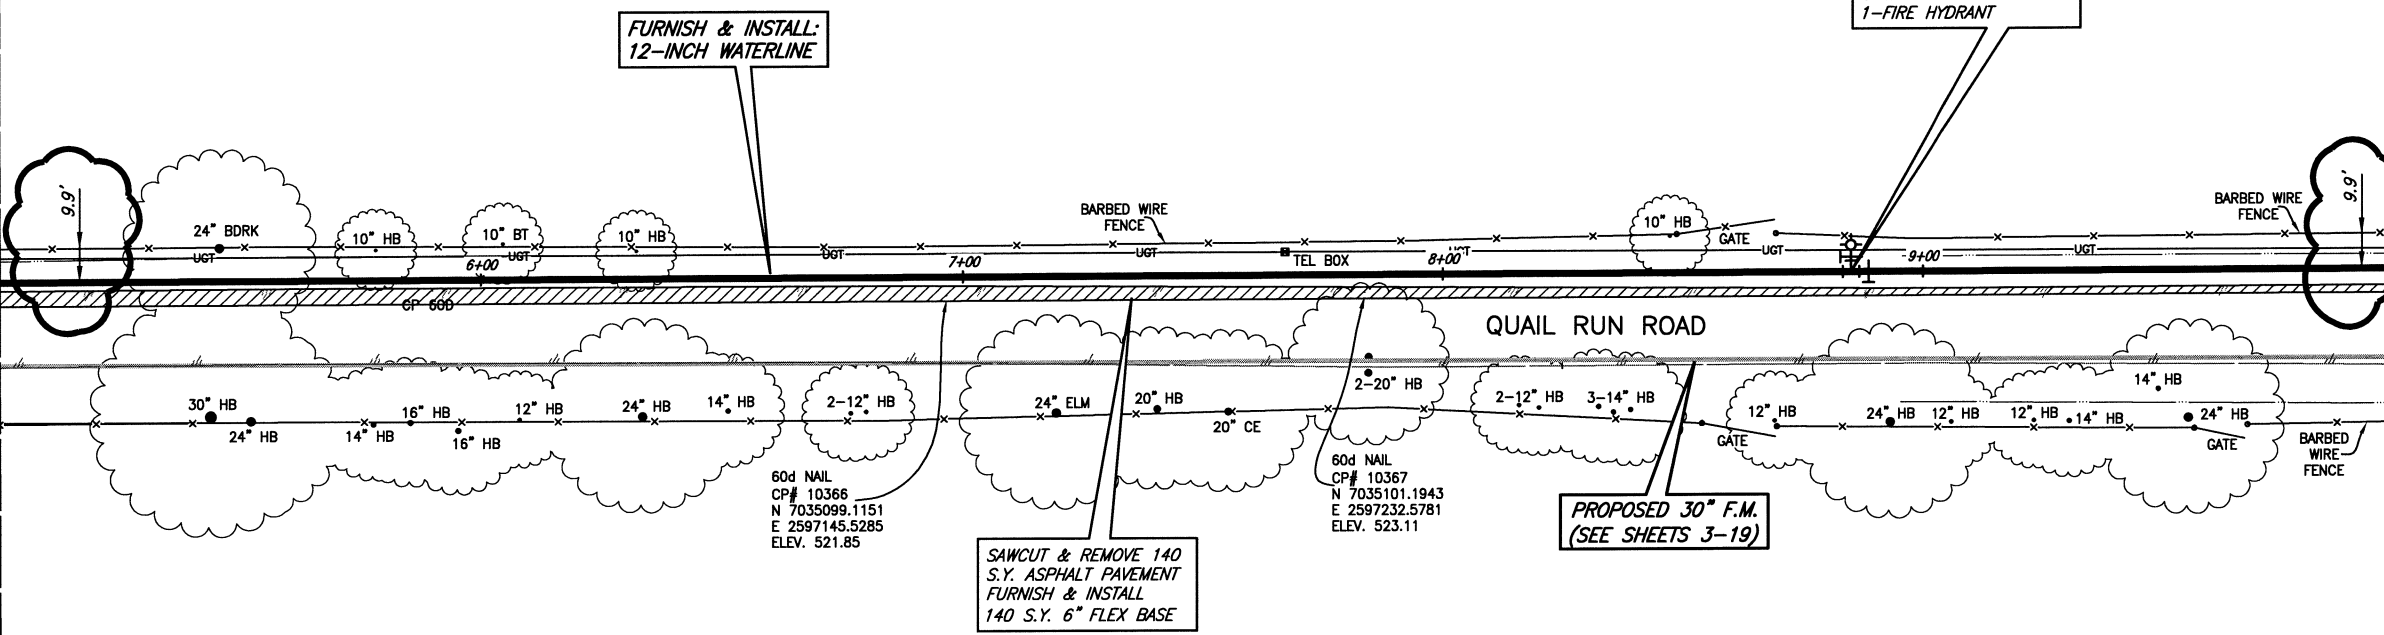



These plans and related specifications were prepared for construction of this specific project only. Reuse of these documents is not permitted without written authorization of Birkhoff, Hendricks, & Conway, L.L.P.

N 7035098.7023, E 2596948.9106  
MATCH LINE STA. 5+00

MATCH LINE STA. 10+00  
N 7035109.7097, E 2597448.7894

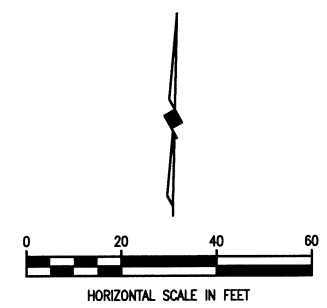

**CAUTION !!**  
MT. ZION WSC WATERLINE IN AREA. CONTACT DWIGHT LINDOP AT 972-670-9091 FOR LOCATES PRIOR TO EXCAVATING IN THIS AREA.

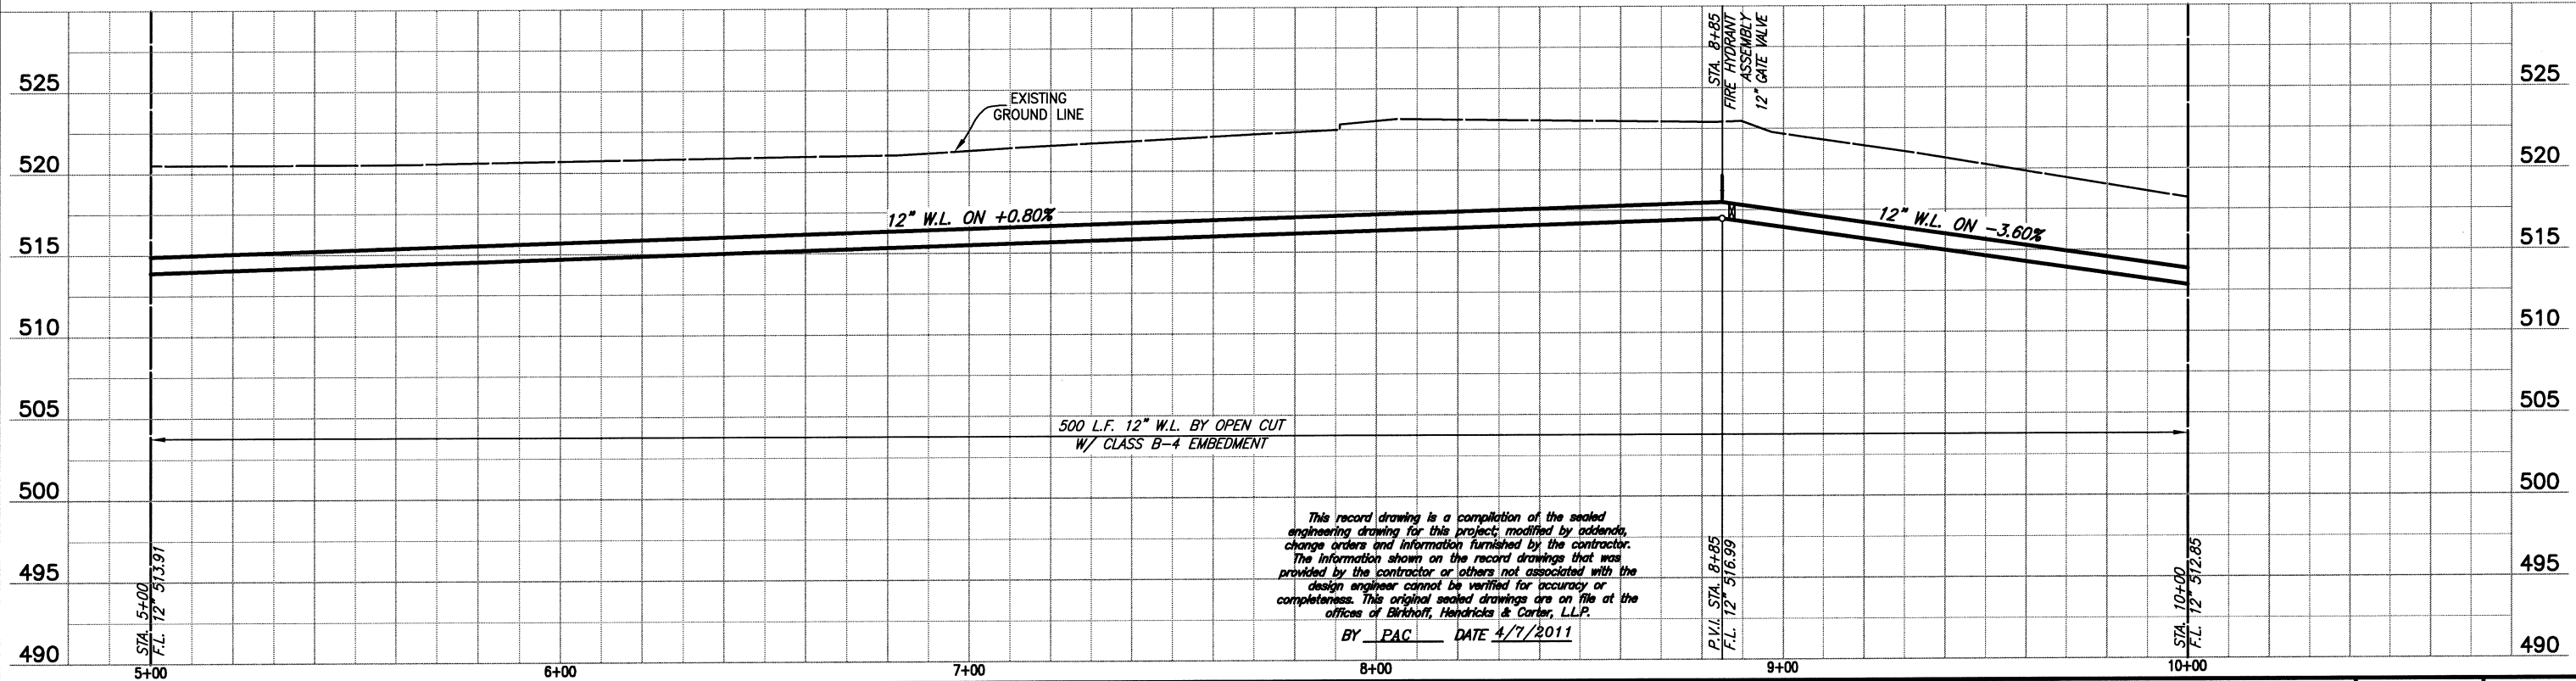

This record drawing is a compilation of the sealed engineering drawing for this project, modified by addenda, change orders and information furnished by the contractor. The information shown on the record drawings that was provided by the contractor or others not associated with the design engineer cannot be verified for accuracy or completeness. This original sealed drawings are on file at the offices of Birkhoff, Hendricks & Conway, L.L.P.

**BIRKHOFF, HENDRICKS & CONWAY, L.L.P.**  
PROFESSIONAL ENGINEERS  
Texas Firm F526  
11910 Greenville Ave., Suite 600  
Dallas, Texas (214) 361-7900



*Paul A. Carline*  
7/29/11

**CITY OF ROCKWALL, TEXAS**  
QUAIL RUN WATER LINE  
PLAN-PROFILE STA. 5+00 TO STA. 10+00

BHC PROJECT NO. 2007-129  
April, 2011  
SHEET NO. 21