
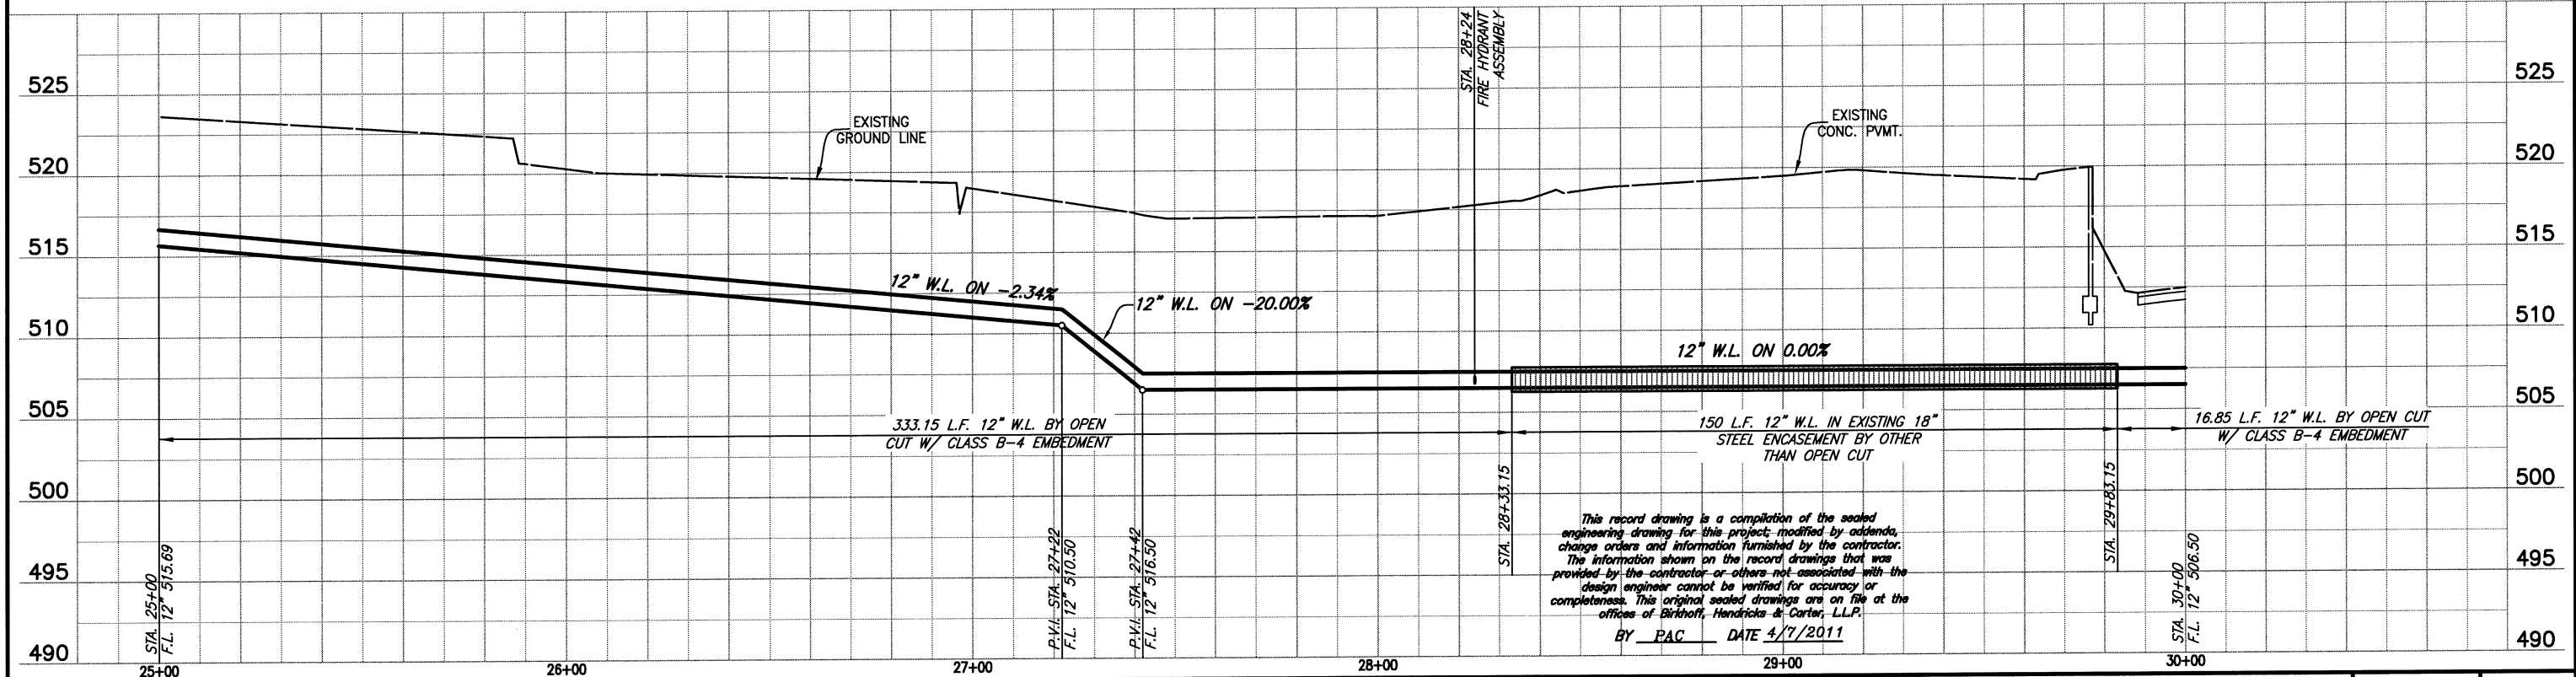
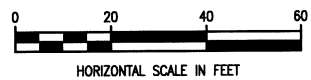


These plans and related specifications were prepared for construction of this specific project only. Reuse of these documents is not permitted without written authorization of Birkhoff, Hendricks, & Conway, L.L.P.

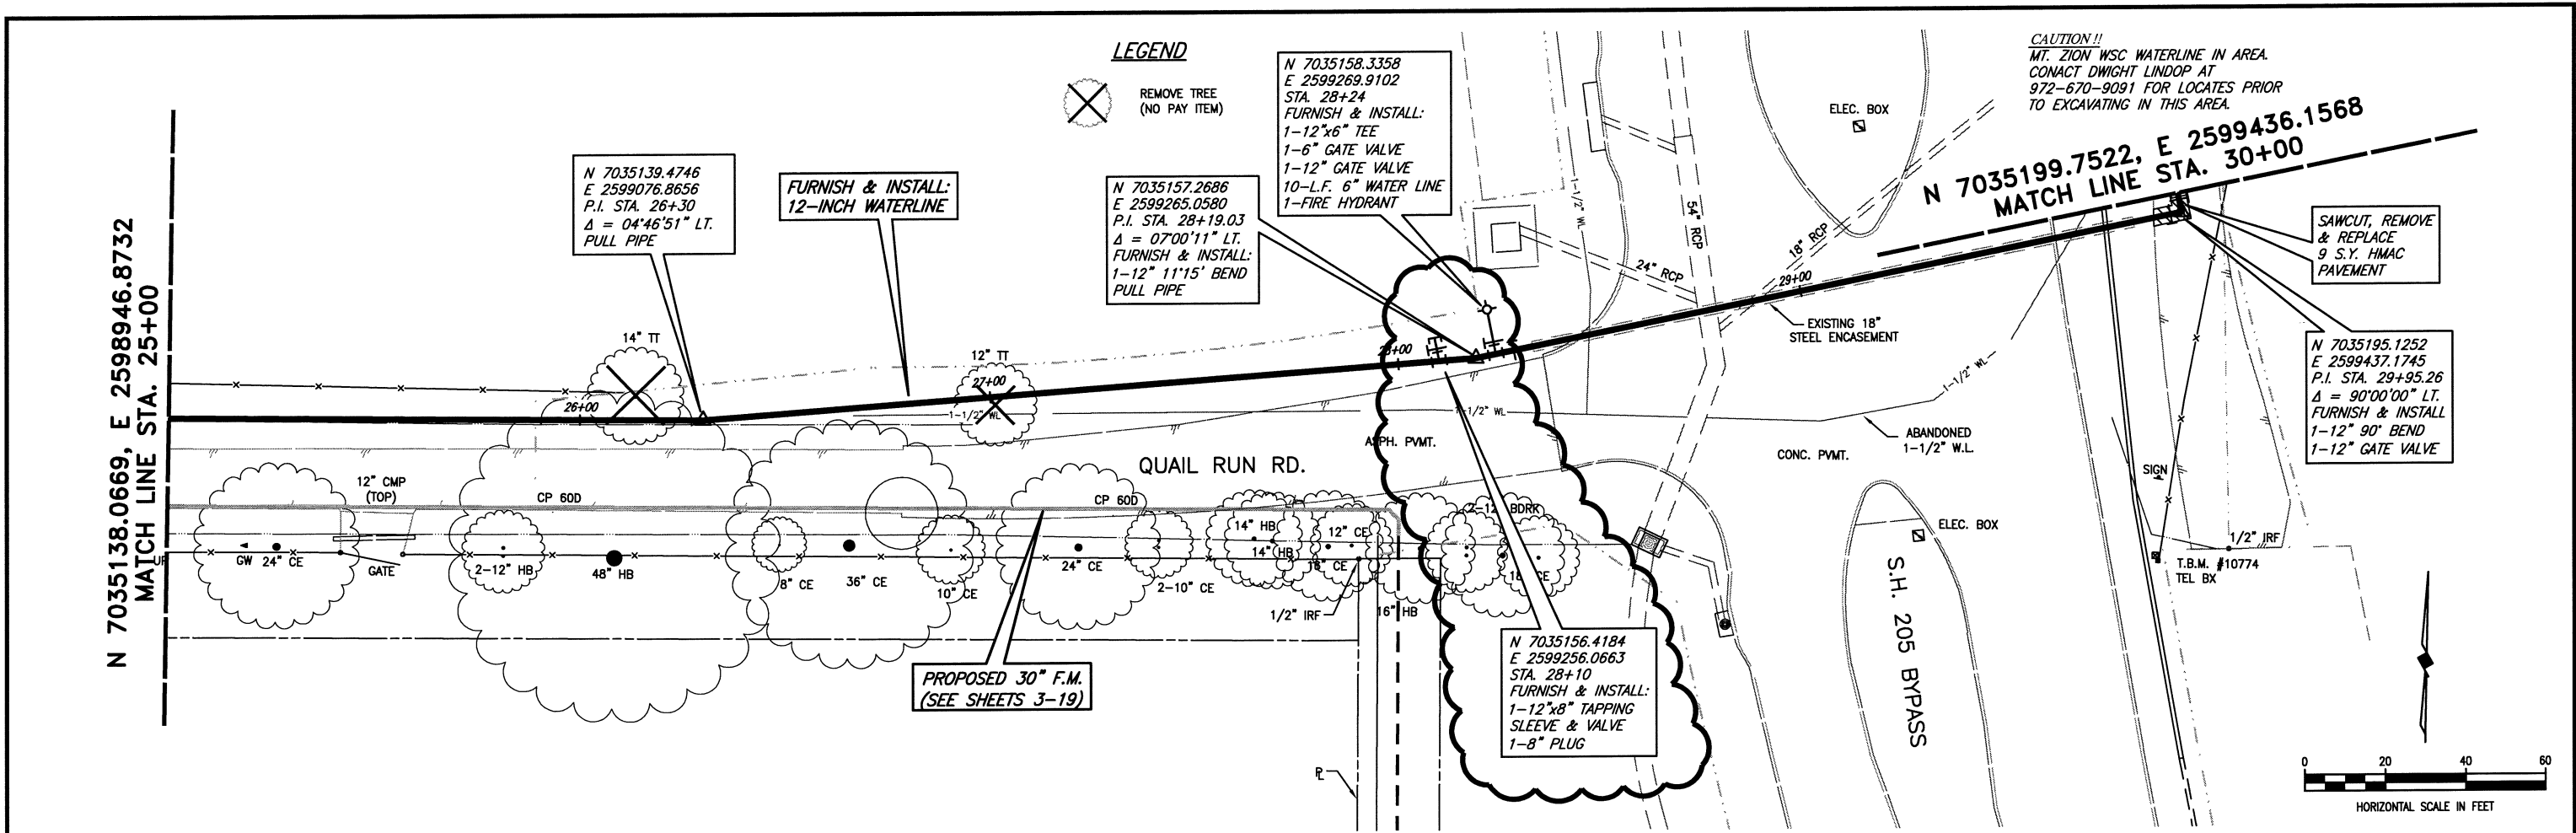

<p>BIRKHOFF, HENDRICKS & CONWAY, L.L.P. PROFESSIONAL ENGINEERS Texas Firm F526 11910 Greenville Ave., Suite 600 Dallas, Texas (214) 361-7900</p>				<p>CITY OF ROCKWALL, TEXAS QUAIL RUN WATER LINE PLAN-PROFILE STA. 25+00 TO STA. 30+00</p>	<p>BHC PROJECT NO. 2007-129 April, 2011</p>	<p>SHEET NO. 25</p>
---	--	--	--	--	---	---------------------