


FIELD CHANGE NO. 1 - NOVEMBER 17, 2009

BIRKHOFF, HENDRICKS & CONWAY, L.L.P.
 PROFESSIONAL ENGINEERS
 Texas Firm F526
 11910 Greenville Ave., Suite 600
 Dallas, Texas 75243 (214) 361-7900

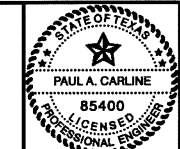

[Signature]
 11/7/11

CITY ROCKWALL, TEXAS
 SQUABBLE CREEK
 30 INCH FORCE MAIN
 PLAN AND PROFILE
 STA. 15+00 TO STA. 20+00

BHC
 PROJECT NO.
 2007-110
 July 2009

SHEET NO.
6

These plans and related specifications were prepared for construction of this specific project only. Reuse of these documents is not permitted without written authorization of Birkhoff, Hendricks, & Conway, L.L.P.