


REVISIONS: 3/2/12 - RLOWE
 H:\Projects\Rockwall\2007110\Sheets\Complete Section\1\2007110-Cover-M.dwg
 PLOT SCALE: 1:1
 PLOT STYLE: 11x17.ctb
 PLOTTED BY: RLOWE ON 3/5/2012

CITY OF ROCKWALL, TEXAS

CONSTRUCTION PLANS FOR: SQUABBLE CREEK TO BUFFALO CREEK WASTEWATER TRANSFER SECTION IV

SQUABBLE CREEK FORCE MAIN

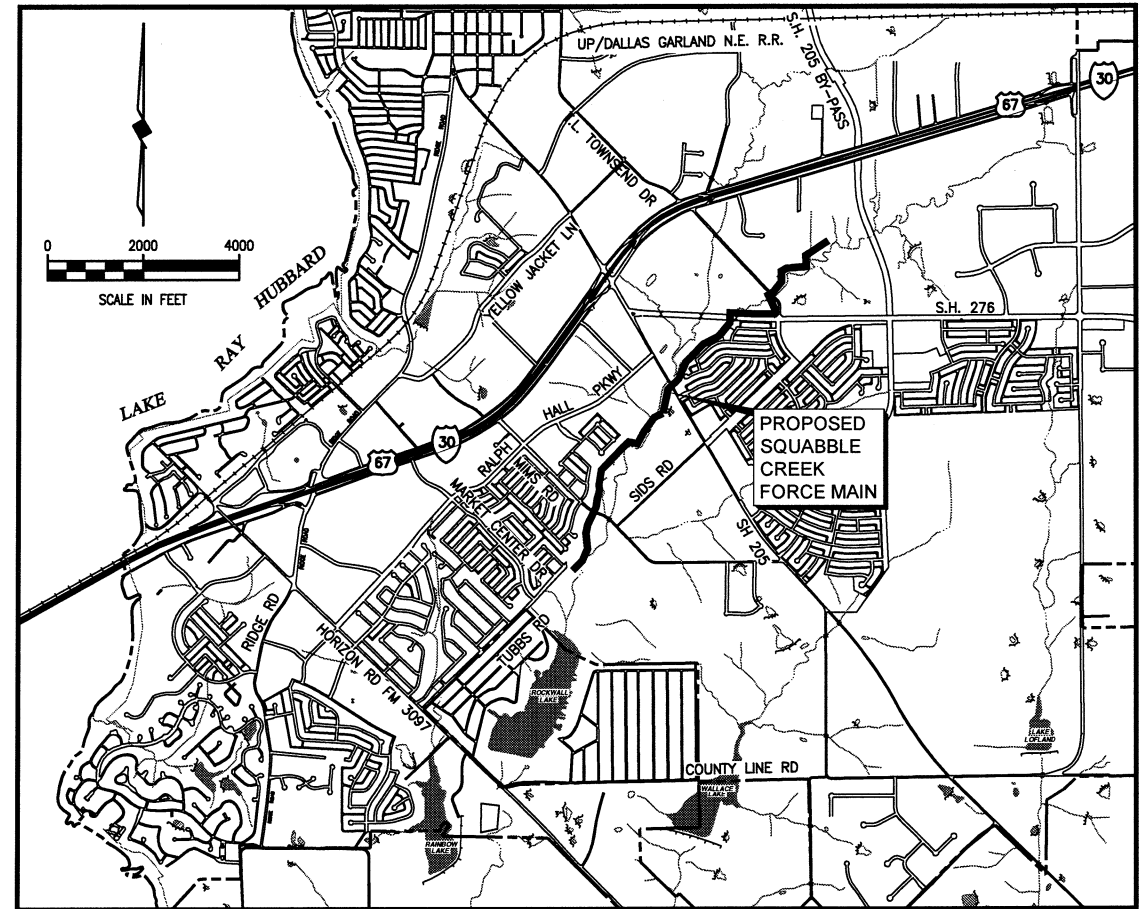

LOCATION MAP

SHEET INDEX

SHEET NO.	SHEET DESCRIPTION	SHEET NO.	SHEET DESCRIPTION
-	COVER SHEET AND LOCATION MAP	19	PLAN-PROFILE STA. 159+00 TO STA. 164+00
1	GENERAL NOTES	20	PLAN-PROFILE STA. 164+00 TO STA. 169+50
2	PLAN-PROFILE STA. 68+50 TO STA. 70+00	21	PLAN-PROFILE STA. 169+50 TO STA. 173+45
3	PLAN-PROFILE STA. 70+00 TO STA. 75+00	22	DETAILS
4	PLAN-PROFILE STA. 75+00 TO STA. 80+00		
5	PLAN-PROFILE STA. 80+00 TO STA. 85+00		
6	PLAN-PROFILE STA. 85+00 TO STA. 90+00		
7	PLAN-PROFILE STA. 90+00 TO STA. 95+00		
8	PLAN-PROFILE STA. 95+00 TO STA. 100+00 (EQUATION)		
9	PLAN-PROFILE STA. 100+00 TO STA. 105+00		
10	PLAN-PROFILE STA. 105+00 TO STA. 110+50		
11	PLAN-PROFILE STA. 110+50 TO STA. 124+00 (EQUATION)		
12	PLAN-PROFILE STA. 124+00 TO STA. 129+00 (EQUATION)		
13	PLAN-PROFILE STA. 129+00 TO STA. 134+00		
14	PLAN-PROFILE STA. 134+00 TO STA. 139+00		
15	PLAN-PROFILE STA. 139+00 TO STA. 144+00		
16	PLAN-PROFILE STA. 144+00 TO STA. 149+00		
17	PLAN-PROFILE STA. 149+00 TO STA. 154+00		
18	PLAN-PROFILE STA. 154+00 TO STA. 159+00		

COUNCIL MEMBERS

- BILL CECIL, MAYOR**
- DAVID SWEET, MAYOR PRO-TEM**
- MATT SCOTT**
- CLIFF SEVIER**
- GLEN FERRIS**
- MARK RUSSO**
- MARGO NIELSEN**



CITY MANAGER

JULIE COUCH

ASSISTANT CITY MANAGER

RICHARD CROWLEY

CITY ENGINEER

CHUCK TODD, P.E.

BIRKHOFF, HENDRICKS & CARTER, L.L.P.

PROFESSIONAL ENGINEERS
 Texas Firm 526
 Dallas, Texas

November 2010



[Handwritten Signature]
 11/17/10

This record drawing is a compilation of the sealed engineering drawing for this project; modified by addenda, change orders and information furnished by the contractor. The information shown on the record drawings that was provided by the contractor or others not associated with the design engineer cannot be verified for accuracy or completeness. This original sealed drawings are on file at the offices of Birkhoff, Hendricks & Carter, L.L.P.
 BY PAC DATE 03/05/12