




These plans and related specifications were prepared for construction of this specific project only. Reuse of these documents is not permitted without written authorization of Birkhoff, Hendricks, & Carter, L.L.P.

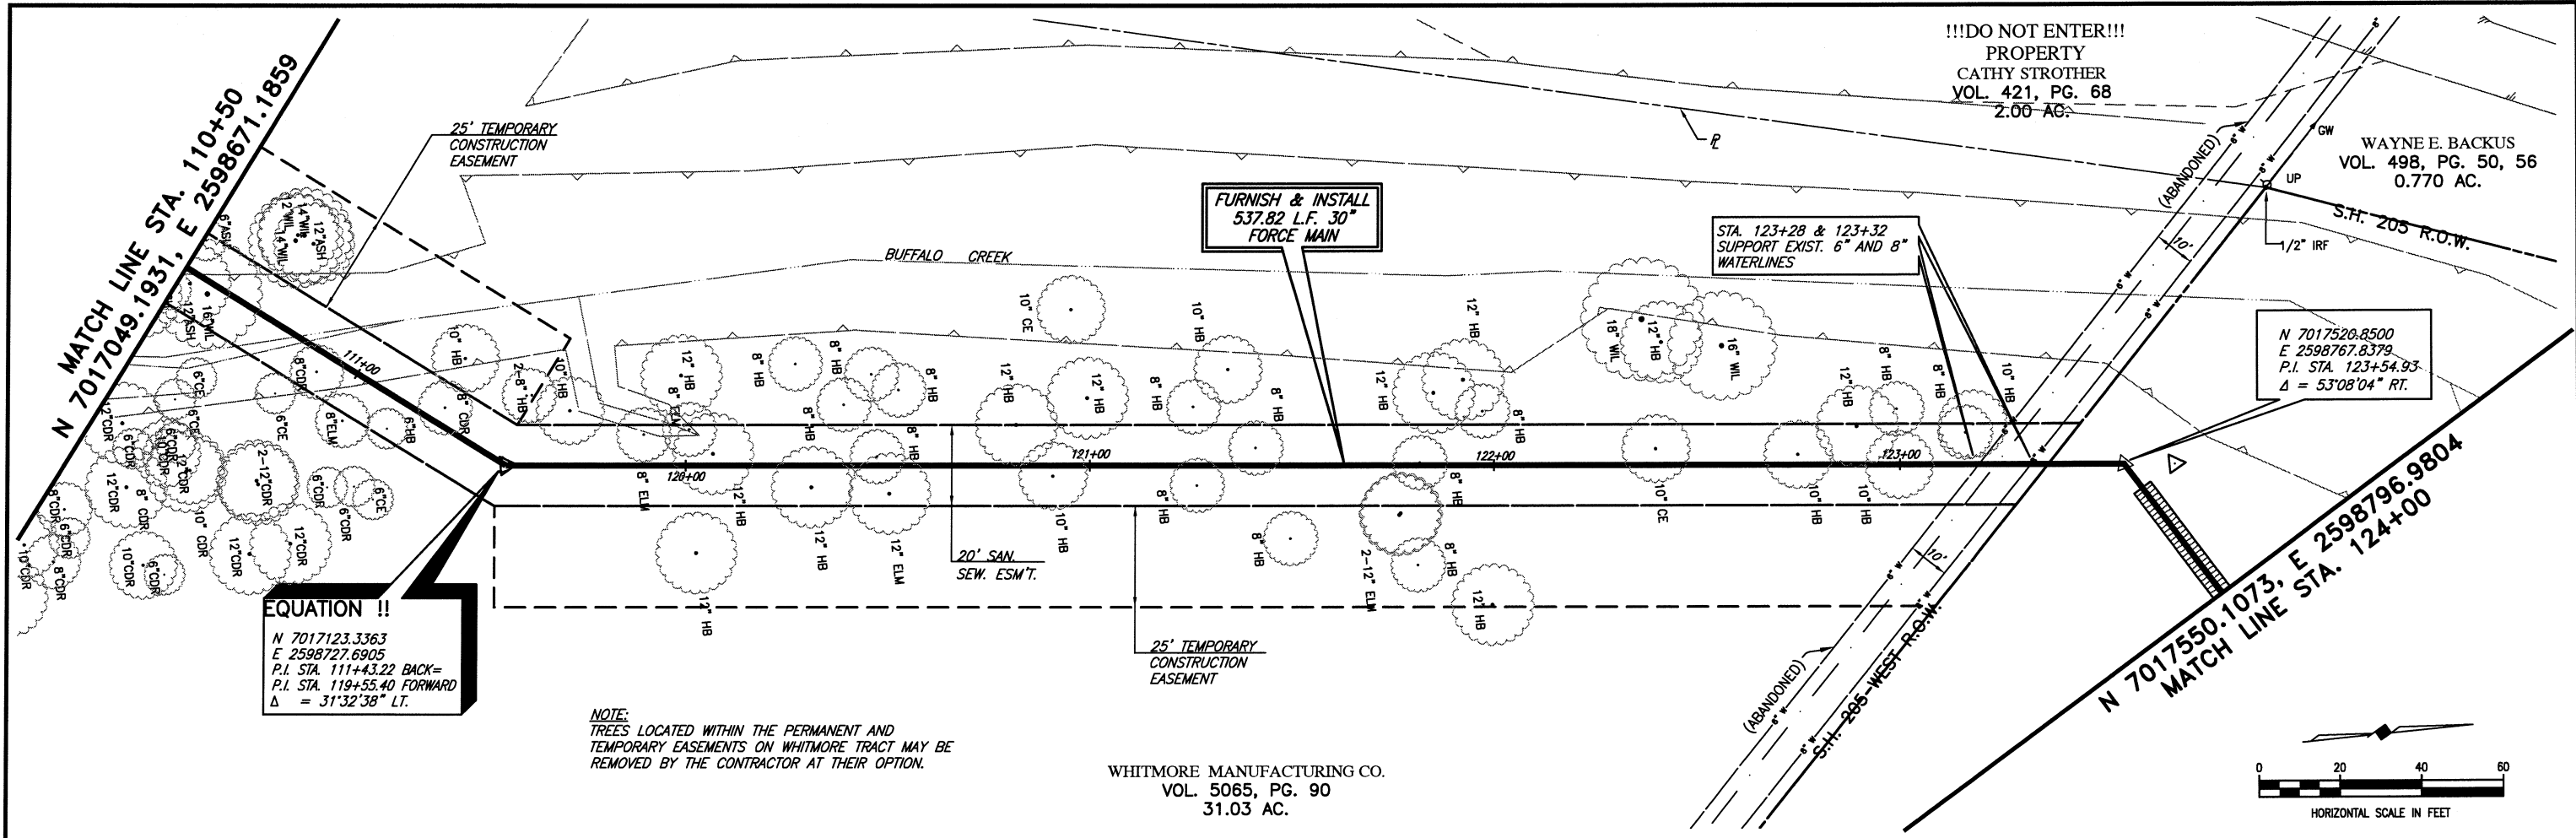

EQUATION !!
 N 7017123.3363
 E 2598727.6905
 P.I. STA. 111+43.22 BACK=
 P.I. STA. 119+55.40 FORWARD
 Δ = 31°32'38" LT.

NOTE:
 TREES LOCATED WITHIN THE PERMANENT AND
 TEMPORARY EASEMENTS ON WHITMORE TRACT MAY BE
 REMOVED BY THE CONTRACTOR AT THEIR OPTION.

WHITMORE MANUFACTURING CO.
 VOL. 5065, PG. 90
 31.03 AC.

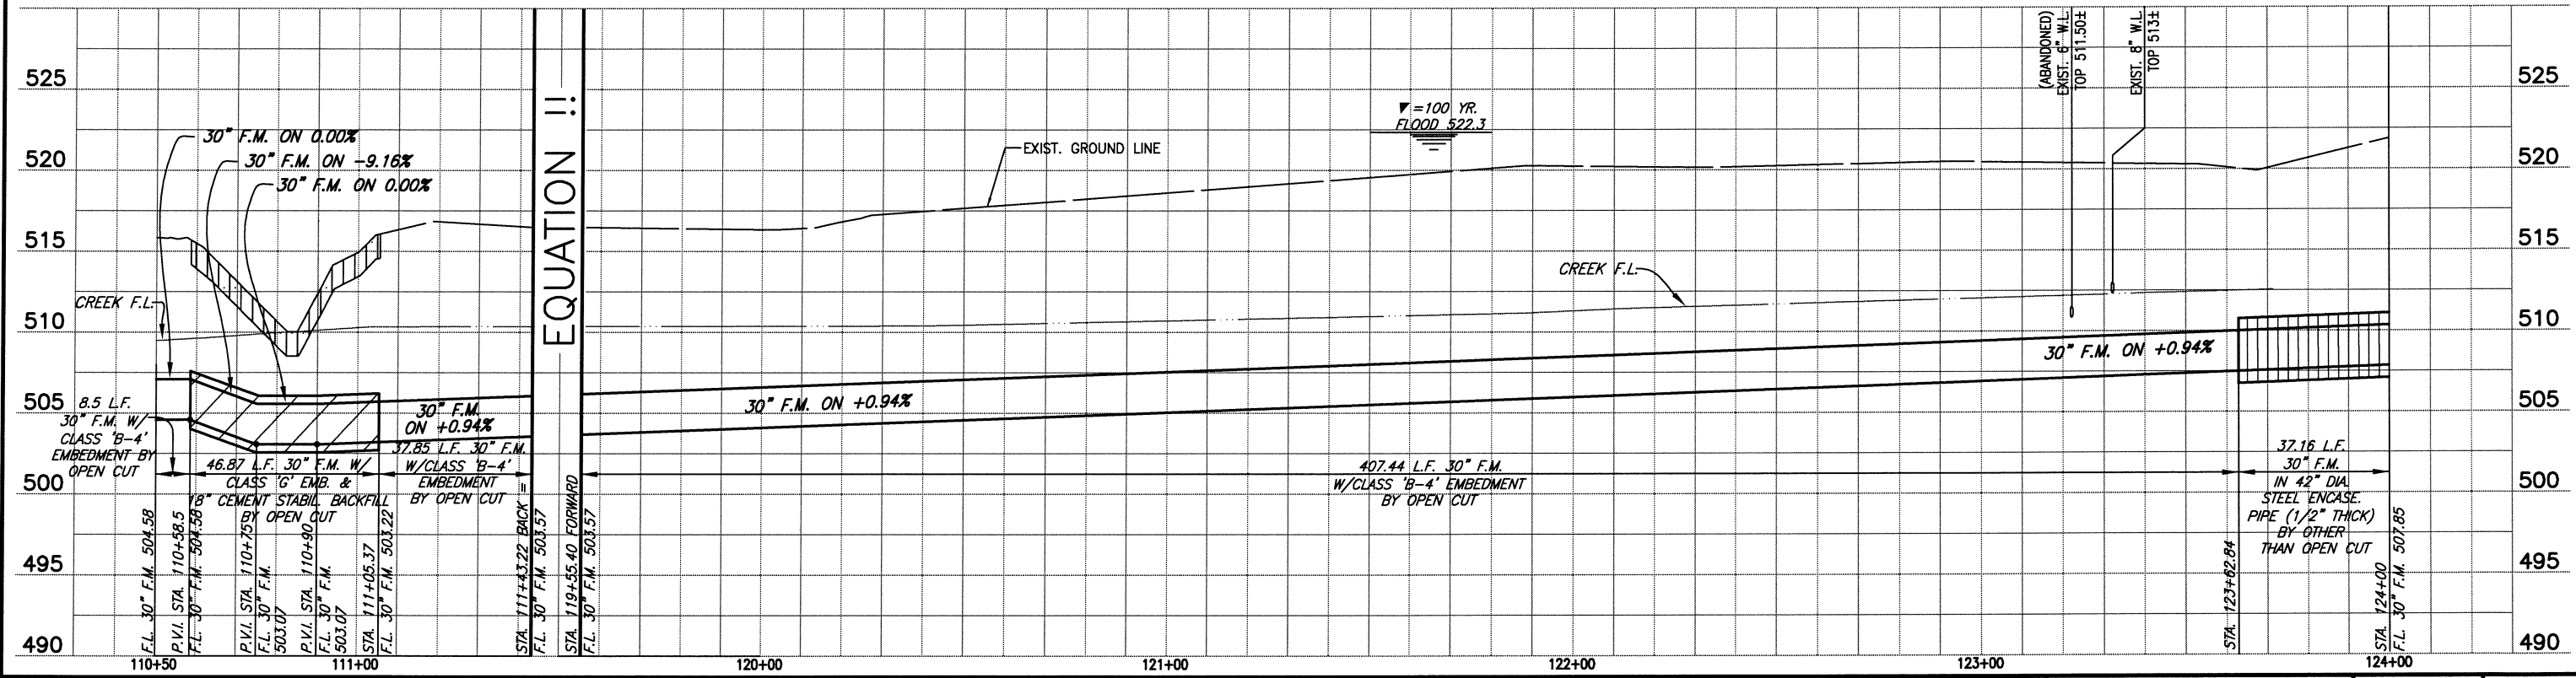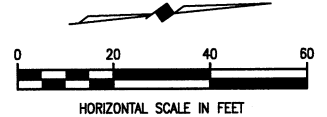

BIRKHOFF, HENDRICKS & CARTER, L.L.P.
 PROFESSIONAL ENGINEERS
 Texas Firm F526
 11910 Greenville Ave., Suite 600
 Dallas, Texas (214) 361-7900



CITY OF ROCKWALL, TEXAS
 SQUABBLE CREEK FORCE MAIN
PLAN AND PROFILE
 STA. 110+50 TO STA. 124+00 (EQUATION)

BHC
 PROJECT NO.
 2007-110
 May, 2011

SHEET NO.
11