

1860 INVESTMENTS, LTD.  
VOL. 4643, PG. 229  
11.803 AC.

N 7019949.2680  
E 2601183.3572  
P.I. STA. 164+83.32  
 $\Delta = 58^{\circ}11'59''$  RT.

25' TEMPORARY  
CONST. ESM'T.

TREE LINE  
(TYPICAL)

20' SAN.  
SEW. ESM'T.

N 7020011.8934  
E 2601285.4857  
P.I. STA. 166+03.12  
 $\Delta = 26^{\circ}15'07''$  RT.

FURNISH & INSTALL  
550 L.F. 30"  
FORCE MAIN

1860 INVESTMENTS, LTD.  
VOL. 4643, PG. 229  
11.803 AC.


KHOSROW SADEGHIAN  
VOL. 3138, PG. 188  
1.588 AC.

COLIN-G PROPERTIES, LTD.  
VOL. 2714, PG. 07  
6.19 AC.

This record drawing is a compilation of the sealed  
engineering drawing for this project; modified by addenda,  
change orders and information furnished by the contractor.  
The information shown on the record drawings that was  
provided by the contractor or others not associated with the  
design engineer cannot be verified for accuracy or  
completeness. This original sealed drawings are on file at the  
offices of Birkhoff, Hendricks & Carter, L.L.P.  
BY PAC DATE 03/05/12

N 7019865.9494, E 2601182.9449  
MATCH LINE STA. 164+00

N 7020043.7219, E 2601630.9022  
MATCH LINE STA. 169+50

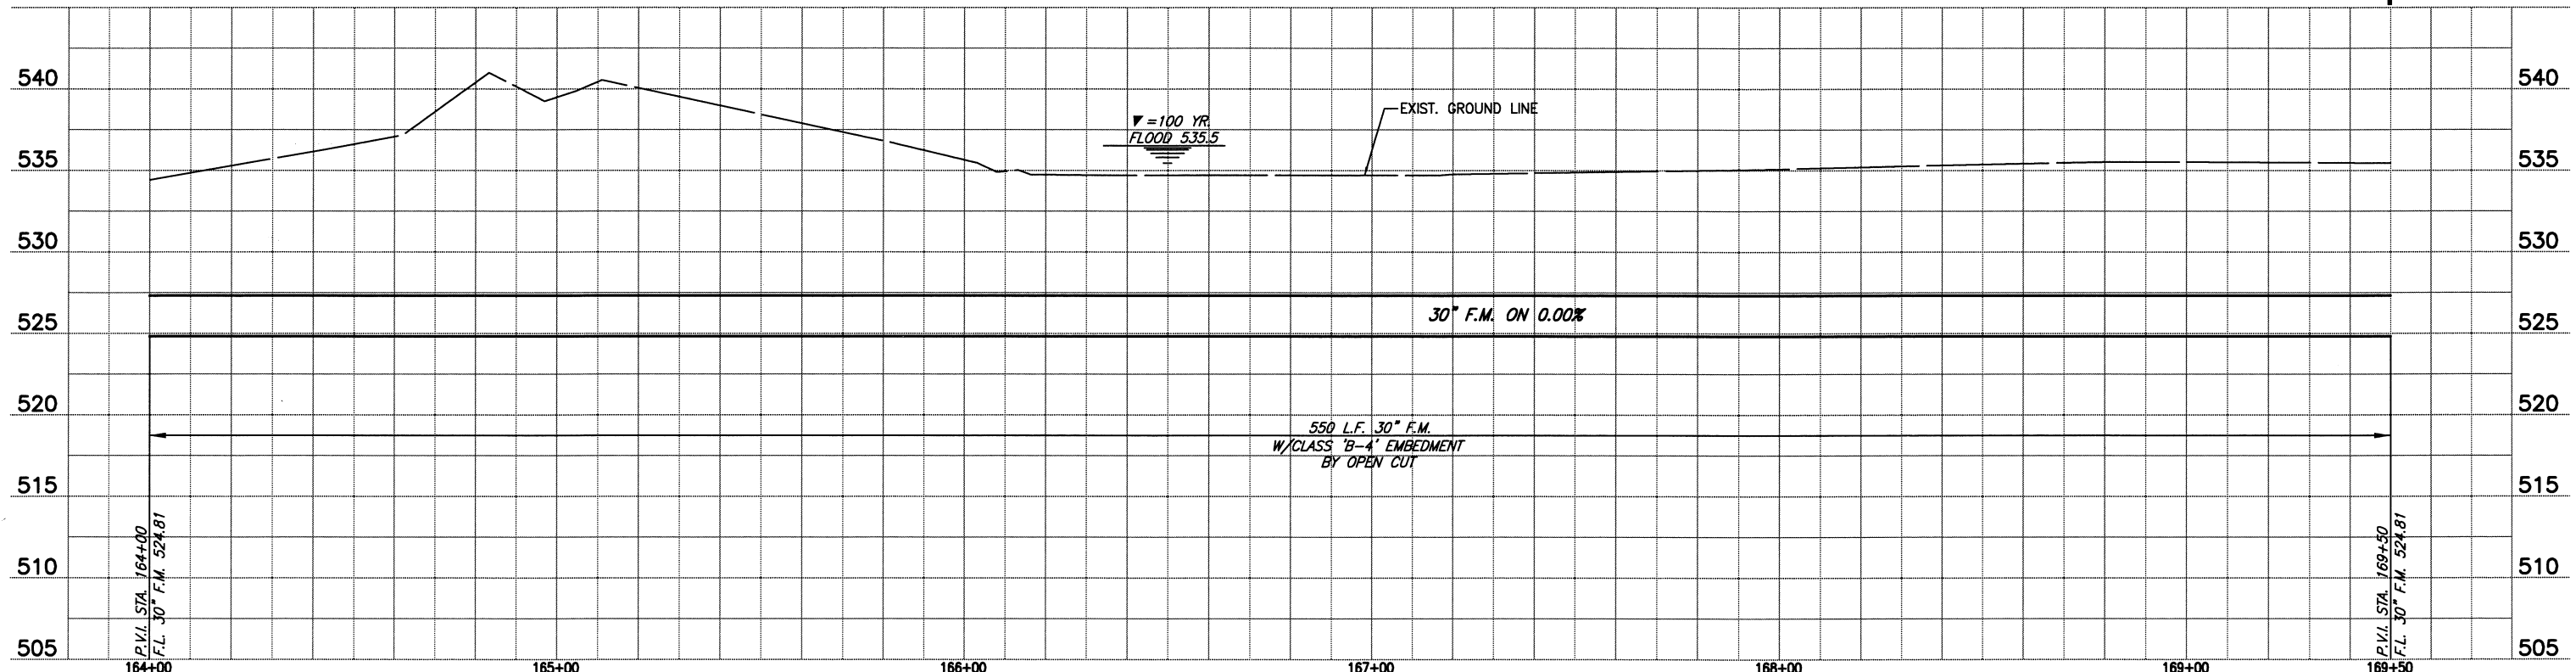

These plans and related specifications were prepared for construction of this specific project only. Reuse of these documents is not permitted without written authorization of Birkhoff, Hendricks, & Carter, L.L.P.

<p><b>BIRKHOFF, HENDRICKS &amp; CARTER, L.L.P.</b> PROFESSIONAL ENGINEERS Texas Firm F526 11910 Greenville Ave., Suite 600 Dallas, Texas (214) 361-7900</p>			<p><b>CITY OF ROCKWALL, TEXAS</b> SQUABBLE CREEK FORCE MAIN  PLAN AND PROFILE STA. 164+00 TO STA. 169+50</p>	<p>BHC PROJECT NO. 2007-110  November, 2010</p>	<p>SHEET NO. <b>20</b></p>
---	--	--	--	---	--------------------------------