


REVISIONS: 3/22/10 - RLOWE
H:\Projects\Rockwall\2007110\Sheets\The Mansions Sheets-Squabble Ck FIA\Cover-2007110-Mansion.dwg
PLOT SCALE: 1:1
PLOT STYLE: 11x17.ctb
PLOTTED BY: RLOWE ON 3/22/2010

CITY OF ROCKWALL, TEXAS

CONSTRUCTION PLANS FOR: SQUABBLE CREEK TO BUFFALO CREEK WASTEWATER TRANSFER SECTION 'THE MANSIONS OF ROCKWALL' **SQUABBLE CREEK FORCE MAIN**

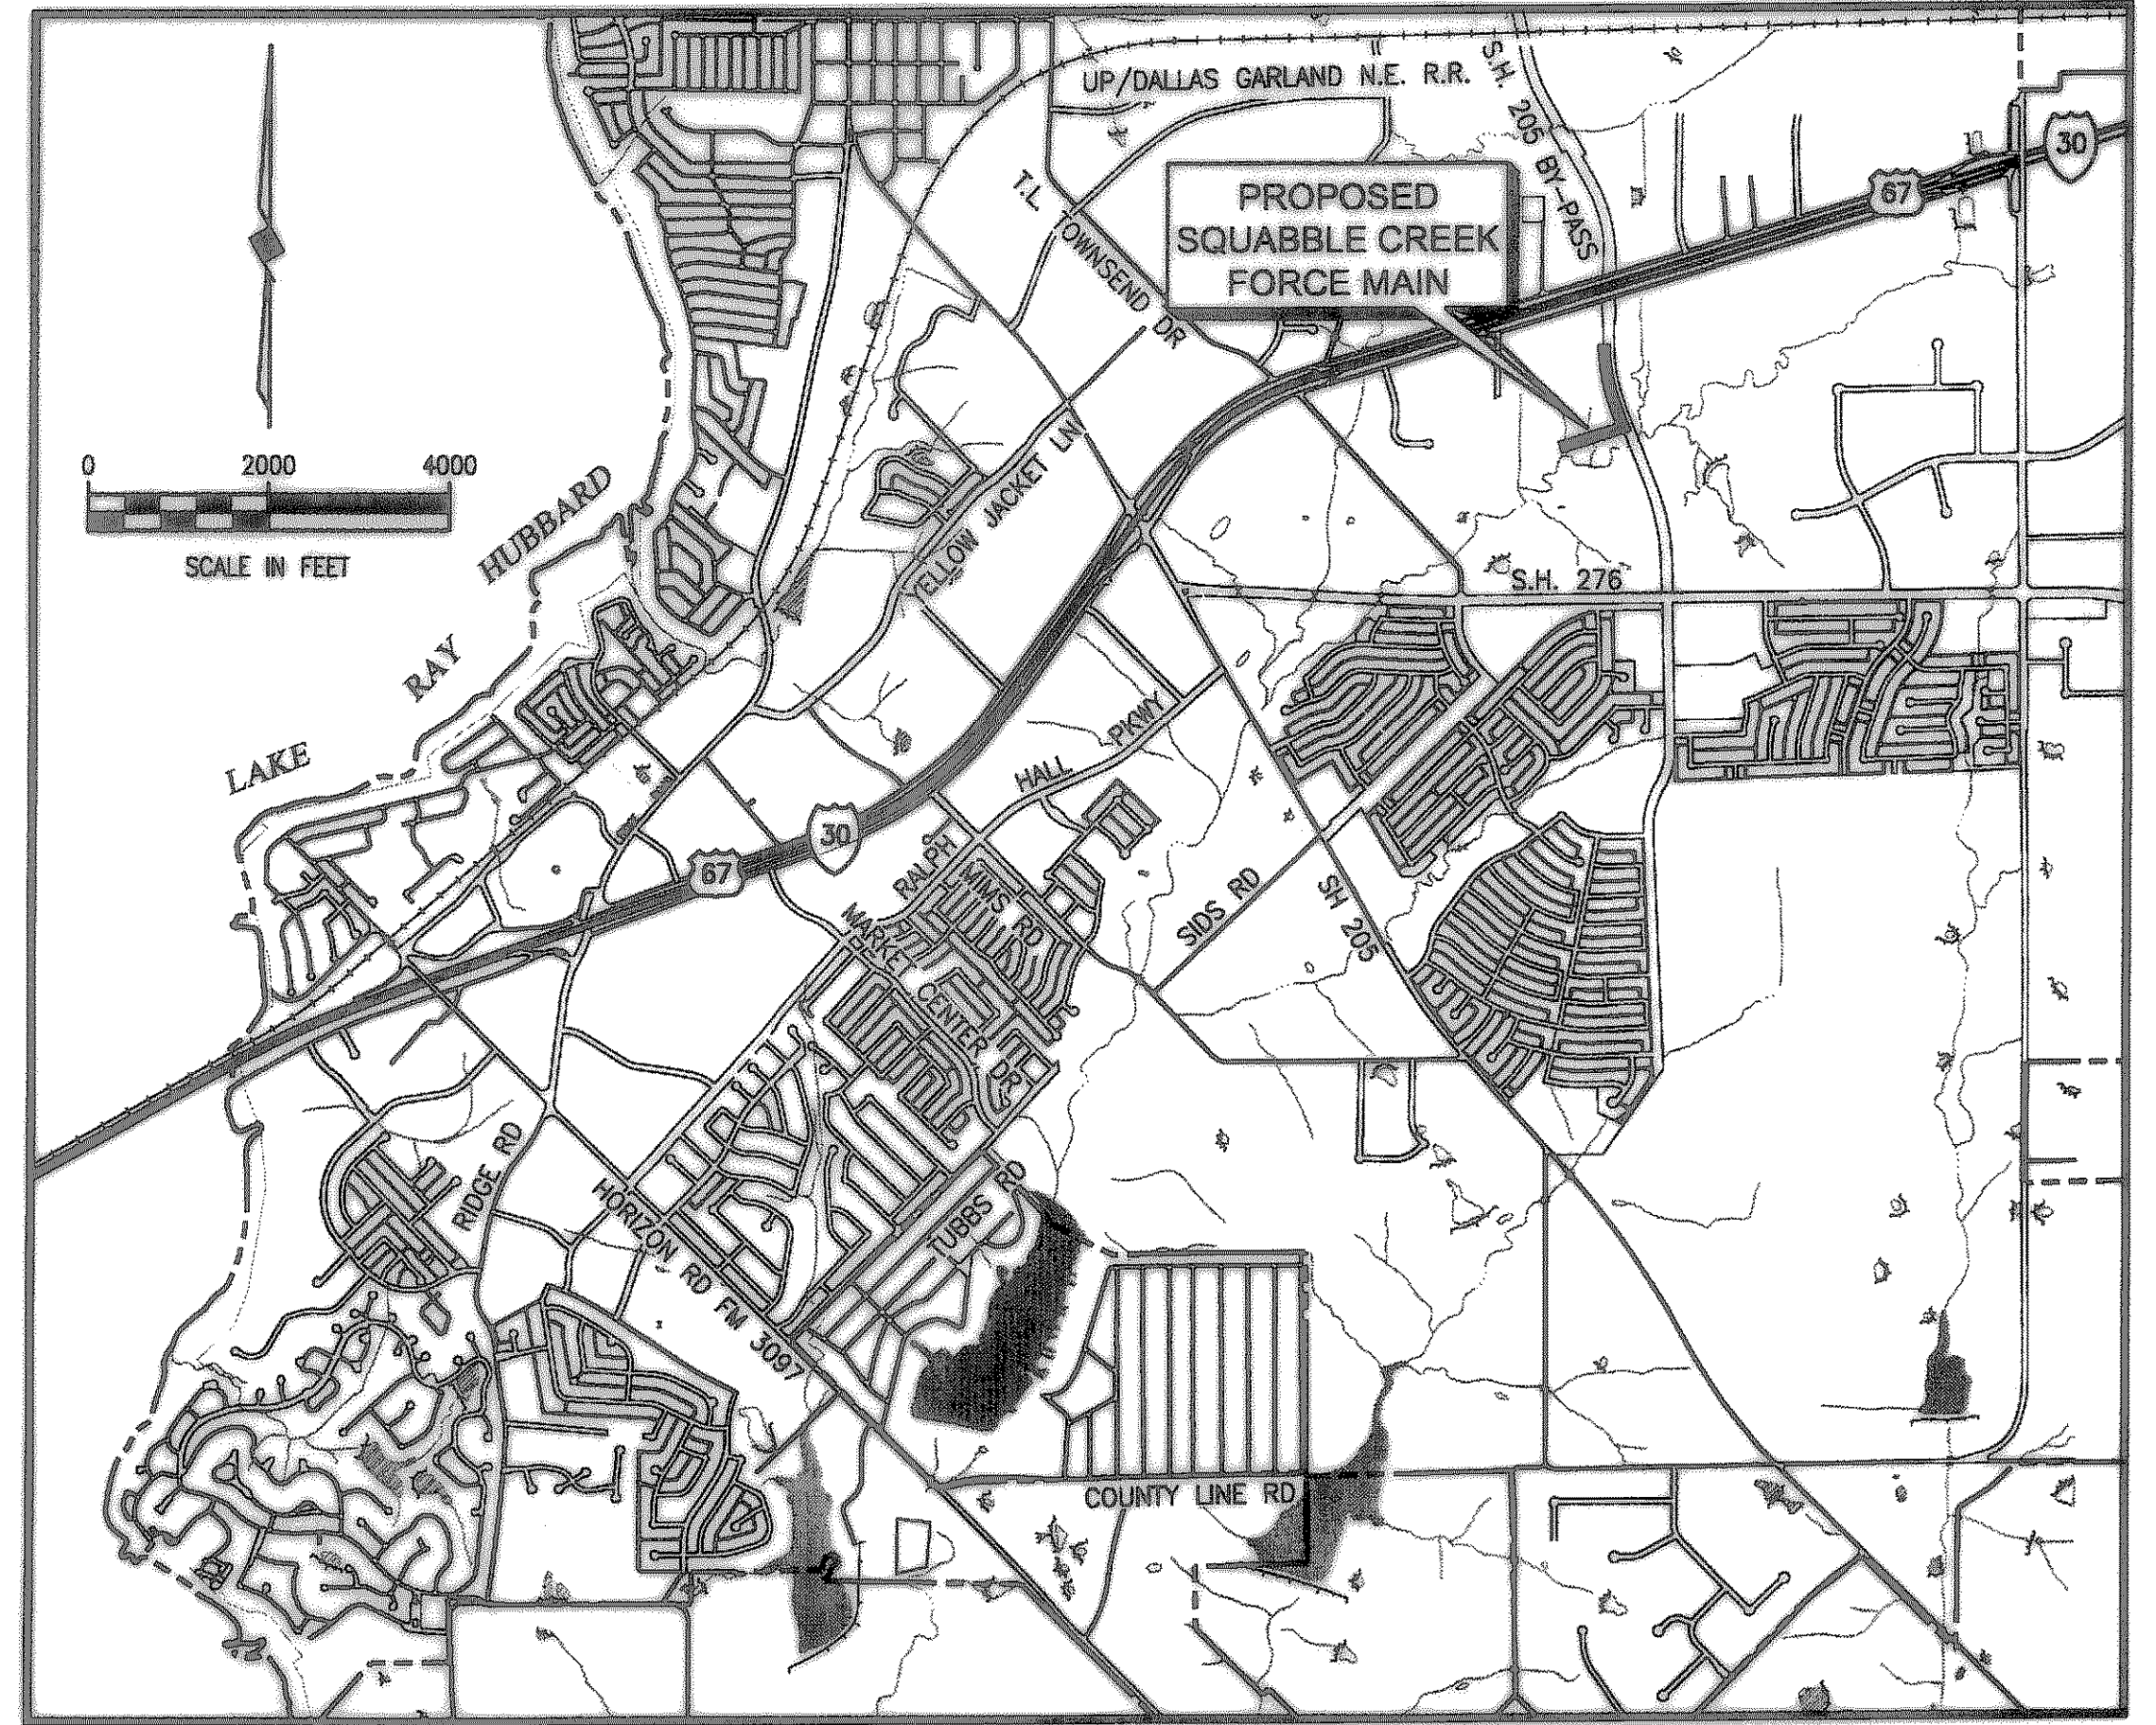

LOCATION MAP

COUNCIL MEMBERS

- BILL CECIL, MAYOR
- CLIFF SEVIER, MAYOR PRO-TEM
- MATT SCOTT
- DAVID SWEET
- GLEN FERRIS
- MARK RUSSO
- MARGO NIELSEN

CITY MANAGER


JULIE COUCH

ASSISTANT CITY MANAGER

RICHARD CROWLEY

CITY ENGINEER

CHUCK TODD, P.E.

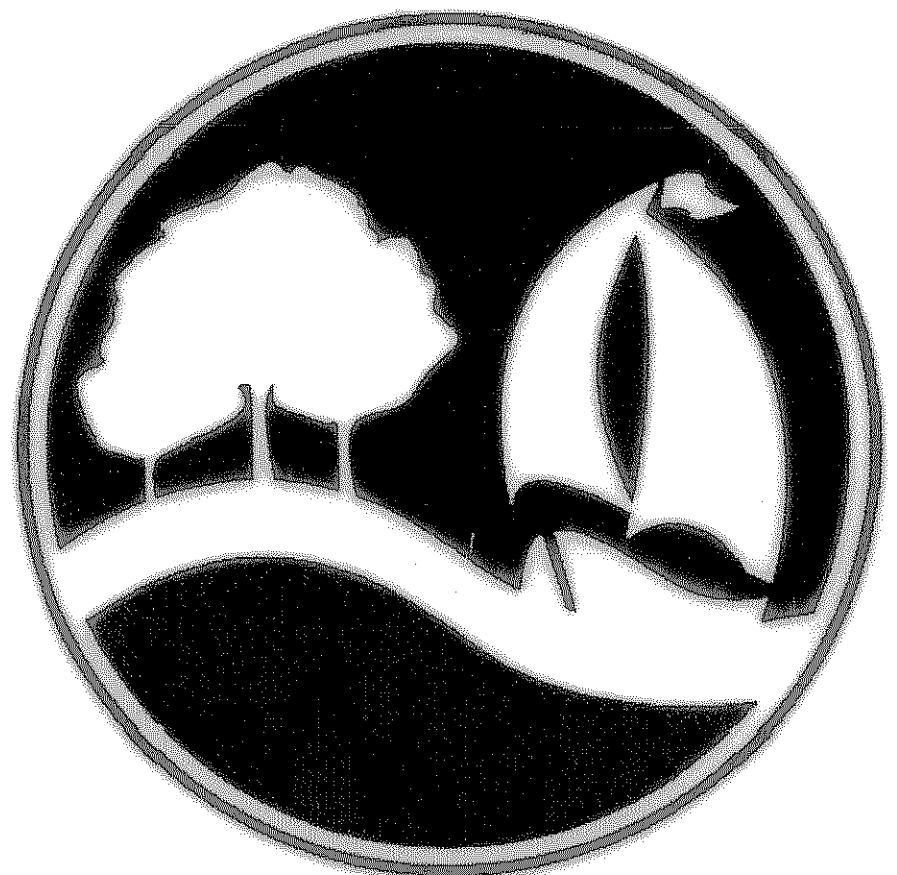

BIRKHOFF, HENDRICKS & CONWAY, L.L.P.
PROFESSIONAL ENGINEERS

Texas Firm 526
Dallas, Texas

February 2009



SHEET INDEX

<u>SHEET NO.</u>	<u>SHEET DESCRIPTION</u>
-	COVER SHEET AND LOCATION MAP
1	GENERAL NOTES
2	PLAN-PROFILE STA. 169+50 TO STA. 174+50
3	PLAN-PROFILE STA. 174+50 TO STA. 180+00
4	PLAN-PROFILE STA. 180+00 TO STA. 185+50
5	PLAN-PROFILE STA. 185+50 TO STA. 190+50
6	PLAN-PROFILE STA. 190+50 TO STA. 195+50

This record drawing is a compilation of the sealed engineering drawing for this project; modified by addenda, change orders and information furnished by the contractor. The information shown on the record drawings that was provided by the contractor or others not associated with the design engineer cannot be verified for accuracy or completeness. This original sealed drawings are on file at the offices of Birkhoff, Hendricks & Carter, L.L.P.
BY PAC DATE 03/17/10