


REVISID: 10/14/09 - JUAN MORALES
PLOT SCALE: 1:1
H:\Projects\Rockwall\2008\30\Sheets\2008\30-Cover.dwg
PLOT STYLE: 11x17.ctb
PLOTTED BY: JUAN MORALES ON: 10/14/2009

CITY OF ROCKWALL, TEXAS

CONSTRUCTION PLANS FOR **SQUABBLE CREEK INTERCEPTOR REPLACEMENT & REHABILITATION, PHASE II (LINES A & B)** **LAKESIDE VILLAGE SANITARY SEWER REHABILITATION (LINE C)**

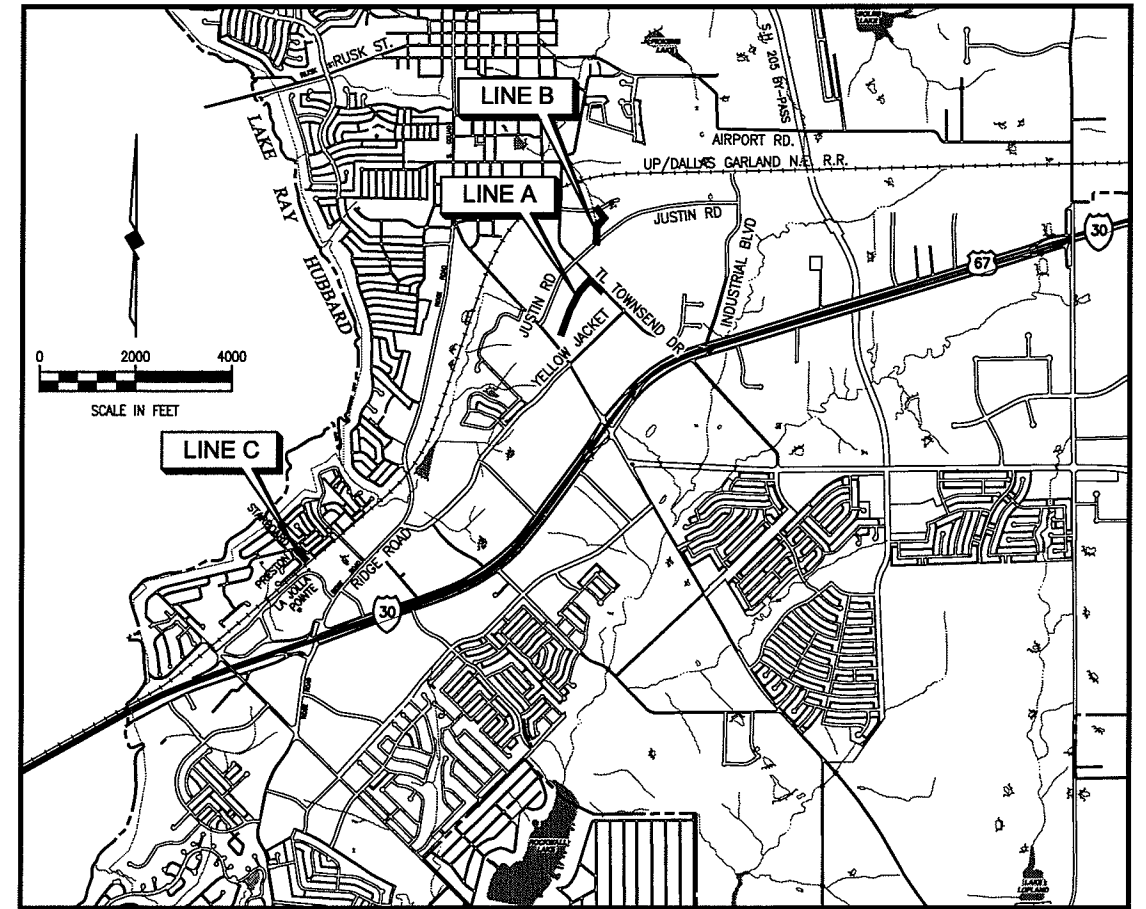

COUNCIL MEMBERS

BILL CECIL, MAYOR
CLIFF SEVIER, MAYOR PRO-TEM
MATT SCOTT
DAVID SWEET
GLEN FARRIS
MARK RUSSO
MARGO NIELSEN

CITY MANAGER

JULIE COUCH

ASSISTANT CITY MANAGER

RICHARD CROWLEY

CITY ENGINEER

CHUCK TODD, P.E.



BIRKHOFF, HENDRICKS & CONWAY, L.L.P.
PROFESSIONAL ENGINEERS
Dallas, Texas

February, 2009



LOCATION MAP

SHEET INDEX

<u>SHEET NO.</u>	<u>SHEET DESCRIPTION</u>
1	COVER SHEET AND LOCATION MAP
2	GENERAL NOTES
3	LINE A PLAN-PROFILE STA. 0+00 TO STA. 5+00
4	LINE A PLAN-PROFILE STA. 5+00 TO STA. 10+00
5	LINE A PLAN-PROFILE STA. 10+00 TO STA. 15+11
6	LINE B PLAN-PROFILE STA. 0+00 TO STA. 5+00
7	LINE B PLAN-PROFILE STA. 5+00 TO STA. 10+28
8	LINE C PLAN STA. 0+00 TO STA. 3+29
9	SEWER NOTES & DETAILS
10	DETAILS

This record drawing is a compilation of the sealed engineering drawing for this project; modified by addenda, change orders and information furnished by the contractor. The information shown on the record drawings that was provided by the contractor or others not associated with the design engineer cannot be verified for accuracy or completeness. This original sealed drawings are on file at the offices of Birkhoff, Hendricks & Conway, L.L.P.

BY P.A.C. DATE 10/14/09