

REVISD: 5/14/07 - MOLDHAM
H:\Projects\Rockwall\2006148\Sheets\2006148-01.dwg
PLOT SCALE: 1:1
PLOT STYLE: 22X34.ctb
PLOTTED BY: MOLDHAM ON 5/15/2007

CITY OF ROCKWALL, TEXAS

CONSTRUCTION PLANS FOR

SQUABBLE CREEK INTERCEPTOR REPLACEMENT

COUNCIL MEMBERS

BILL CECIL, MAYOR
BOB COTTI, MAYOR PRO-TEM
TIM MCCALLUM
STEPHEN STRAUGHAN
JOHN KING
MATT SCOTT
MARGO NIELSEN

CITY MANAGER

JULIE COUCH

ASSISTANT CITY MANAGER

RICHARD CROWLEY

CITY ENGINEER

CHUCK TODD, P.E.





BIRKHOFF, HENDRICKS & CONWAY, L.L.P.
CONSULTING ENGINEERS
Dallas, Texas

THESE DOCUMENTS ARE FOR
BIDDING, CONSTRUCTION,
AND PERMIT PURPOSES.

DATE: 01/12/06

JUNE, 2006

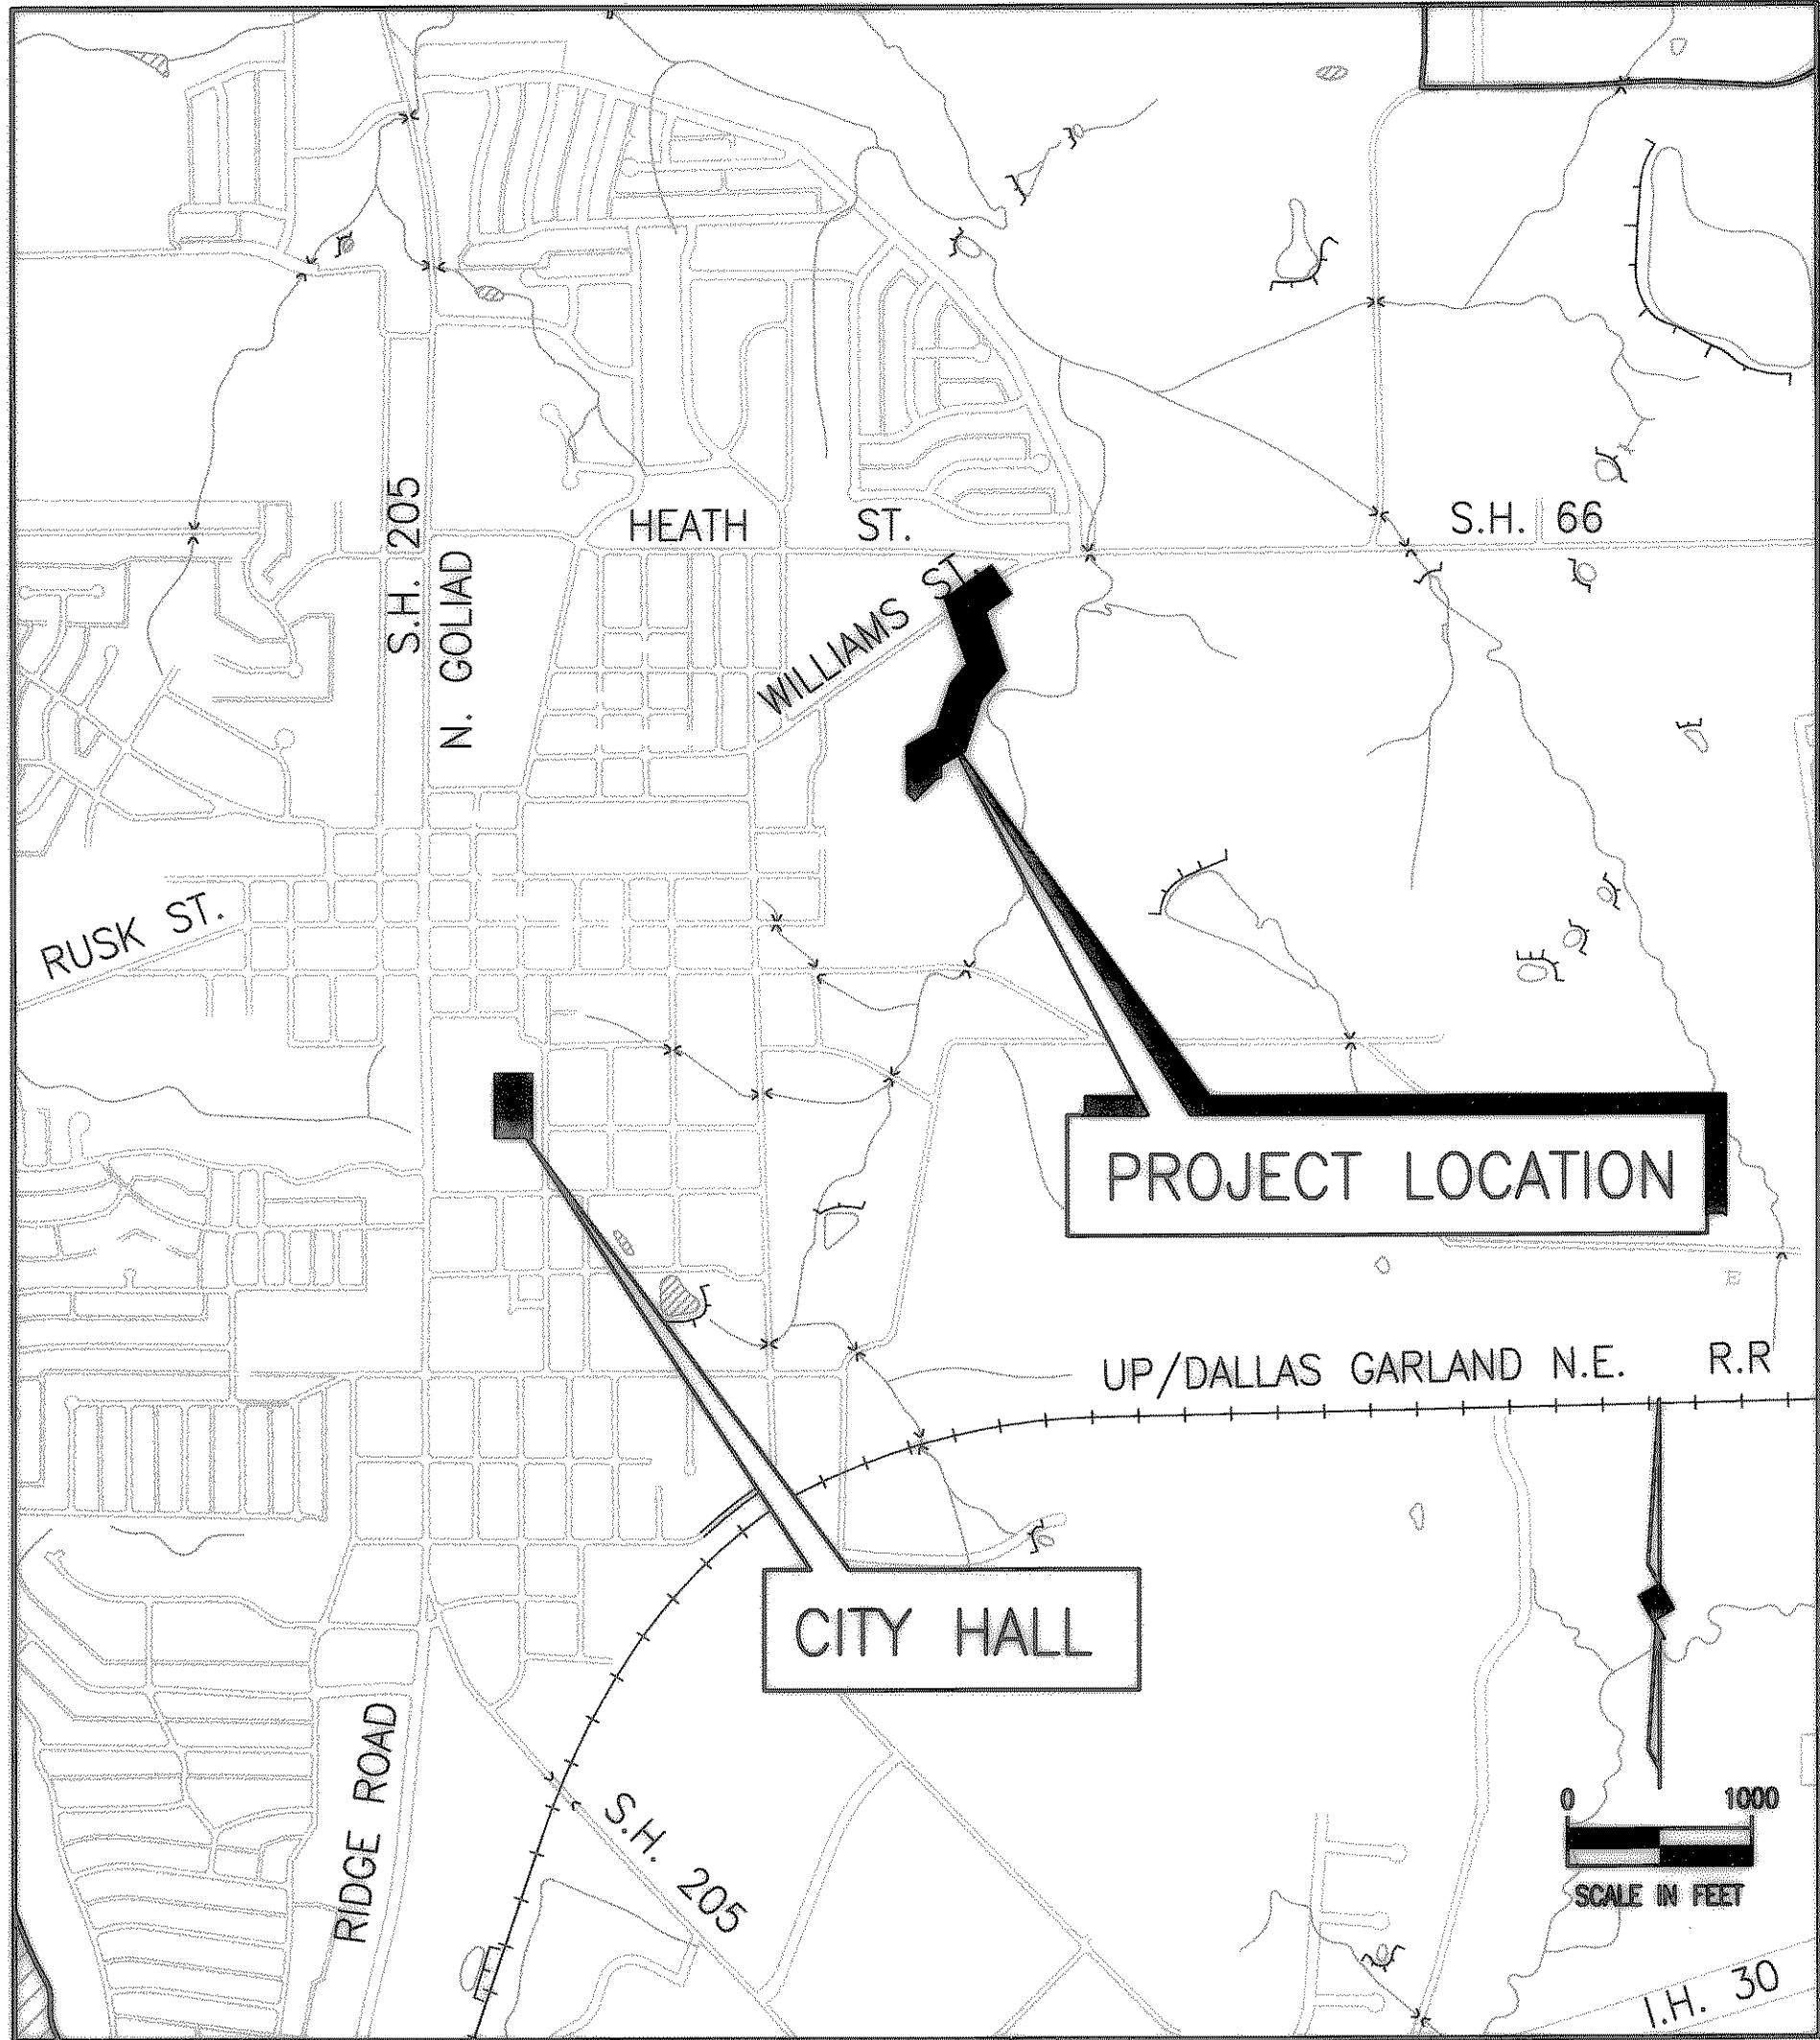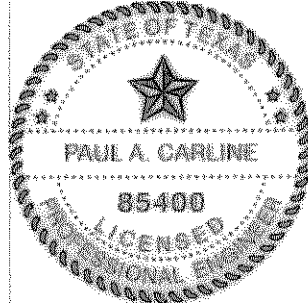

LOCATION MAP

SHEET INDEX

<u>SHEET NO.</u>	<u>SHEET DESCRIPTION</u>
1	COVER SHEET AND LOCATION MAP
2	STA. 0+00 TO STA. 5+00
3	PLAN - PROFILE STA. 5+00 TO STA. 10+00
4	PLAN - PROFILE STA. 10+00 TO STA. 14+10.18
5	PLAN - PROFILE STA. 0+00 TO STA. 1+47.42
6	MISCELLANEOUS DETAILS

This record drawing is a compilation of the sealed engineering drawing for this project; modified by addenda, change orders and information furnished by the contractor. The information shown on the record drawings that was provided by the contractor or others not associated with the design engineer cannot be verified for accuracy or completeness. This original sealed drawings are on file at the offices of Birkhoff, Hendricks & Conway, L.L.P.

BY PAC DATE 05/14/07