


CITY OF ROCKWALL, TEXAS

CONSTRUCTION PLANS FOR:

SQUABBLE CREEK LIFT STATION IMPROVEMENTS

PERMANENT BYPASS PUMPING STATION

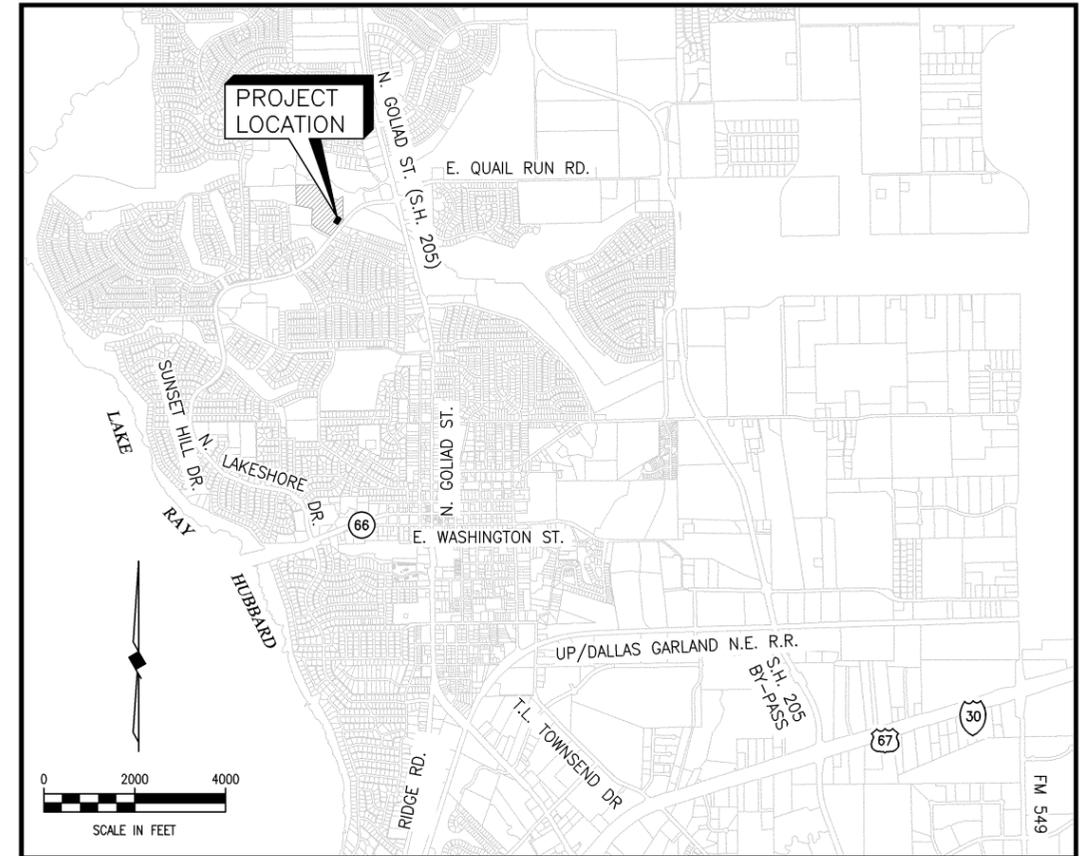

LOCATION MAP

COUNCIL MEMBERS

JIM PRUITT, MAYOR
JOHN HOHENSHELT, MAYOR PRO-TEM
MIKE TOWNSEND
KEVIN FOWLER
DENNIS LEWIS
DANA MACALIK
BENNIE DANIELS

CITY MANAGER

RICK CROWLEY

ASSISTANT CITY MANAGER

MARY SMITH
BRAD GRIGGS



BIRKHOFF, HENDRICKS & CARTER, L.L.P.

PROFESSIONAL ENGINEERS

Texas Firm 526
Dallas, Texas

May, 2018



Matthew Hickey
5/15/18

SHEET INDEX

SHEET NO.

SHEET DESCRIPTION

1	CITY OF ROCKWALL GENERAL CONSTRUCTION NOTES
2	BY-PASS PLAN & PROFILE
3	DETAILS & GENERAL NOTES
4A-4B	ACOUSTICAL ENCLOSURE DETAILS
5-6	ELECTRICAL/SCADA
7-9	STRUCTURAL SHEETS

THESE DOCUMENTS ARE FOR INTERIM REVIEW
AND ARE NOT INTENDED FOR CONSTRUCTION,
BIDDING, OR PERMIT PURPOSES.
MATTHEW HICKEY
TEXAS P.E. NO. 85480
DATE: November 2019

- GENERAL ITEMS**
- All construction shall conform to the requirements of the "Standard Specifications for Public Works Construction" by the North Texas Central Council of Governments, 4th edition amended by the City of Rockwall. The CONTRACTOR shall reference the latest City of Rockwall standard details provided in the Rockwall Public Works Department, Engineering Divisions "Standards of Design and Construction" manual for details not provided in these plans. The CONTRACTOR shall possess one set of the NCTCOG Standard Specifications and Details and the City of Rockwall's "Standards of Design and Construction" manual on the project site at all times.
 - The CONTRACTOR shall protect existing property monumentation and primary control. Any such points which the CONTRACTOR believes will be destroyed shall have offset points established by the CONTRACTOR prior to construction. Any monumentation destroyed by the CONTRACTOR shall be re-established at CONTRACTOR's expense by a registered professional land surveyor.
 - Any item called out for on the plans that does not have a specific bid item shall be subsidiary to the project and no separate pay shall be given.
 - The CONTRACTOR is solely responsible for performing all construction layouts from the site layout control points, and from the dimensions and centerlines shown. The CONTRACTOR must notify the engineer of any discrepancies before proceeding with the work.
 - CONTRACTOR shall take all available precautions to control dust. CONTRACTOR shall control dust by sprinkling water (no separate pay), or as approved by the City and engineer.
 - CONTRACTOR shall video record and provide a copy to the construction inspector of the entire job site before construction starts. Video record of the site will be used to dispute discrepancies of any preexisting conditions of the project site before construction begins.
 - It is the CONTRACTOR's responsibility to maintain a neat and accurate redline record of construction for the City's records. The CONTRACTOR shall provide the City full size reproducible markups that record all construction deviating from the plans. These redline construction plan records shall be submitted to the City at the end of the job and sign by the CONTRACTOR. These records must be received or the City will not release final retainage or acceptance on the job.

- EROSION CONTROL & VEGETATION**
- The CONTRACTOR or developer shall be responsible, as the entity exercising operational control, for all permitting as required by the Environmental Protection Agency (EPA) and the Texas Commission on Environmental Quality (TCEQ). This includes, but is not limited to, preparation of the Storm Water Pollution Prevention Plan (SWPPP), the Construction Site Notice (CSN), the Notice of Intent (NOI), the Notice of Termination (NOT) and any Notice of Change (NOC) and is required to pay all associated fees.
 - Erosion control devices as shown on the erosion control plan for the project shall be installed prior to the start of land disturbing activities.
 - All erosion control devices are to be installed in accordance with the approved plans, specifications and Storm Water Pollution Prevention Plan (SWPPP) for the project. Erosion control devices shall be placed and in working order prior to start of construction. Changes are to be reviewed by the design engineer and the City of Rockwall prior to implementation.
 - If the Erosion Control Plans and Storm Water Pollution Prevention Plan (SWPPP) as approved cannot appropriately control erosion and off-site sedimentation from the project, the erosion control plan and/or the SWPPP is required to be revised and any changes reported to the Texas Commission on Environmental Quality (TCEQ), when applicable.
 - All erosion control devices shall be inspected weekly by the CONTRACTOR and after all major rain events, or more frequently as dictated in the project Storm Water Pollution Prevention Plan (SWPPP). CONTRACTOR shall provide copies of inspection reports to the engineering inspection after each inspection.
 - The CONTRACTOR shall not dispose of waste and any materials into streams, waterways or floodplains. The CONTRACTOR shall secure all excavation at the end of each day and dispose of all excess materials. Disposal site shall be documented and provided to the City.
 - CONTRACTOR shall grade ground and ditches disturbed by construction to prevent ponding of storm water runoff. Grading shall be subsidiary to the appropriate bid item for unclassified street and unclassified channel excavation. Topsoil shall be stockpiled and replaced to a minimum depth of 6-inches and disc harrowed to a minimum depth of 4-inches (no pay item). CONTRACTOR shall replace grass areas disturbed by construction activities with solid sod. Sodded areas shall be watered and maintained until established.
 - The CONTRACTOR shall provide 4 inches of top soil in all parkways that are to be sodded. Top soil shall be approved by the City in writing. Topsoil shall be subsidiary to placement of grass/sod.
 - All areas outside pavement disturbed by construction activities shall have grass sod established immediately. Sod shall match existing yard type. Payment shall be made under the appropriate bid schedule item. Areas disturbed outside the R.O.W. or limits of construction shall have grass sod established immediately at the CONTRACTOR's expense.

GENERAL CONSTRUCTION NOTES
May 1, 2017

**CITY OF ROCKWALL
PUBLIC WORKS DEPARTMENT
ENGINEERING DIVISION**

385 S. Goliad P (972) 771-7746
Rockwall, Texas 75087 F (972) 771-7748



- FRANCHISE UTILITY NOTES**
- Reasonable effort has been made to show the location of all known underground utilities and service lines. However, the owner assumes no responsibility for failure to show any or all existing subsurface franchise utilities or utility line, or to show them in their exact location. The CONTRACTOR shall be responsible for the protection of all existing utilities, service lines or the like, which are exposed by the construction operation.
 - Existing franchise utilities shown in these plans reflect approximate locations prior to relocations. Some relocations have occurred with utility pole, gas, phone and cable utilities. The CONTRACTOR shall contact Dig-Tess to locate existing and new utilities not shown in these plans.
 - CONTRACTOR shall support utilities where crossing with proposed storm sewer, water lines and sanitary sewers. Method of support shall be provided to the owner 24 hours prior to crossing.
 - The location off all Atmos gas lines, AT&T, Charter and TXU/Oncor electric underground phone lines in these plans are approximate. The CONTRACTOR shall contact Atmos, TXU/Oncor, AT&T and Charter to verify location and depth of all existing gas, electric and phone lines prior to construction.
 - CONTRACTOR shall have and pay for TXU/Oncor, AT&T and/or Charter support and protect all power, guy wires or cable and/or light poles in the work area.
 - Any damage incurred to existing franchise utilities, appurtenances, utility poles, light standards, etc. By construction related activities shall be the sole responsibility of the CONTRACTOR.

- TRAFFIC CONTROL**
- A suggested traffic control sequence plan is provided in the plan set. At a minimum the CONTRACTOR will be required to use the suggested sequence plan. If the CONTRACTOR chooses to change the traffic control sequencing, a traffic control sequencing plan and traffic control sheets of each phase will have to be provided for review and approval by the City. All shall be signed and sealed by a Registered Professional Engineer with the State of Texas.
 - Pedestrian and vehicular traffic flow, safety and access shall be maintained during all phases of construction. Barricading and traffic control during construction shall be the responsibility of the CONTRACTOR and shall conform to the "Texas Manual on Uniform Traffic Control Devices", latest edition, Part IV in particular. Traffic flow and access shall be maintained during all phases of construction unless otherwise noted on the traffic control plan. The CONTRACTOR is responsible for providing traffic safety measures for work on the project. The CONTRACTOR shall assume full responsibility for public safety in the construction area during the duration of construction activities.
 - The CONTRACTOR shall furnish, install, maintain and remove all necessary traffic control devices in conformance with the Texas Manual on Uniform Traffic Control Devices (Part 6). The CONTRACTOR shall provide access to properties at all times during each phase of construction to all local residents, businesses, mail service, trash pick-up and emergency services.
 - No traffic signs shall be taken down without permission from the City. CONTRACTOR needing to move and replace traffic sign for construction purposes should be paid for under traffic control bid item.
 - CONTRACTOR will furnish and install all signage in accordance with TMUTCD guidelines. Prior to installation of signage, CONTRACTOR shall stake locations and receive approval from City on locations. All signage that is removed by the CONTRACTOR shall be saved and delivered to municipal service center, streets division. All replaced signs shall be new. See City requirements for sign materials.

- MAILBOXES, MAIL SERVICE AND TRASH SERVICE NOTES**
- Existing mailboxes in conflict with construction shall be taken out of service, removed and replace to the same or better condition and placed in a location approved by the city/property owner. Photographs of the mailbox shall be taken with the address shown, shall be provided to the city prior to being removed.
 - Temporary mailbox shall be provided and maintained throughout the project where existing mail boxes are being removed. Addresses shall be provided on all temporary mail boxes.
 - Payment for removal and replacement of existing mailbox will be paid for under the appropriate bid item. Brick mailbox shall match existing brick.
 - Trash service shall be maintained throughout the duration of construction.

- FENCES, TREES, LANDSCAPING, AND IRRIGATION NOTES**
- The removal, replacement or reconstruction of any fence for the convenience of construction shall be at the CONTRACTOR's expense (no separate pay). New materials shall match existing fences. All wood fences shall be replaced with new cedar with the post matching City requirements.
 - Temporary fencing shall be required where there is evidence of livestock and where damaged or removed fences are not to be replaced by the end of the same work day.
 - The removal and replacement of all shrubs, plants, trees, etc. For the convenience of construction shall be at the CONTRACTOR's expense (no separate pay). New shrubs, tree, etc. Shall be equal to or better than existing ones or meet
 - All shrubs, plants, trees, etc. must be approved by the City before removal.
 - The CONTRACTOR shall locate and record existing irrigation systems prior to construction. If irrigations systems are damaged during construction the CONTRACTOR shall repair to same or better condition. An irrigator licensed in the state of Texas shall repair all damaged caused by construction. CONTRACTOR shall coordinate any irrigation work with the City of Rockwall and property owner's representatives.
 - CONTRACTOR shall replace any trees removed or destroyed that are not shown in these plans to be removed or shall pay fair market value to the owner as determined by the owner. (No Separate Pay).

- UTILITY NOTES**
- Reasonable effort has been made to show the location and type of all known City of Rockwall underground wet utilities and service lines. However, the City of Rockwall assumes no responsibility for failure to show any or all existing City of Rockwall underground wet utilities and service lines, or to show them in their exact location. The CONTRACTOR shall be responsible for the protection of all existing utilities, service lines or the like, which are exposed by the construction operation.
 - Bidders shall make any investigation of existing subsurface conditions as deemed necessary at no expense to the City of Rockwall. Neither the City of Rockwall nor the engineer will be responsible in any way for additional compensation for excavation work performed under this contract due to the CONTRACTOR's assumptions.
 - CONTRACTOR shall adjust all City of Rockwall utilities to the final grades.
 - CONTRACTOR shall be responsible for the protection of all existing service lines crossed or exposed by construction operations. Where existing service lines are cut, broken or damaged, the CONTRACTOR shall immediately replace the service line with same type of original construction or better.
 - The CONTRACTOR shall excavate and field locate the horizontal and vertical location of existing utility crossing locations utilizing provided project control. The CONTRACTOR shall immediately notify the engineer of any discrepancies identified between the CONTRACTOR's field verified existing utility location and proposed location of utilities for the project.
 - The CONTRACTOR shall abide by all applicable federal, state, and local laws governing excavation. The CONTRACTOR shall provide detailed plans and specifications for trench safety systems that comply with applicable laws governing excavation. These plans shall be sealed by an engineer experienced in the design of trench safety systems, registered in the state of Texas. The CONTRACTOR shall submit completed trench safety plan to the engineer and City prior to commencing work. The CONTRACTOR shall be solely responsible for all aspects of work related to excavation.

- WATER LINE NOTES**
- The CONTRACTOR shall maintain existing water service at all times during construction.
 - Proposed water lines shall be AWWA C-900 PVC, DR 14 PC 305 (blue in color) unless otherwise shown on water plan and profiles sheets. Proposed water lines shall be constructed with minimum cover of 4 feet. Proposed water line embedment shall be NCTCOG Class 'B-3' as amended by the City of Rockwall's public works standards of design and construction manual.
 - CONTRACTOR shall coordinate the shutting down of all water lines with the City of Rockwall, public works, water division. The City shall operate all water valves.
 - CONTRACTOR shall furnish and install gasket on water lines between all dissimilar metals and at valves (both existing and proposed).
 - All fire hydrants and valves removed and salvaged shall be returned to the City of Rockwall municipal service center.
 - Blue EMS pads shall be installed at every change in direction, valve and service tap on the proposed water line and every 250'.
 - CONTRACTOR to install new meter boxes and all fittings except for the meters per each service complete including connection to the main line.
 - Existing meter and meter boxes, and valve stem and covers not specifically called to be relocated shall be adjusted to match final grades (no pay item). Any meter in pavement shall have a traffic rated lid.

- WASTEWATER LINE NOTES**
- The CONTRACTOR shall maintain existing wastewater service at all times during construction.
 - Proposed wastewater line embedment shall be NCTCOG Class 'B-2' as amended by the City of Rockwall's public works standard design and construction manual.
 - Green EMS pads shall be installed at every manhole, clean out and service lateral on proposed wastewater lines.
 - All existing wastewater services shall be transferred from wastewater lines being abandoned to proposed wastewater lines. Transferring wastewater services shall include double clean outs at the property lines, caps, tees, wyes, plugs and connection. Payment for transferring wastewater services shall be paid per each, under the appropriate bid schedule item.
 - CONTRACTOR shall CCTV all existing wastewater lines that are to be abandoned to ensure that all laterals are accounted for and transferred to proposed wastewater lines. (no separate pay)
 - Existing manholes and cleanouts not specifically called to be relocated shall be adjusted to match final grades (no pay item).


- DEMOLITION, REMOVAL, DISPOSAL AND EXCAVATION NOTES**
- CONTRACTOR shall remove and properly dispose of all existing concrete and HMA pavement outside of the City limits as required for construction of the project. All cost shall be included in the appropriate item in the bid schedule. Payments for removal and replacement of street, driveway and sidewalk pavement shall be based on plan quantity and no adjustments will be made unless approved in writing by the City engineer.
 - All pavements to be removed and replaced shall be saw cut to full depth along neat lines shown in the plans. Proposed concrete pavement shall be constructed with longitudinal butt construction joints at all connections to existing concrete pavement.
 - The CONTRACTOR shall remove from the project area all surplus material. This work shall be incidental and not a separate pay item. Surplus materials from excavation include dirt, trash, rock measuring greater than 6" in the largest dimension, etc. Shall be properly disposed of at a site acceptable to the City of Rockwall if within the City limits. No excess excavated material shall be deposited in low areas or along natural drainage ways without written permission from the affected property owner and the City of Rockwall. If the CONTRACTOR places excess materials in these areas without written permission, he will be responsible for all damages resulting from such fill and he shall remove the material at his own cost.
 - All excavation on the project is unclassified. If soil borings were conducted they are provided in the bid/contract documents.

- PAVING**
- All paving roadway sections thickness, strength, reinforcement, joint type, joint spacing and subgrade treatment shall match the typical sections and details called out in the plans. If not called out on the plans all concrete paving shall conform to the minimum requirements of table 2.3 in the Standards of Design and Construction.
 - Reinforcing steel shall be tied (100%). Reinforcing steel shall be set on plastic chairs. Bar laps shall be minimum 30 diameters. Sawn transverse dummy joints shall be spaced every 15 feet or 1.25 time longitudinal butt joint spacing whichever is less. Sawing shall occur within 5 to 12 hours after the pour, including sealing. Otherwise, the section shall be removed and longitudinal butt joint constructed.
 - All proposed HMA street pavement shall consist of 4 inches of Type B (Base) with 2 inches of Type D (Surface) on top of 6" flex base (if not specified in the plans)
 - No sand shall be allowed under any paving.
 - Concrete mix design shall be submitted to the City for review and approval prior to placement.
 - Fly ash may be used in concrete pavement locations provided that the maximum cement reduction does not exceed 20% by weight per C.Y. of concrete. The fly ash replacement shall be 1.25 lbs per 1.0 lb cement reduction.
 - All curb and gutter shall be integral (monolithic) with the pavement.
 - All fill shall be compacted by sheep's foot roller to a minimum 95% standard proctor. Maximum loose lift for compaction shall be 8 inches. All lifts shall be tested for density by an independent laboratory approved by the City.
 - All proposed sidewalks shall include barrier free ramps at intersecting streets, alleys, etc. Barrier free ramps shall meet current City and ADA requirements and be approved by the Texas Department of Licensing and Regulation (TDLR).
 - Sidewalks shall be doveled into pavement where it abuts curbs and driveways. Expansion joint material shall be used at these locations (no pay item).
 - All connection of proposed concrete pavement to existing concrete pavement shall include a longitudinal butt joint as the load transfer device. Concrete saw cuts for all driveways and sidewalks shall be subsidiary to the appropriate bid item for driveway and sidewalk replacement. All longitudinal butt joints shall be clean, straight and smooth (not jagged in appearance)
 - There shall be no separate payment for subgrade preparation under driveway and sidewalk areas and all cost shall be included in the appropriate items of the bid schedule.
 - Cracks formed in concrete pavement shall be repaired or removed by the CONTRACTOR at the City's discretion.

- DRAINAGE / STORM SEWER NOTES**
- The CONTRACTOR shall maintain drainage at all times during construction. Ponding of water in streets, drives, trenches, etc. will not be allowed. Existing drainage ways shall not be blocked or removed unless explicitly stated in the plans or written approval is given by the City.
 - All structural concrete shall be Class "C" (4200 psi compressive strength at 28 days minimum 7.0 sack), air entrained, unless noted otherwise.
 - Proposed storm sewer embedment shall be NCTCOG Class 'B' as amended by the City of Rockwall's Public Works, Engineering Division Standards of Design and Construction Manual.
 - All storm pipe shall be reinforced concrete pipe (RCP), Class III, unless otherwise noted.

THESE DOCUMENTS ARE FOR INTERIM REVIEW AND ARE NOT INTENDED FOR CONSTRUCTION, BIDDING, OR PERMIT PURPOSES.

MATTHEW HICKEY
TEXAS P.E. NO. 85480
DATE: November 2019

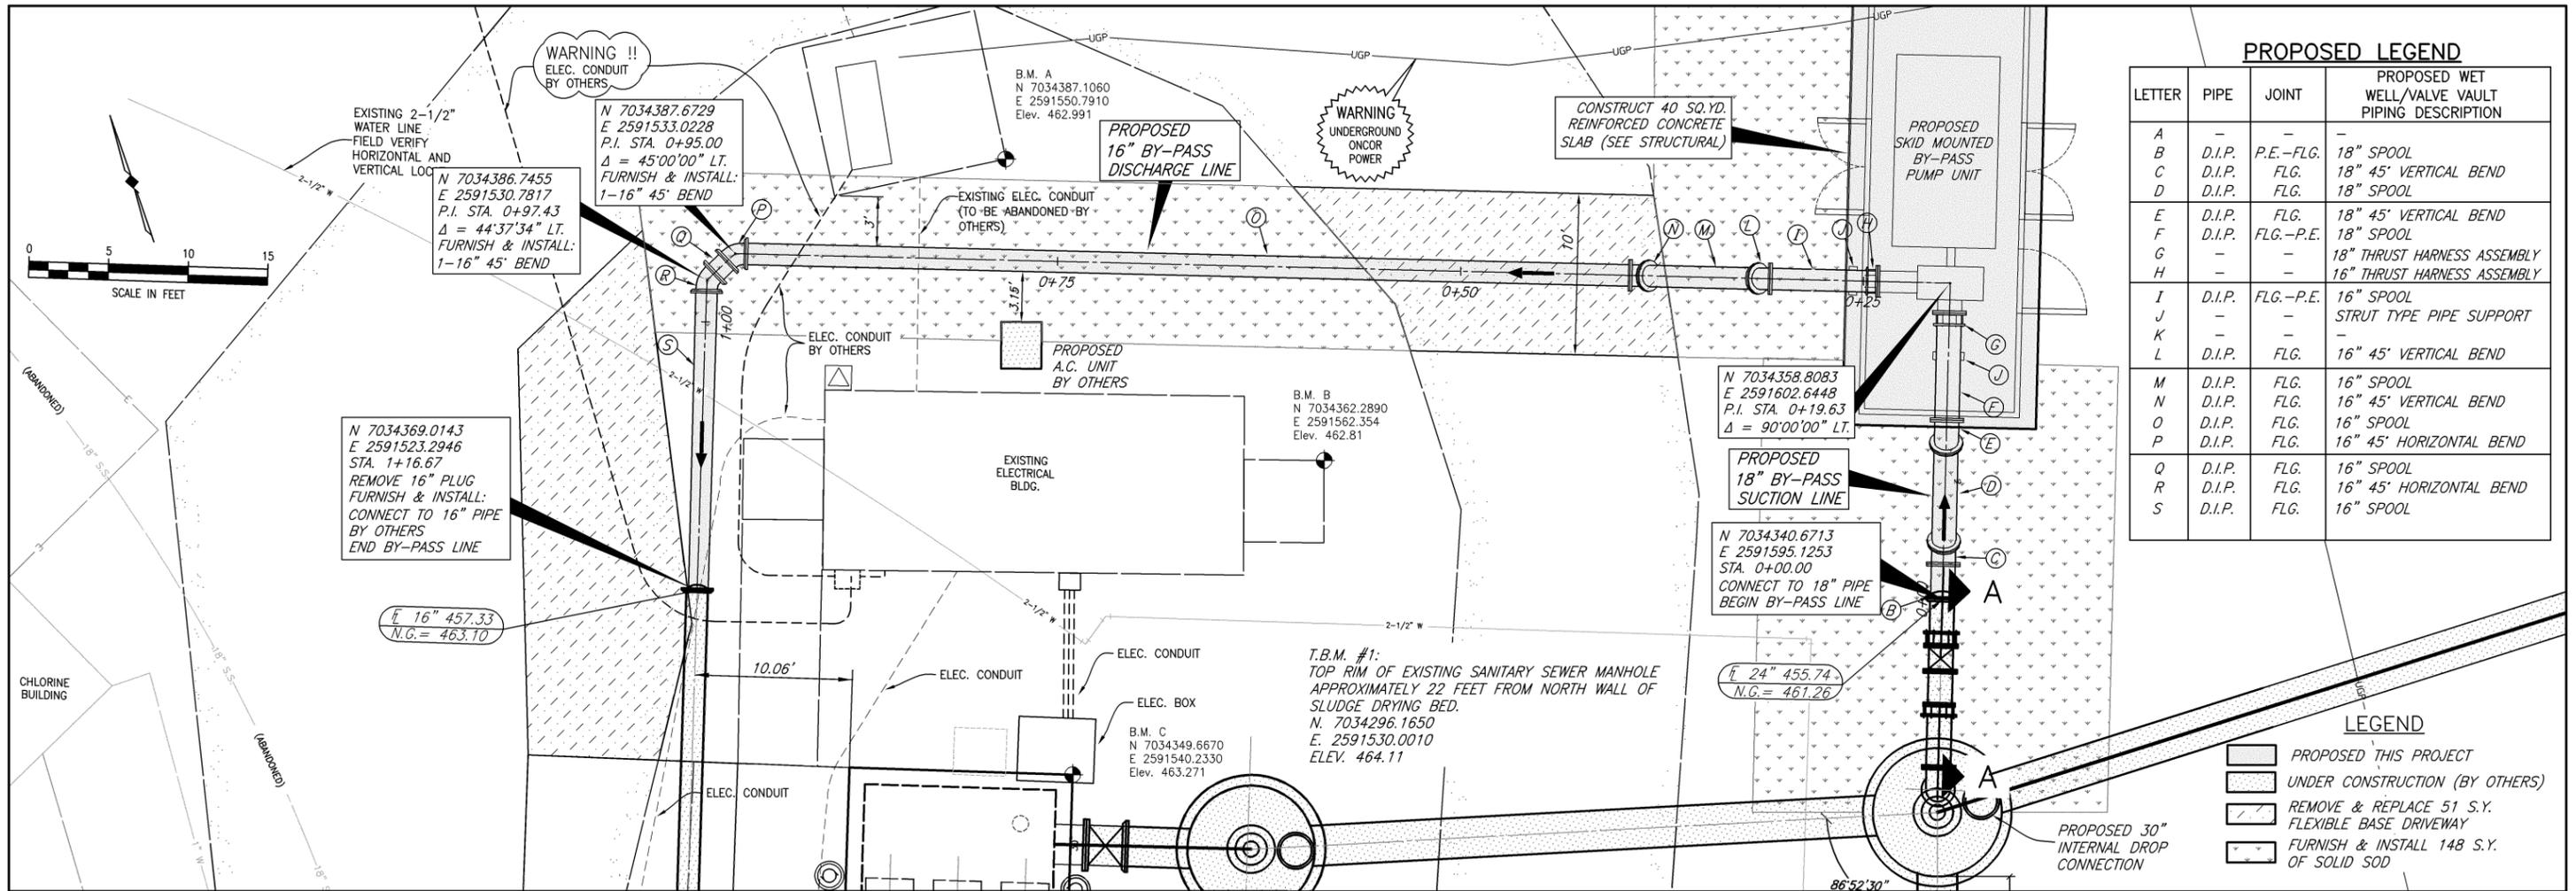


PROPOSED LEGEND

LETTER	PIPE	JOINT	PROPOSED WET WELL/VALVE VAULT PIPING DESCRIPTION
A	-	-	-
B	D.I.P.	P.E.-FLG.	18" SPOOL
C	D.I.P.	FLG.	18" 45' VERTICAL BEND
D	D.I.P.	FLG.	18" SPOOL
E	D.I.P.	FLG.	18" 45' VERTICAL BEND
F	D.I.P.	FLG.-P.E.	18" SPOOL
G	-	-	18" THRUST HARNESS ASSEMBLY
H	-	-	16" THRUST HARNESS ASSEMBLY
I	D.I.P.	FLG.-P.E.	16" SPOOL
J	-	-	STRUT TYPE PIPE SUPPORT
K	-	-	-
L	D.I.P.	FLG.	16" 45' VERTICAL BEND
M	D.I.P.	FLG.	16" SPOOL
N	D.I.P.	FLG.	16" 45' VERTICAL BEND
O	D.I.P.	FLG.	16" SPOOL
P	D.I.P.	FLG.	16" 45' HORIZONTAL BEND
Q	D.I.P.	FLG.	16" SPOOL
R	D.I.P.	FLG.	16" 45' HORIZONTAL BEND
S	D.I.P.	FLG.	16" SPOOL

LEGEND

	PROPOSED THIS PROJECT
	UNDER CONSTRUCTION (BY OTHERS)
	REMOVE & REPLACE 51 S.Y. FLEXIBLE BASE DRIVEWAY
	FURNISH & INSTALL 148 S.Y. OF SOLID SOD

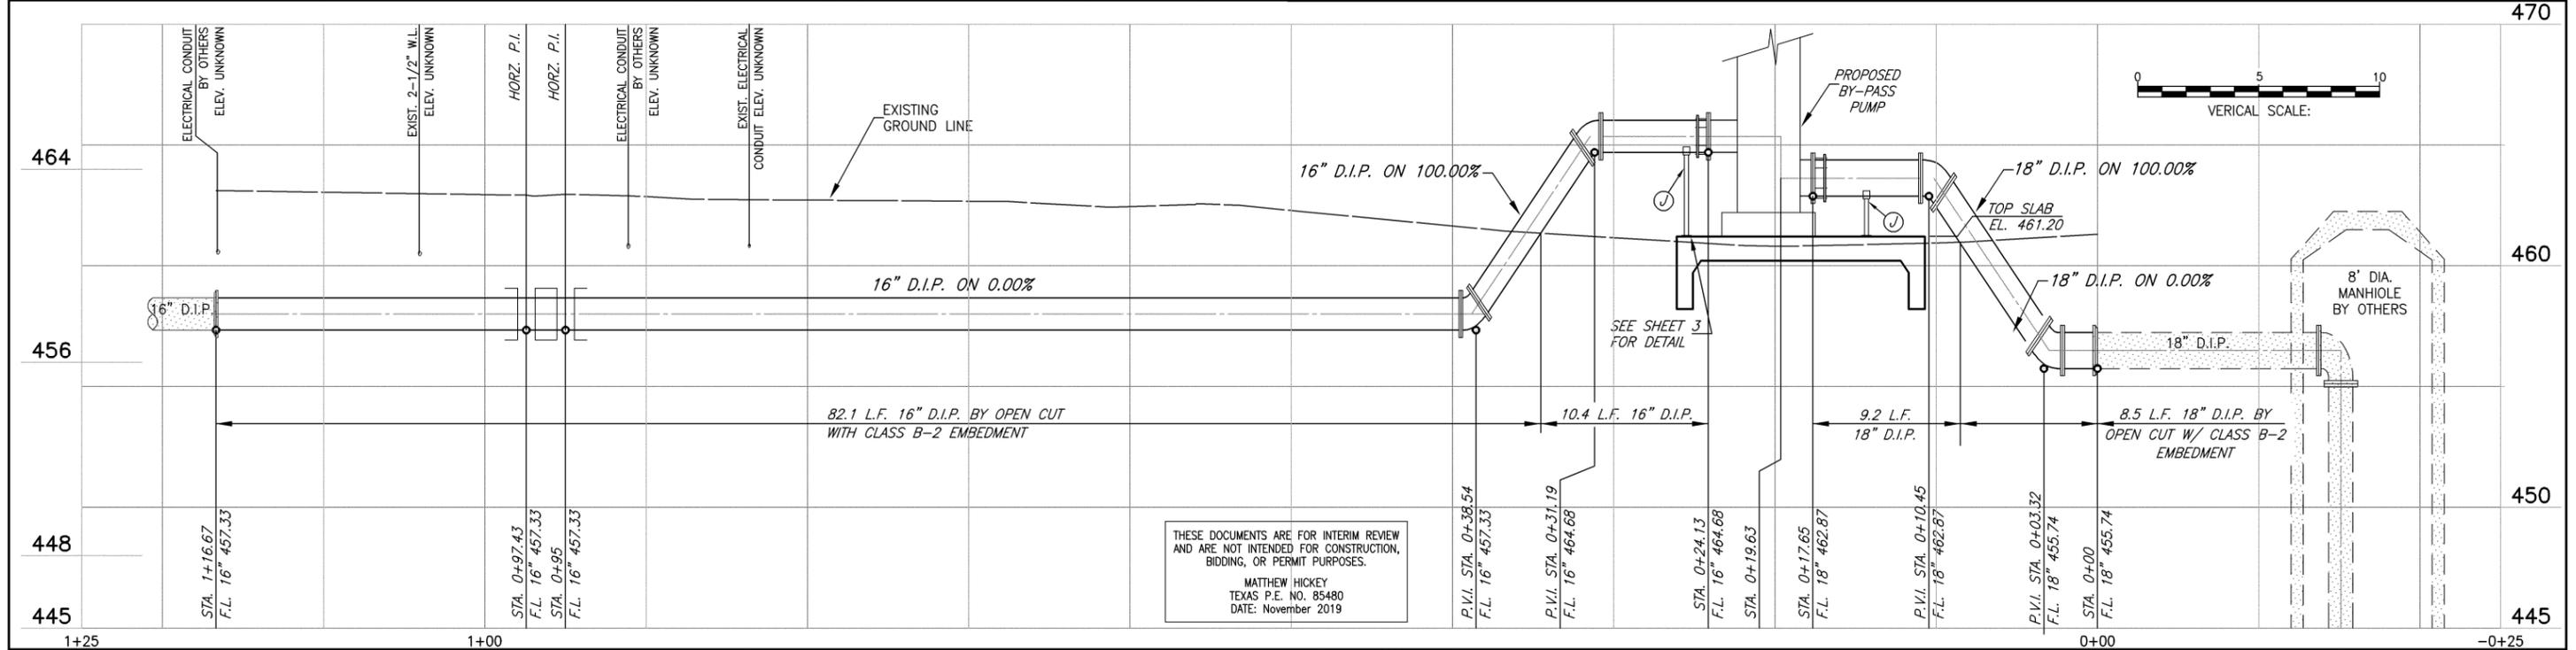

THESE DOCUMENTS ARE FOR INTERIM REVIEW AND ARE NOT INTENDED FOR CONSTRUCTION, BIDDING, OR PERMIT PURPOSES.

MATTHEW HICKEY
 TEXAS P.E. NO. 85480
 DATE: November 2019


<p>These plans and related specifications were prepared for construction of this specific project only. Reuse of these documents is not permitted without written authorization of Birkhoff, Hendricks & Carter, L.L.P. If this drawing is converted to an electronic file, any discrepancy occurs between the electronic file and the Birkhoff, Hendricks & Carter, L.L.P. original document, the original document will govern in all cases.</p>	<p>BIRKHOFF, HENDRICKS & CARTER, L.L.P. PROFESSIONAL ENGINEERS Texas Firm F526 11910 Greenville Ave., Suite 600 Dallas, Texas 75243 (214) 361-7900</p>		<p><i>Matthew Hickey</i> 5/15/14</p>	<p>CITY OF ROCKWALL, TEXAS SQUABLE CREEK LIFT STATION IMPROVEMENTS FORCE MAIN & BY-PASS PIPING MODIFICATION PLAN</p>	<p>BHC PROJECT NO. 2015-144 May, 2018</p>	<p>SHEET NO. 2</p>
--	---	--	---	---	--	--------------------------------

3 LEGEND

20' LONG x 9' WIDE x 4" TALL SPILL CONTAINMENT

3 NOTES:

1. THE SPILL CONTAINMENT DEVICE SHALL BE PLACED ON THE CONCRETE FLOOR INSIDE THE ACOUSTICAL ENCLOSURE BUILDING WITH THE SKID MOUNTED BYPASS UNIT PLACED ON TOP. PENETRATIONS THROUGH THE CONTAINMENT FLOOR FOR THE SKID MOUNTINGS TO THE FOUNDATION SHALL BE SEALED WITH "WELD-ON" 790 MULTI PURPOSE P.V.C. ADHESIVE CEMENT FOR A LIQUID TIGHT SEAL.
2. THE SPILL CONTAINMENT DEVICE SHALL BE THE ULTRA-CONTAINMENT BERM FOAM WALL MODEL CONSTRUCTED OF COPOLYMER 2000 MATERIAL BY ULTRATECH INTERNATIONAL, INC. CONTACT DOUG KAHLE OF RITZ SAFETY, LLC, DALLAS, TEXAS, AT 1-800-527-9289

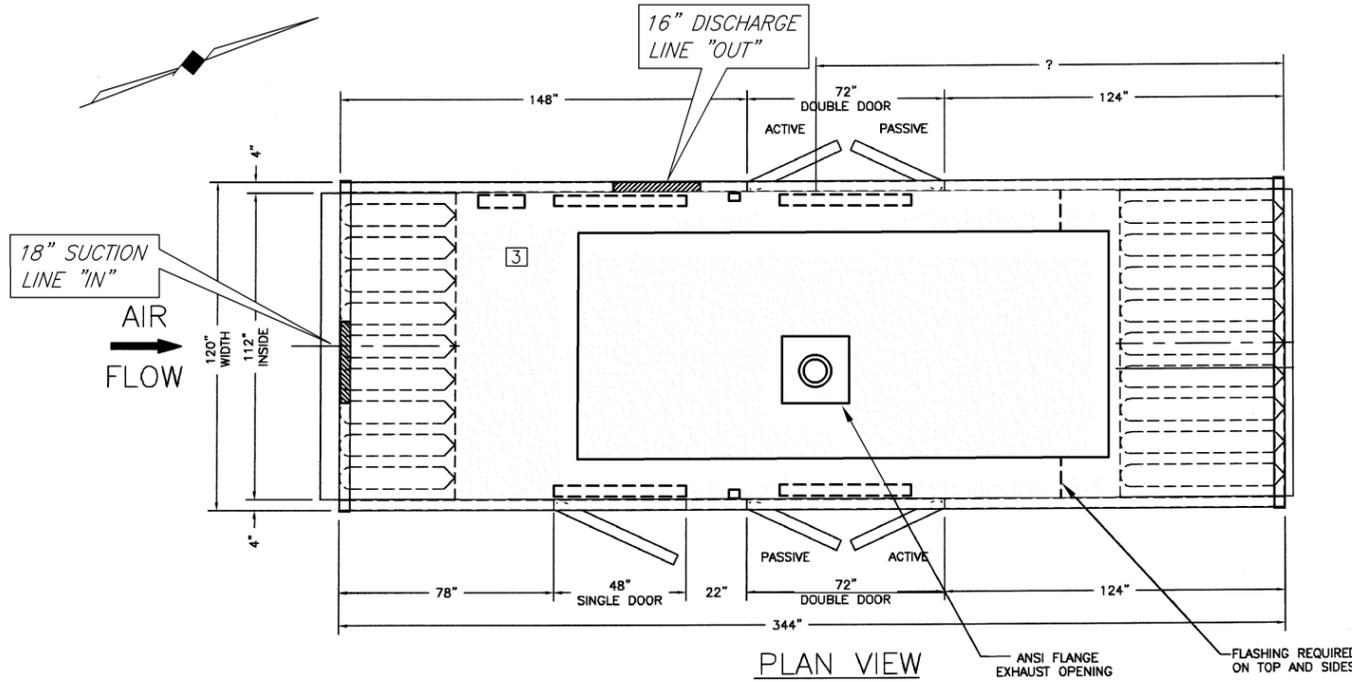

NOTES: ENCLOSURE ASSEMBLY:

- * FULLY ASSEMBLED DROP OVER ENCLOSURE TO BE ANCHORED TO THE FOUNDATION.
- * PANEL JOINTS ARE SKIP WELDED AND CAULKED.

ENCLOSURE CONSTRUCTION:

- * WALLS AND ROOF - 14 GAUGE GALVANNEALED STEEL.
- * FRAME CONSTRUCTION - A36 STRUCTURAL CHANNEL & A-500 TUBING.
- * INNER LINER - PERFORATED GALVANNEALED STEEL.
- * INSULATION - MINERAL WOOL AND POLY LINER.
- * DOORS - ONE (1) SINGLE & TWO (2) DOUBLE ACCESS SERVICE DOORS. SERVICE DOORS WITH STAINLESS STEEL HINGE AND DOOR LATCHES.
- * BAFFLES - 42" DEEP INLET & 60" DEEP DISCHARGE PANELS, GALVANNEALED CONSTRUCTION.
- * LOUVERS - FIXED INLET WEATHER LOUVERS W/BIRDSCREEN, GALVANNEALED CONSTRUCTION.
- * DISCHARGE GRAVITY BACKDRAFT DAMPERS, ALUMINUM CONSTRUCTION.
- * BOLTING HARDWARE - STAINLESS STEEL.

DESIGN SPECIFICATIONS:

- * DESIGNED TO REDUCE THE AIRBORNE GEN-SET EQUIPMENT NOISE LEVELS TO 60 dB(A) WHEN MEASURED AT A DISTANCE OF 25 FEET FROM THE ENCLOSURE AND 5 1/2 FEET ABOVE GRADE IN A FREE FIELD ENVIRONMENT.
- * THE GEN-SET EQUIPMENT NOISE DOESN'T EXCEED 119 dB.
- * BASED ON A TOTAL AIR REQUIREMENT OF 37,949 CFM AT LESS THAN 1/2" W.G. BACK PRESSURE THROUGH THE ENCLOSURE.
- * ENGINE EXHAUST IS NOT INCLUDED.

PAINTING:


- * ALL EXTERIOR GALVANNEALED SURFACES TO BE SOLVENT CLEANED PER SSPC-SP1 AND PAINTED AS FOLLOWS:
INTERMEDIATE - ONE COAT INDUSTRIAL POLYURETHANE (1-1.5 MILS DFT)
FINISH - ONE COAT INDUSTRIAL POLYURETHANE (.5-1 MILS DFT)
- * ALL CARBON STEEL SURFACES TO BE POWER TOOL CLEANED PER SSPC-SP3 AND PAINTED AS FOLLOWS:
PRIMER - ONE COAT INDUSTRIAL PRIMER (2-4 MILS DFT)
FINISH - ONE COAT INDUSTRIAL POLYURETHANE (2-4 MILS DFT)
- * COLOR - PRECISION TAN.

ELECTRICAL:

- * SEE DRAWING

ENCLOSURE SHIPPING SIZE & WEIGHT:

- * SIZE - 358" L x 149" W x 140" H
- * WEIGHT - 19,000 LBS.

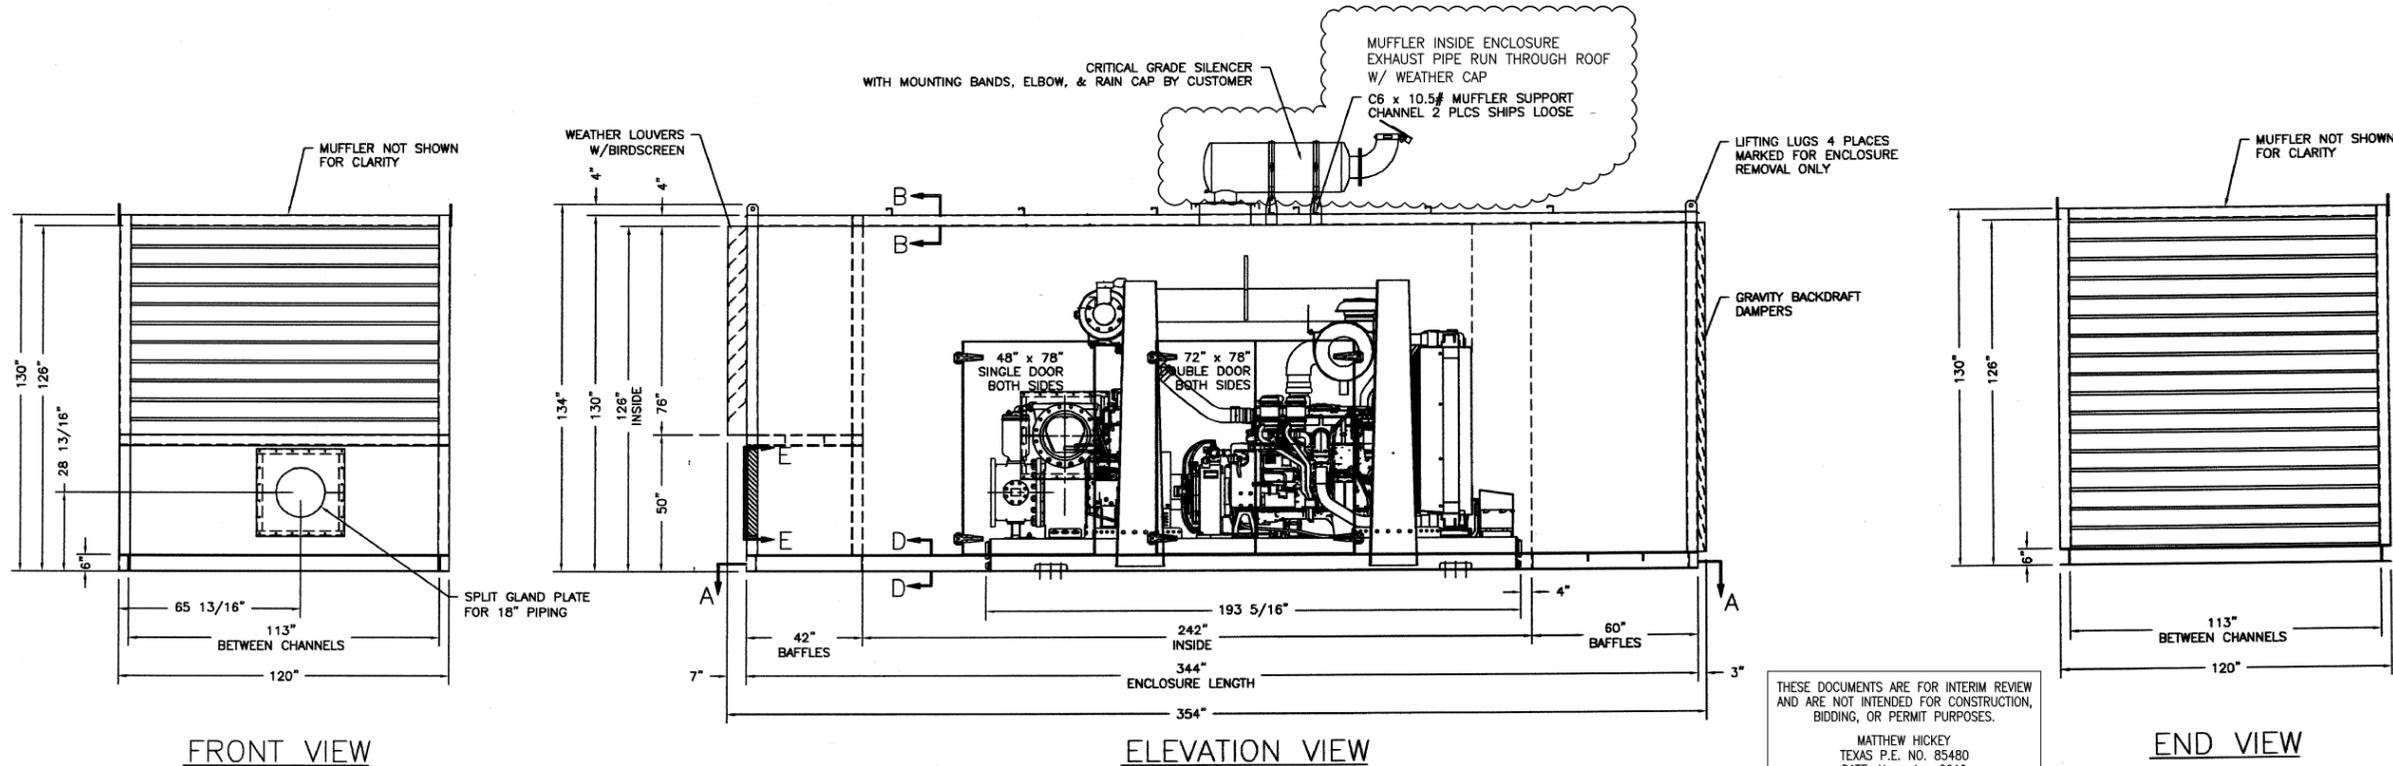

THESE DOCUMENTS ARE FOR INTERIM REVIEW AND ARE NOT INTENDED FOR CONSTRUCTION, BIDDING, OR PERMIT PURPOSES.
MATTHEW HICKEY
TEXAS P.E. NO. 85480
DATE: November 2019

3 ADDED SPILL CONTAINMENT (06/22/2018)

These plans and related specifications were prepared for construction of this specific project only. Reuse of these documents is not permitted without written authorization of Birkhoff, Hendricks & Carter, L.L.P. If this drawing is converted to an electronic file, if any discrepancy occurs between the electronic file and the Birkhoff, Hendricks & Carter, L.L.P. original document, the original document will govern in all cases.

BIRKHOFF, HENDRICKS & CARTER, L.L.P.
PROFESSIONAL ENGINEERS
TBPE Firm No. 526; TBPLS Firm No. 10031800
11910 Greenville Ave., Suite 600
Dallas, Texas 75243 (214) 361-7900



Matthew Hickey
6/22/18





CITY OF ROCKWALL, TEXAS
SQUABBLE CREEK LIFT STATION IMPROVEMENTS
BY-PASS PUMP - ACOUSTICAL ENCLOSURE

BHC
PROJECT NO.
2015-144


May, 2018

SHEET NO.


4A

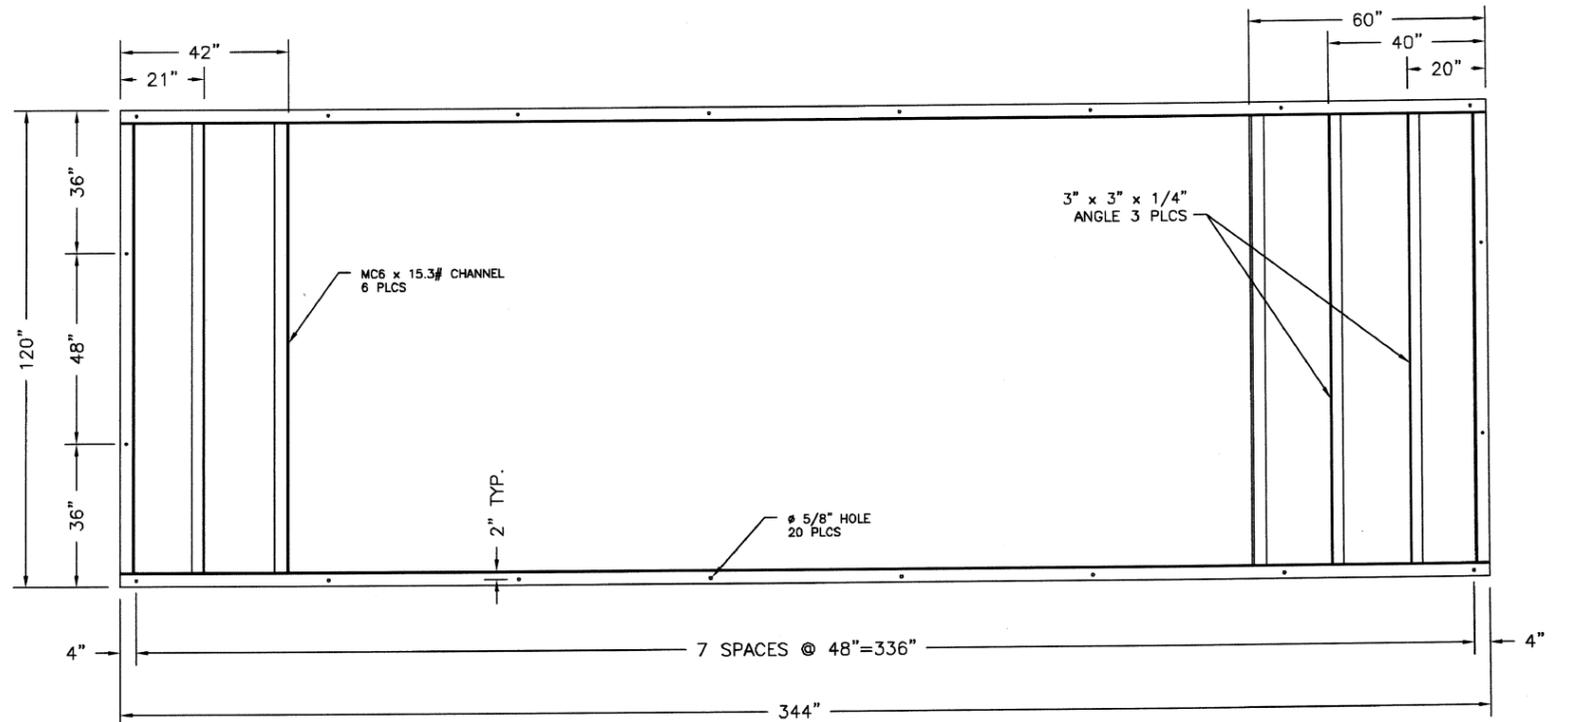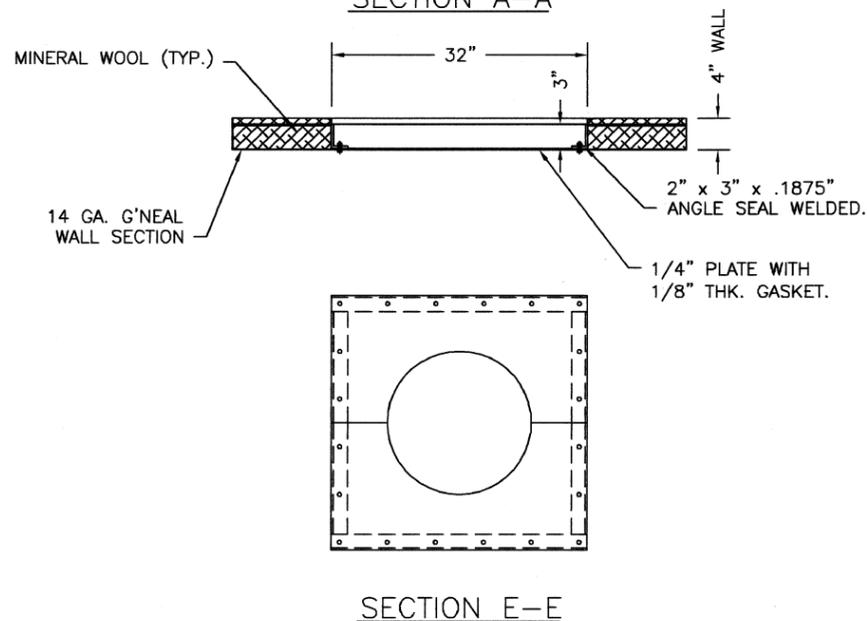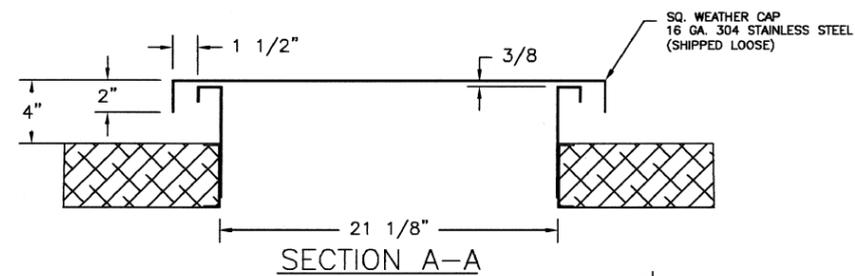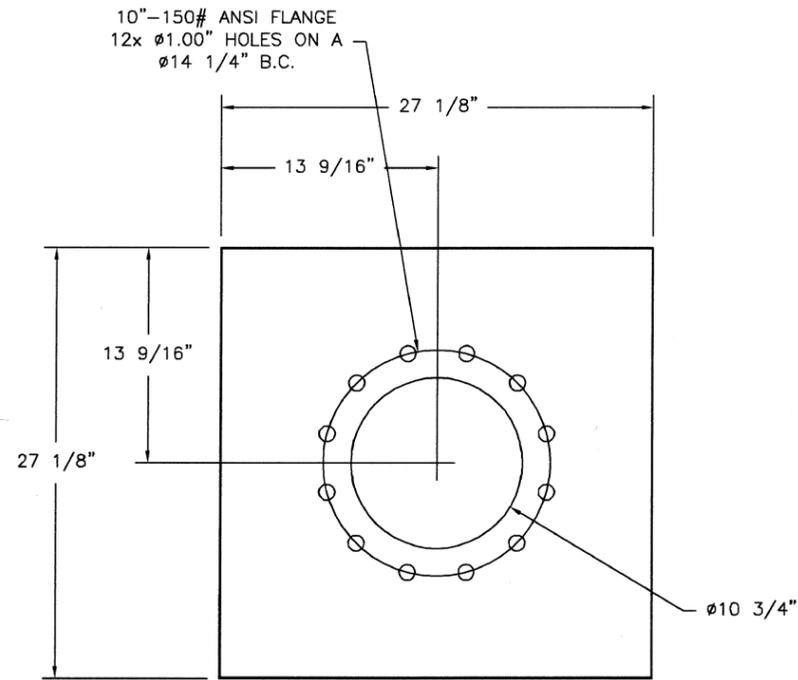

SECTION B-B

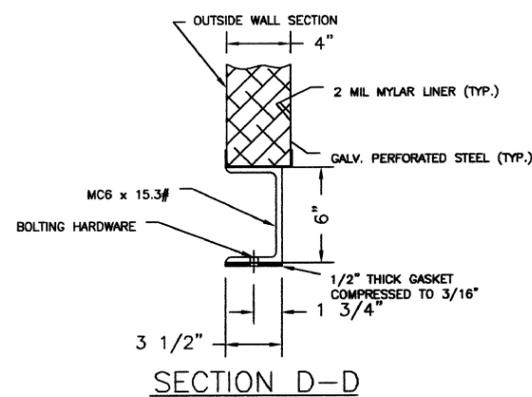

SECTION D-D

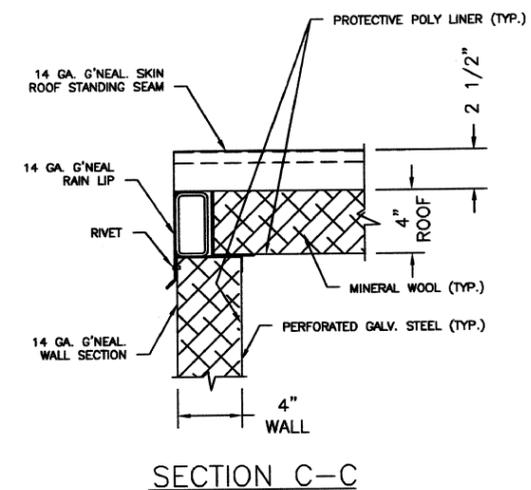

SECTION C-C

THESE DOCUMENTS ARE FOR INTERIM REVIEW AND ARE NOT INTENDED FOR CONSTRUCTION, BIDDING, OR PERMIT PURPOSES.
 MATTHEW HICKEY
 TEXAS P.E. NO. 85480
 DATE: November 2019

These plans and related specifications were prepared for construction of this specific project only. Reuse of these documents is not permitted without written authorization of Birkhoff, Hendricks & Carter, L.L.P. If this drawing is converted to an electronic file, if any discrepancy occurs between the electronic file and the Birkhoff, Hendricks & Carter, L.L.P. original document, the original document will govern in all cases.

BIRKHOFF, HENDRICKS & CARTER, L.L.P.
 PROFESSIONAL ENGINEERS
 TBPE Firm No. 526; TBPLS Firm No. 10031800
 11910 Greenville Ave., Suite 600
 Dallas, Texas 75243 (214) 361-7900




Matthew Hickey
 5/15/19

CITY OF ROCKWALL, TEXAS
 SQUABBLE CREEK LIFT STATION IMPROVEMENTS
 BY-PASS PUMP - SOUND ATTENUATED ENCLOSURE

BHC
 PROJECT NO.
 2015-144
 May, 2018

SHEET NO.
4B

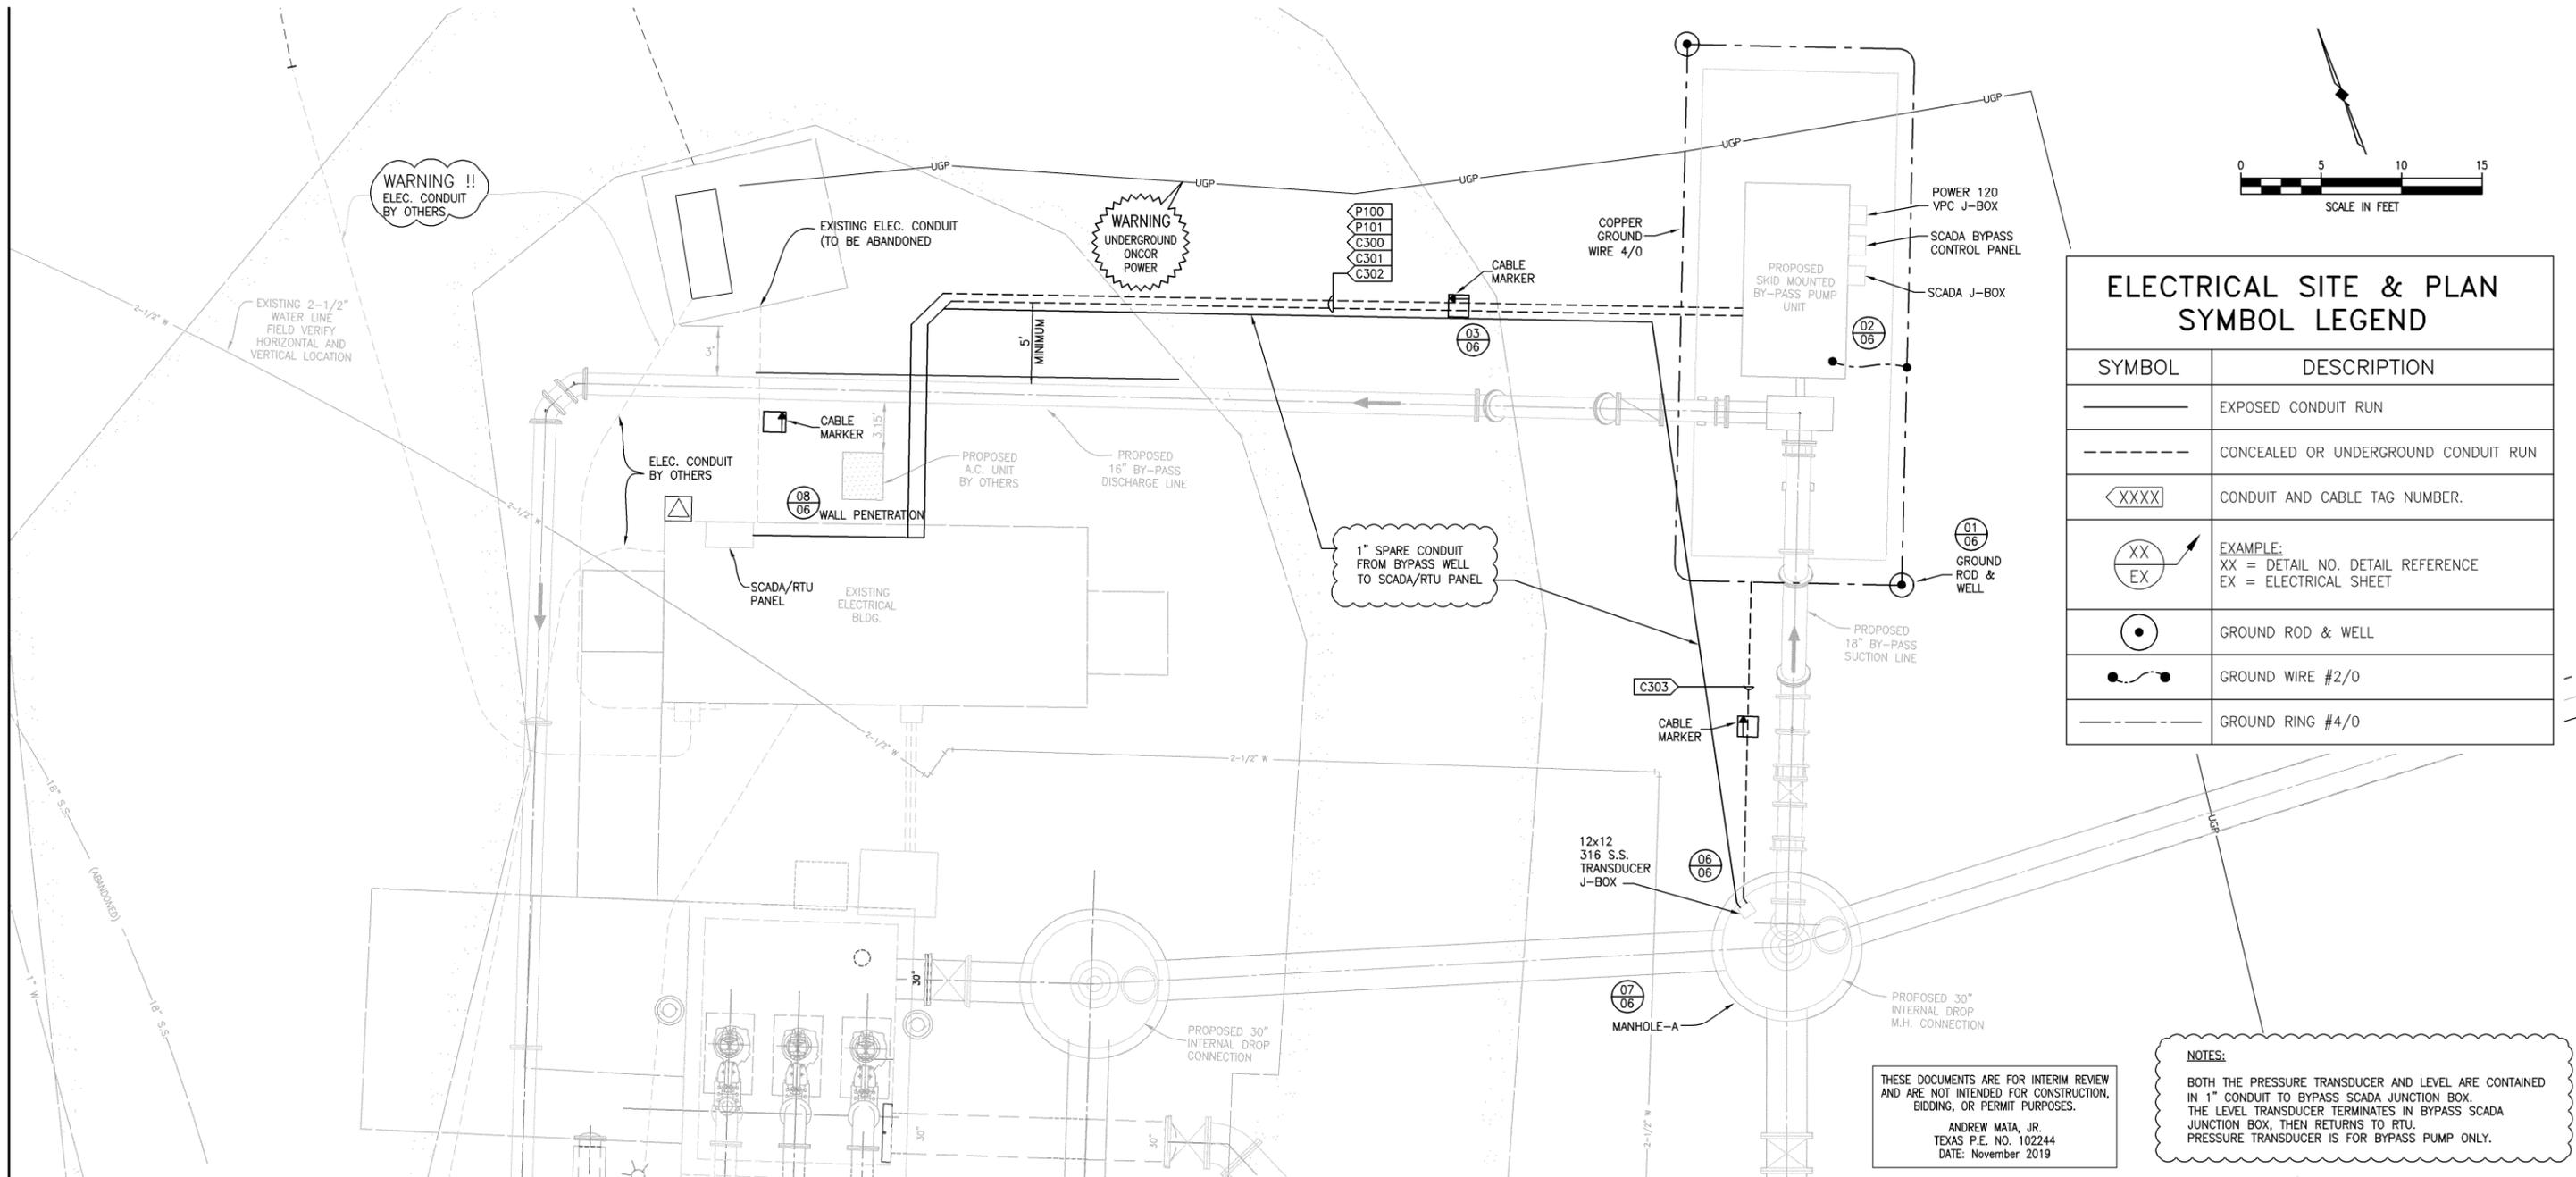

CONDUIT AND CABLE SCHEDULE


TAG	WIRING	CONDUIT	SOURCE	DESTINATION	COMMENTS
P100	4#10, #12G.	1" C.	LIGHTING PANEL 1 CKT 17	BYPASS GENERATOR JACKET WATER HEATER	
P101	4#12, #12G.	1" C.	LIGHTING PANEL 1 CKT 16	BYPASS GENERATOR BATTERY CHARGER	
C300	10#14, #14G.	1" C.	SCADA/RTU PANEL	BYPASS GENERATOR	GENSET PANEL
C301	10#14, #14G.	1" C.	SCADA/RTU PANEL	BYPASS PUMP UNIT	CONTROL PANEL
C302	2-2/C SH #16, #14G	1" C.	SCADA/RTU PANEL	BYPASS PUMP UNIT	
C303	SUBMERSIBLE LEVEL CABLE	1" C.	BY PASS PUMP CONTROL PANEL	SUBMERSIBLE LEVEL TRANSDUCER	

SQUABBLE CREEK BYPASS PUMPING UNIT SCADA/RTU INPUT/OUTPUT TABLE

TAG DESCRIPTION	I/O TYPE	FUNCTION	FIELD DEVICE	COMMENTS
WET WELL LEVEL	A/I	MONITOR	BYPASS PUMP UNIT SUBMERSIBLE LEVEL TRANSDUCER	
WET WELL HIGH LEVEL	A/I	ALARM	BYPASS PUMP UNIT SUBMERSIBLE LEVEL TRANSDUCER	
WET WELL LOW LEVEL	A/I	ALARM	BYPASS PUMP UNIT SUBMERSIBLE LEVEL TRANSDUCER	
BYPASS PUMP RUNNING	D/I	STATUS	STARTER RELAY	PUMP ON/OFF
BYPASS PUMP FAILURE	D/I	ALARM	PUMP MOTOR	PUMP FAILURE
BYPASS GENERATOR RUNNING	D/I	STATUS	GENSET CONTACTS	
BYPASS GENERATOR LOW FUEL	D/I	ALARM	GENSET CONTACTS	
BYPASS GENERATOR ALARM	D/I	ALARM	GENSET CONTACTS	

These plans and related specifications were prepared for construction of this specific project only. Reuse of these documents is not permitted without written authorization of Birkhoff, Hendricks & Carter, L.L.P. If this drawing is converted to an electronic file, if any discrepancy occurs between the electronic file and the Birkhoff, Hendricks & Carter, L.L.P. original document, the original document will govern in all cases.

BIRKHOFF, HENDRICKS & CARTER, L.L.P.
 PROFESSIONAL ENGINEERS
 Texas Firm F526
 11910 Greenville Ave., Suite 600
 Dallas, Texas 75243 (214) 361-7900

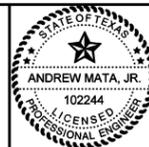

Andrew Mata, Jr.
 05/16/2018


CITY OF ROCKWALL, TEXAS
 SQUABBLE CREEK LIFT STATION IMPROVEMENTS
 ELECTRICAL PLAN

BHC
 PROJECT NO.
 2015-144


May, 2018

SHEET NO.


5

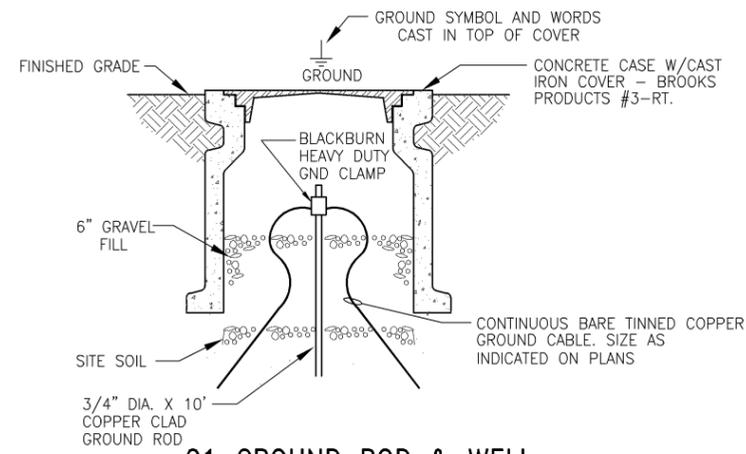

01 GROUND ROD & WELL
NOT TO SCALE

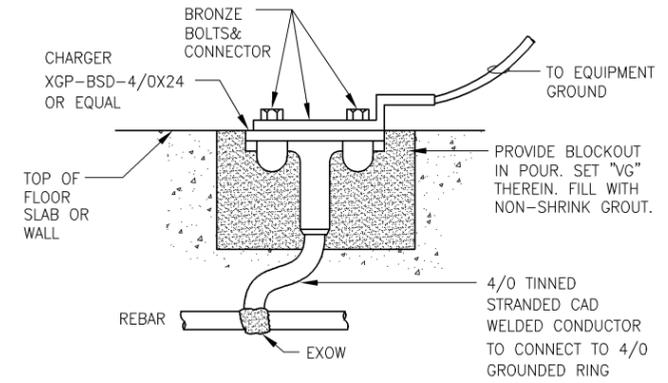


02 IN-SLAB GROUNDING CONDUCTOR VG CONNECTOR
NOT TO SCALE

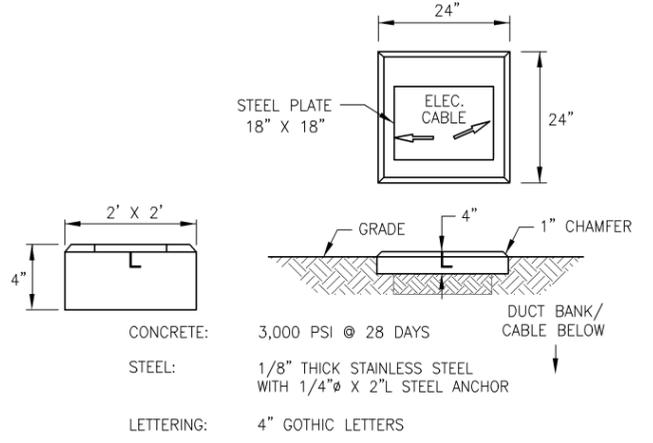


03 CABLE MARKER
NOT TO SCALE

CONCRETE: 3,000 PSI @ 28 DAYS
 STEEL: 1/8\"/>

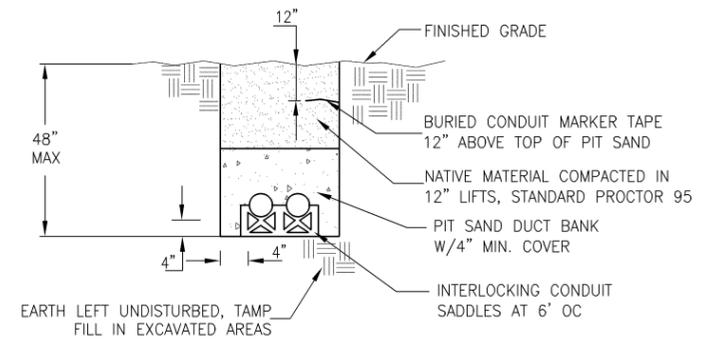


NOTES:
 1. NUMBER AND SIZE OF CONDUITS SHALL BE AS SHOWN ON THE PLANS.
 2. TOP OF PIT SAND ENCASUREMENT SHALL BE A MINIMUM OF 13\"/>


04 DETAIL-CONCRETE ENCASED UNDERGROUND DUCTBANK
NOT TO SCALE

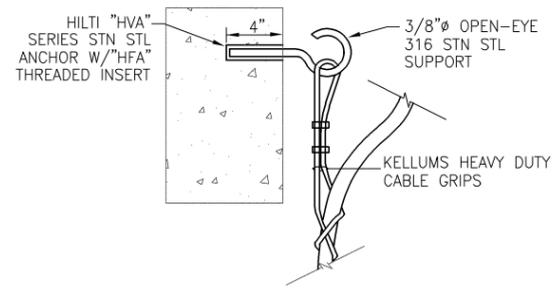


05 TYPICAL CABLE SUPPORT
NOT TO SCALE

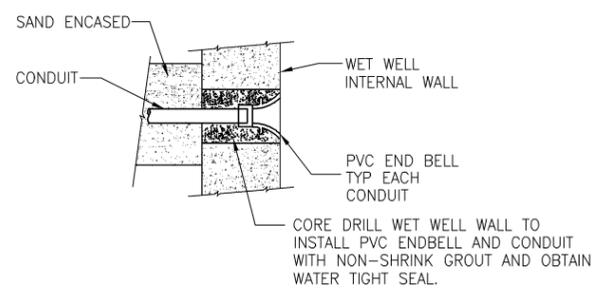

06 END BELL IN SUCTION BYPASS MANHOLE
NOT TO SCALE

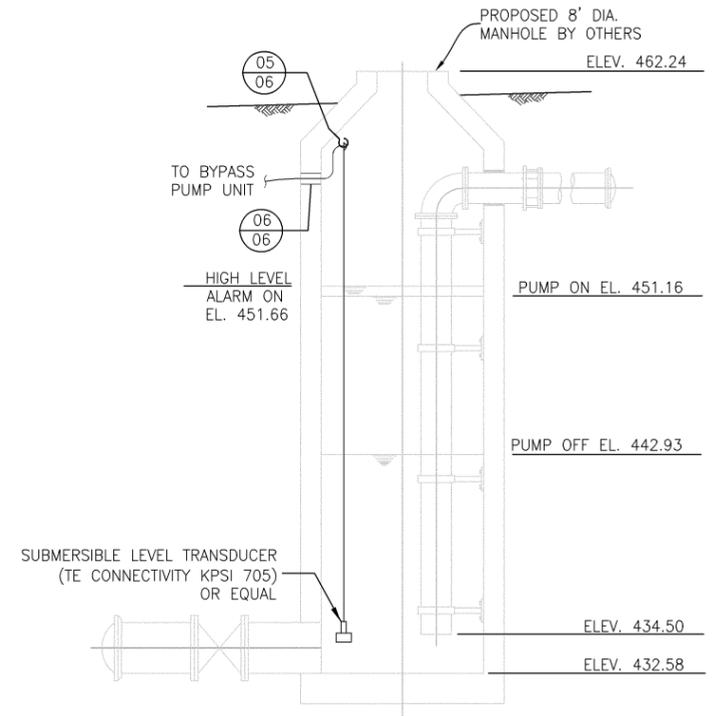

07 SUCTION BYPASS MANHOLE-A
NOT TO SCALE

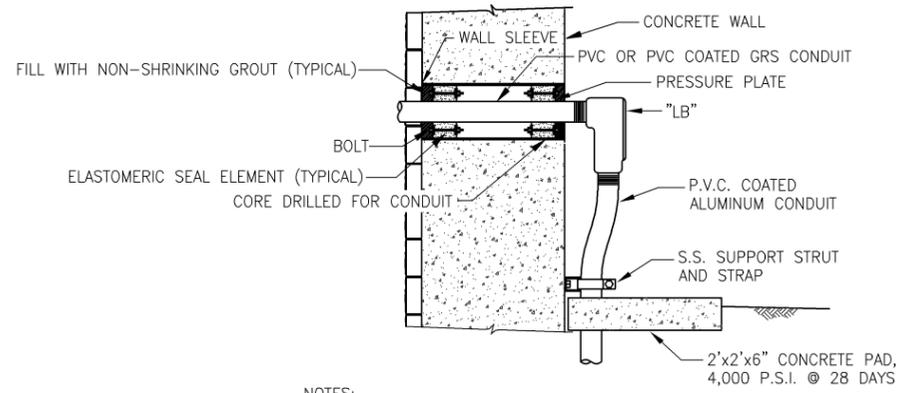


NOTES:
 1. WALL SLEEVE SHALL BE SELECTED FOR WATER VAPOR CONTAINMENT.
 2. LINK SEAL SHALL BE 316 S.S. (S-316) FOR CONDUIT.
 3. WALL SLEEVE TYPICAL HEIGHT 2\"/>

08 LINK-SEAL
NOT TO SCALE

THESE DOCUMENTS ARE FOR INTERIM REVIEW AND ARE NOT INTENDED FOR CONSTRUCTION, BIDDING, OR PERMIT PURPOSES.
 ANDREW MATA, JR.
 TEXAS P.E. NO. 102244
 DATE: November 2019

These plans and related specifications were prepared for construction of this specific project only. Reuse of these documents is not permitted without written authorization of Birkhoff, Hendricks & Carter, L.L.P. If this drawing is converted to an electronic file, if any discrepancy occurs between the electronic file and the Birkhoff, Hendricks & Carter, L.L.P. original document, the original document will govern in all cases.

BIRKHOFF, HENDRICKS & CARTER, L.L.P.
 PROFESSIONAL ENGINEERS
 TBPE Firm No. 526; TBPLS Firm No. 10031800
 11910 Greenville Ave., Suite 600
 Dallas, Texas 75243 (214) 361-7900

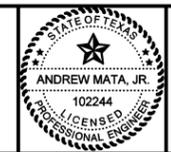

Andrew Mata, Jr.
 05/16/2018

CITY OF ROCKWALL, TEXAS
 SQUABBLE CREEK LIFT STATION IMPROVEMENTS
 ELECTRICAL DETAIL SHEET

BHC
 PROJECT NO.
 2015-144
 May, 2018

SHEET NO.
6

