
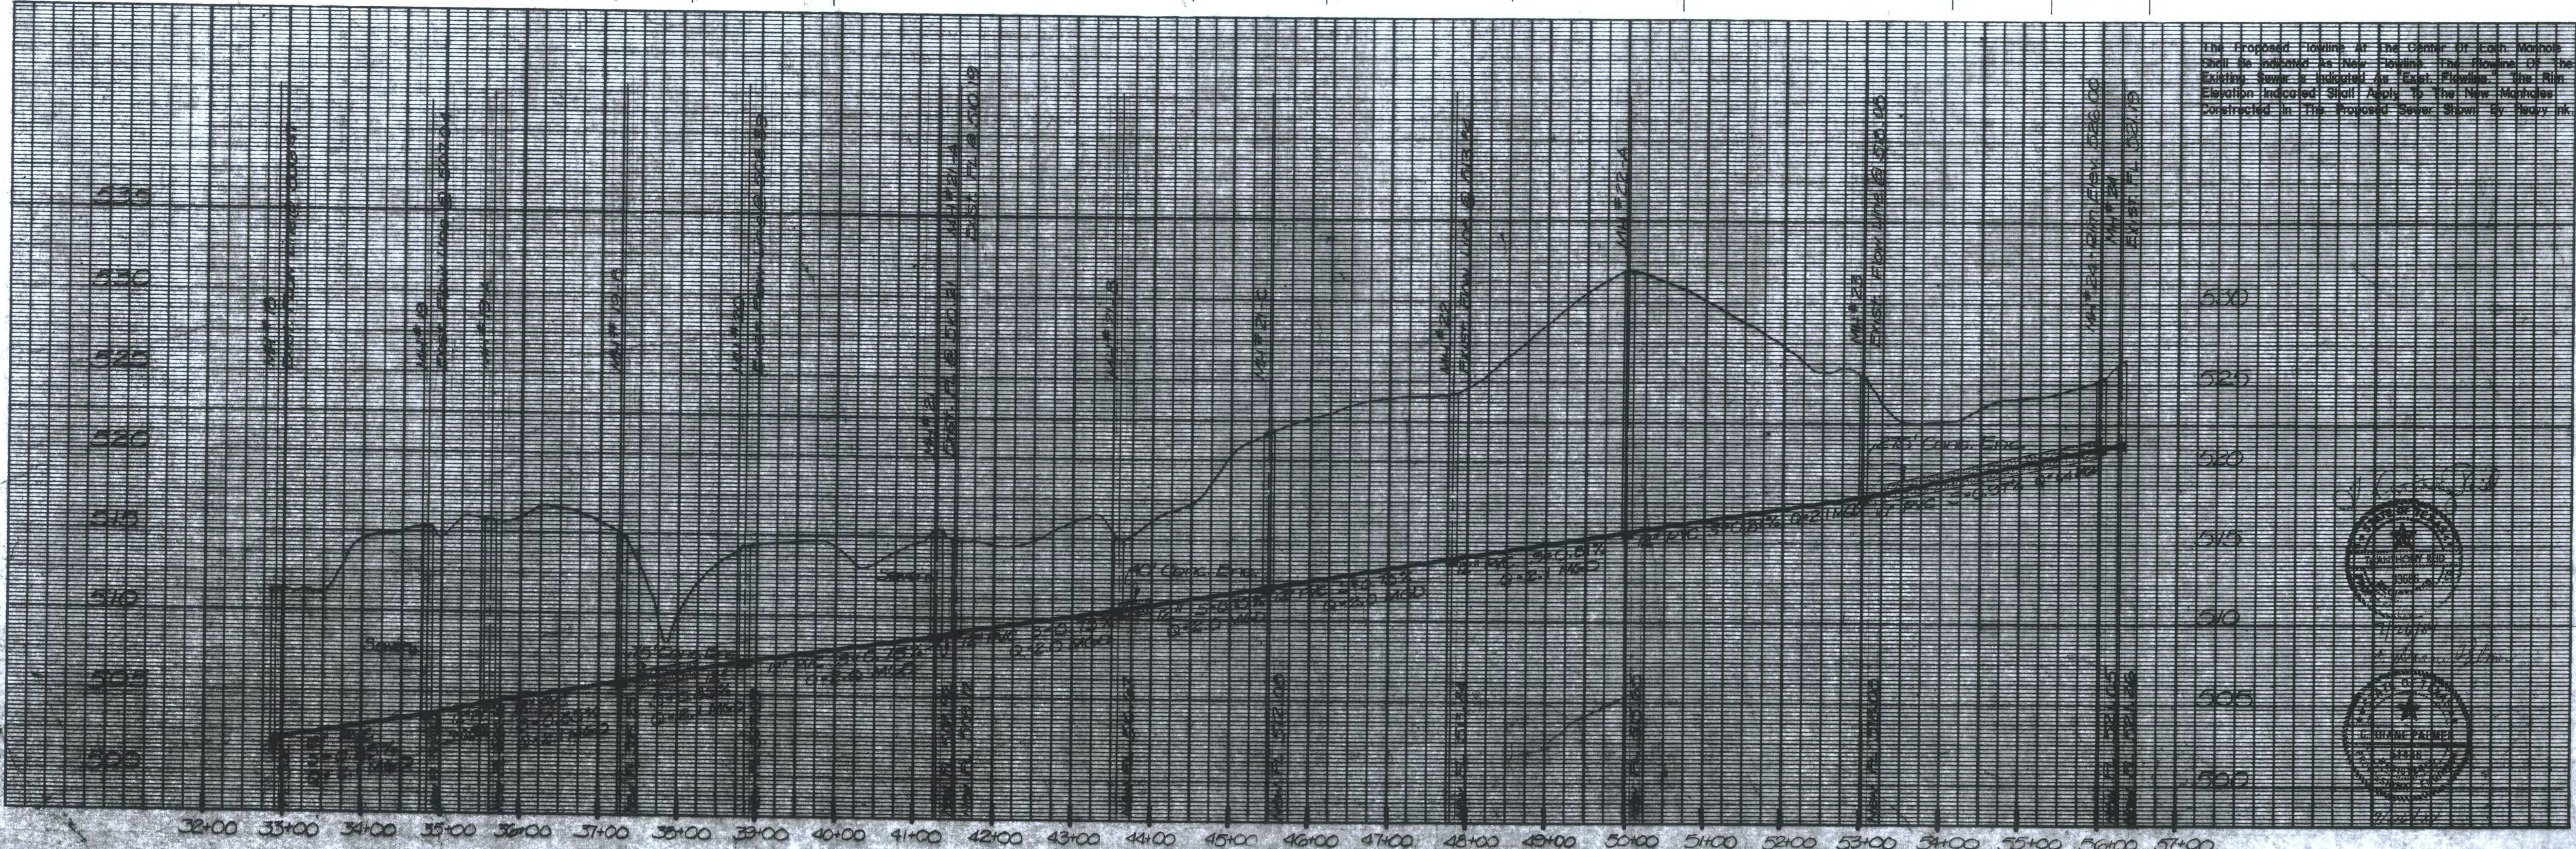


Note:  
 Location of Existing Sewer Pipeline Taken Principally  
 From Original Plans With Some Field Verification of  
 Data. Locations of Underground P.I. in Existing Sewer  
 Will Be Verified By The City At Time Of Construction. The  
 Contractor Shall Verify All Elevations, Alignments, And  
 Distances. Contractor Shall Verify Location of All  
 Utilities And Other Conflicts.

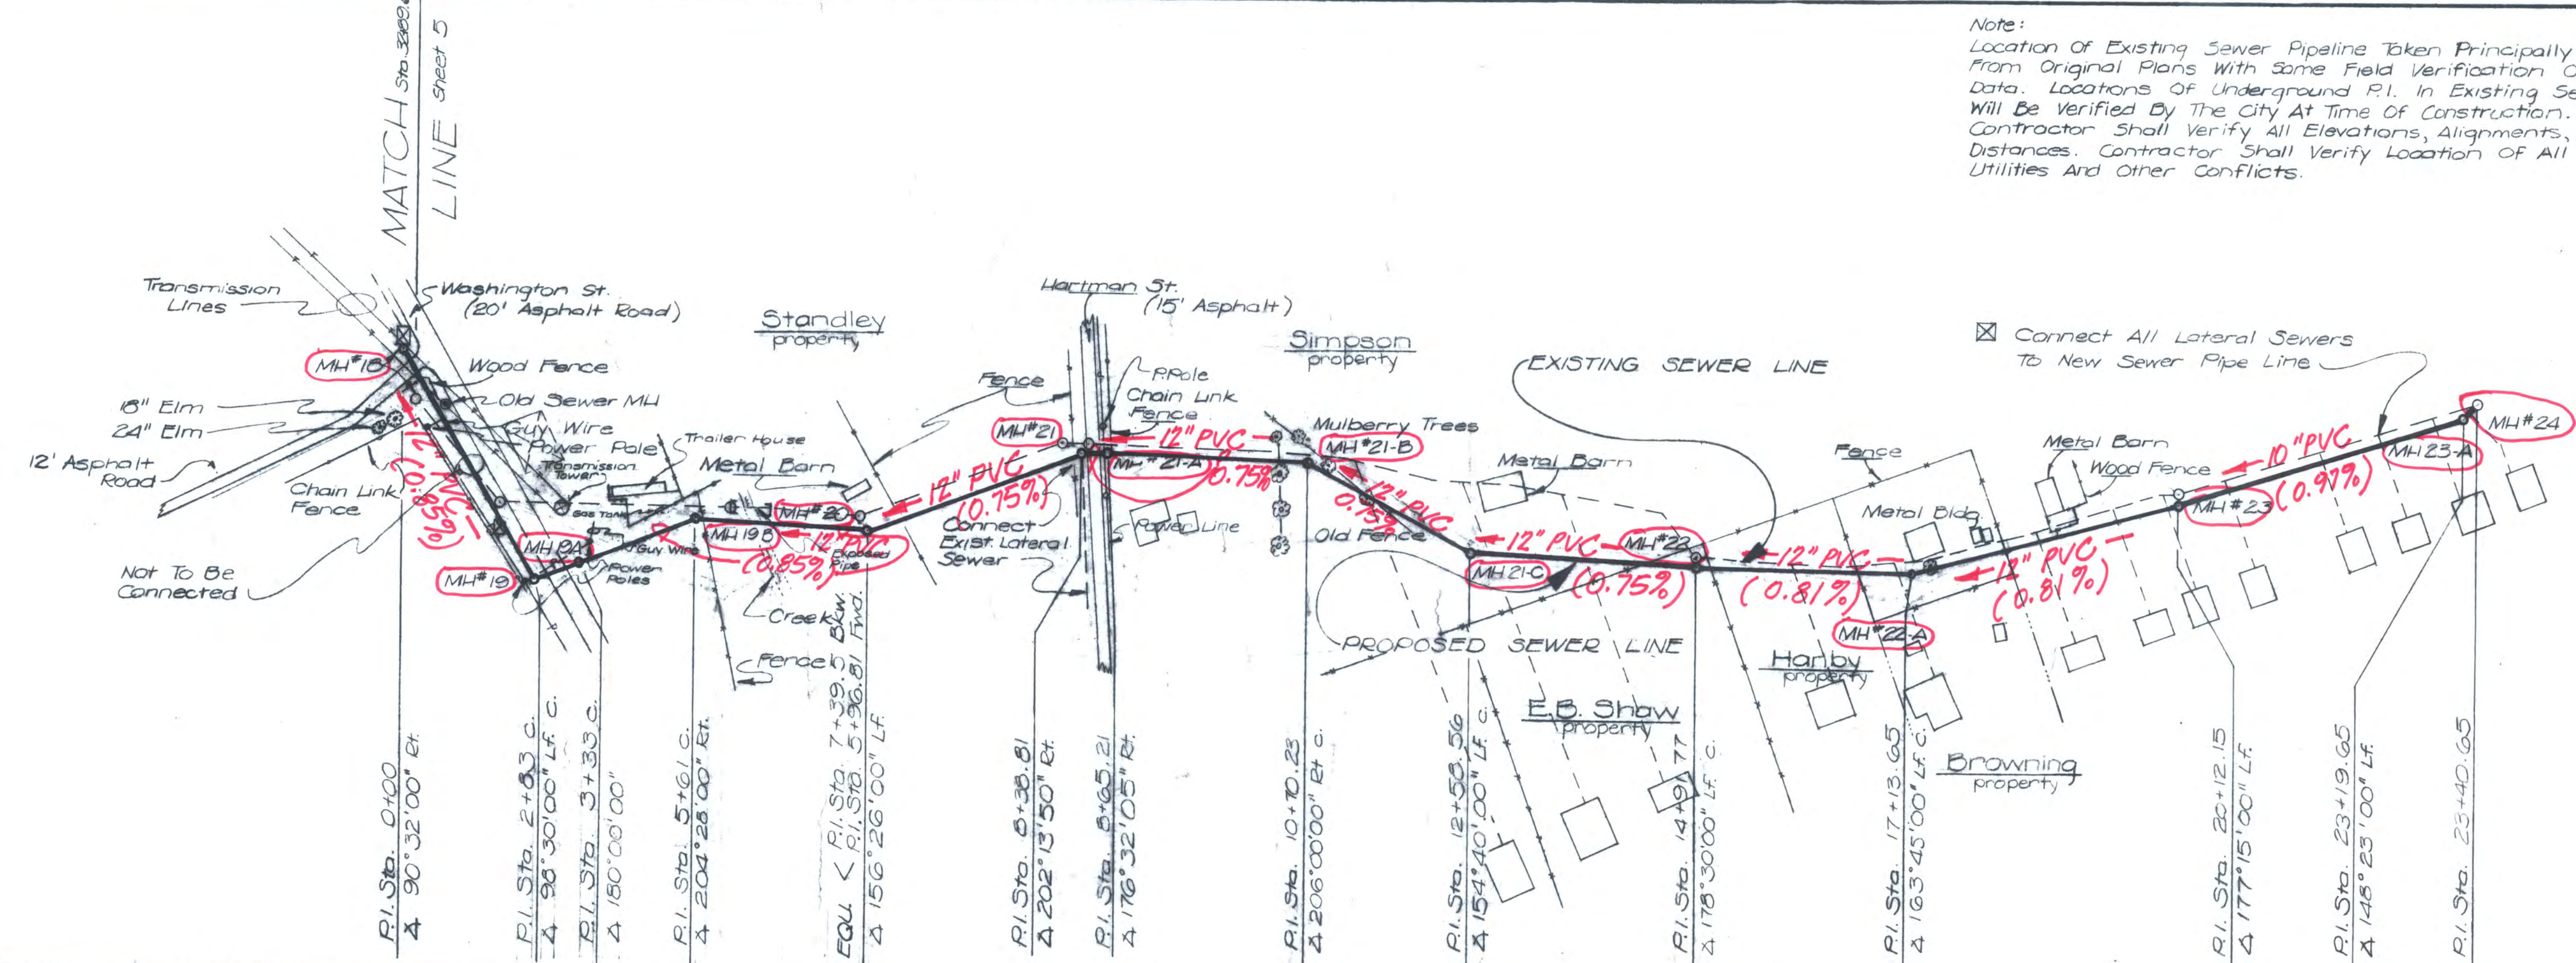

The Proposed Profile at the Center of Each Manhole  
 Shall Be Indicated as New Profile. The Profile of the  
 Existing Sewer is Indicated as 'Exist. Profile'. The Rise  
 Elevation Indicated Shall Apply to the New Manholes  
 Constructed in the Proposed Sewer Shown by Heavy Ink.