
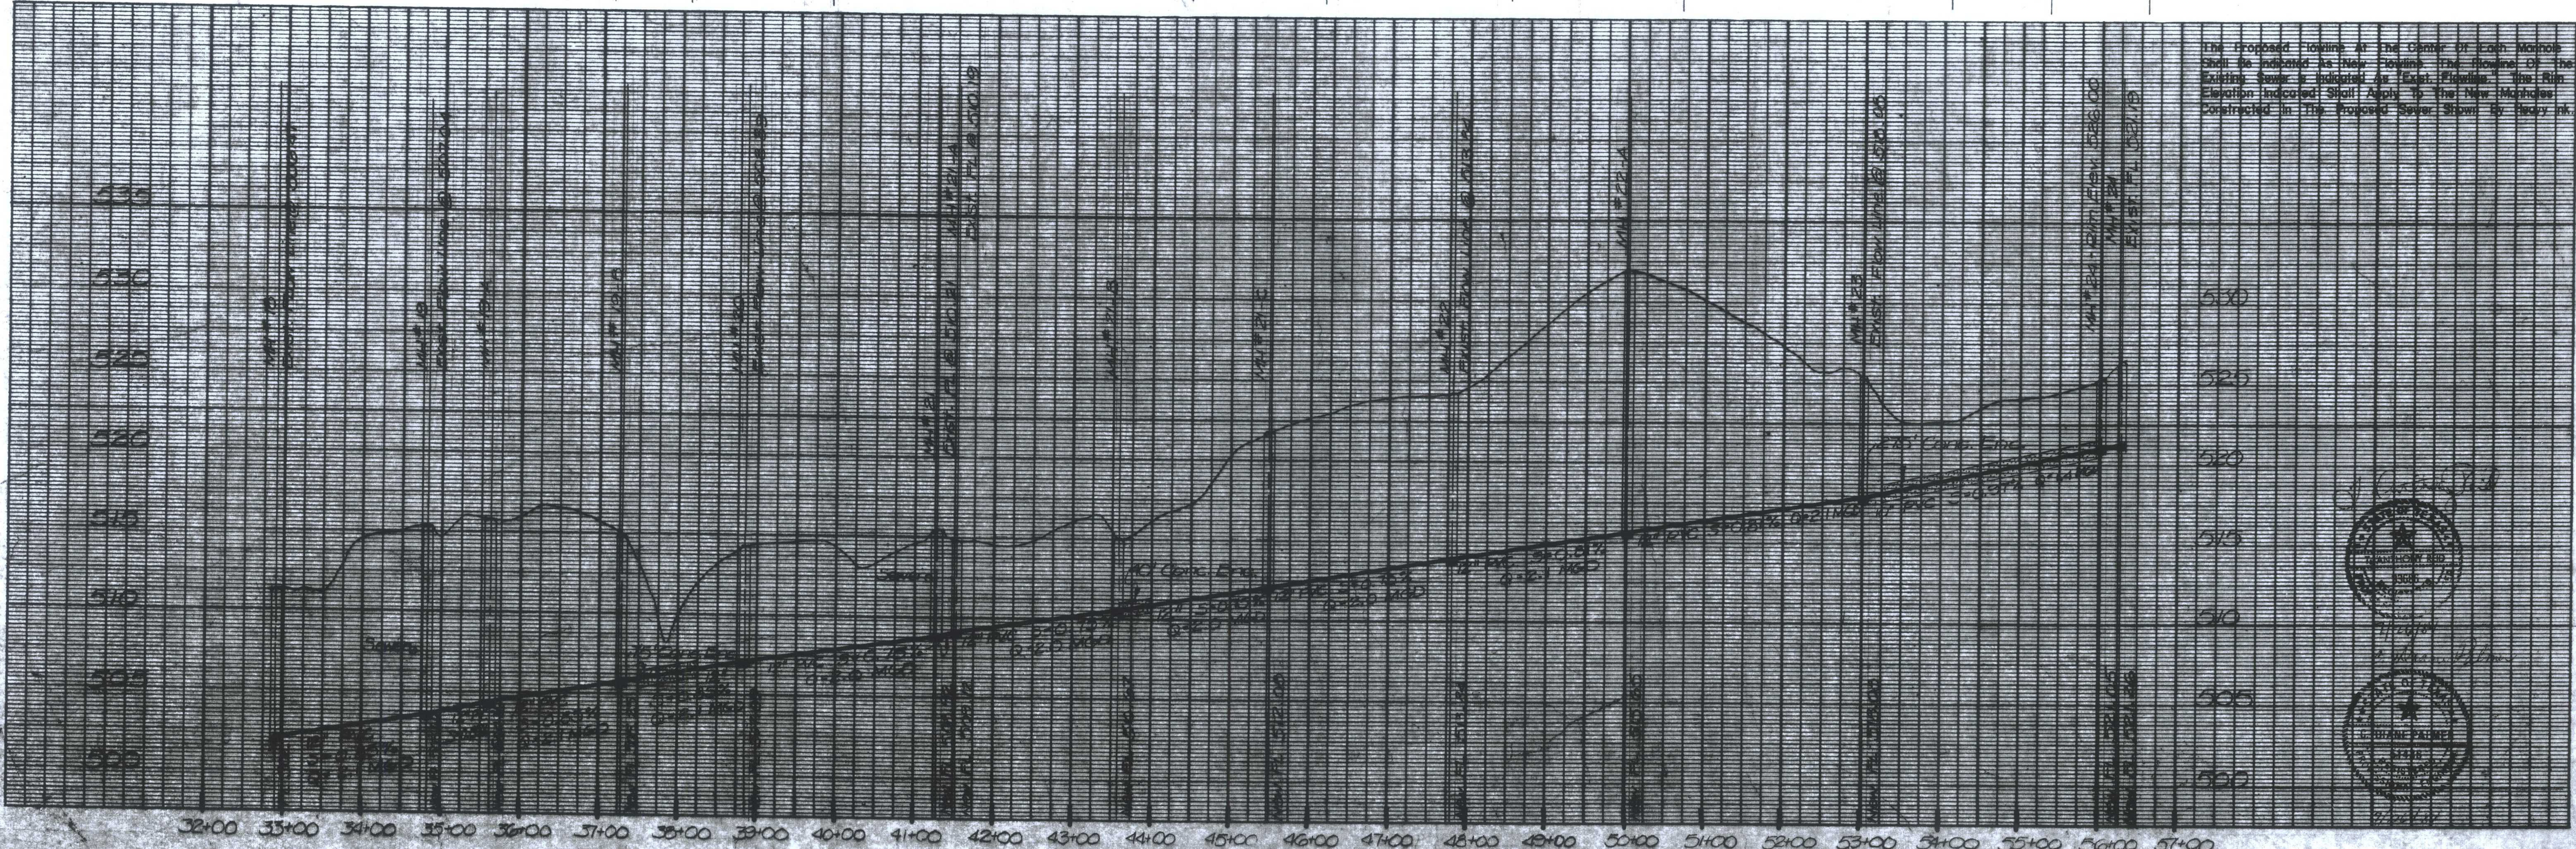


Note:
 Location of Existing Sewer Pipeline Taken Principally
 From Original Plans With Some Field Verification Of
 Data. Locations of Underground P.I. In Existing Sewer
 Will Be Verified By The City At Time Of Construction. The
 Contractor Shall Verify All Elevations, Alignments, And
 Distances. Contractor Shall Verify Location Of All
 Utilities And Other Conflicts.

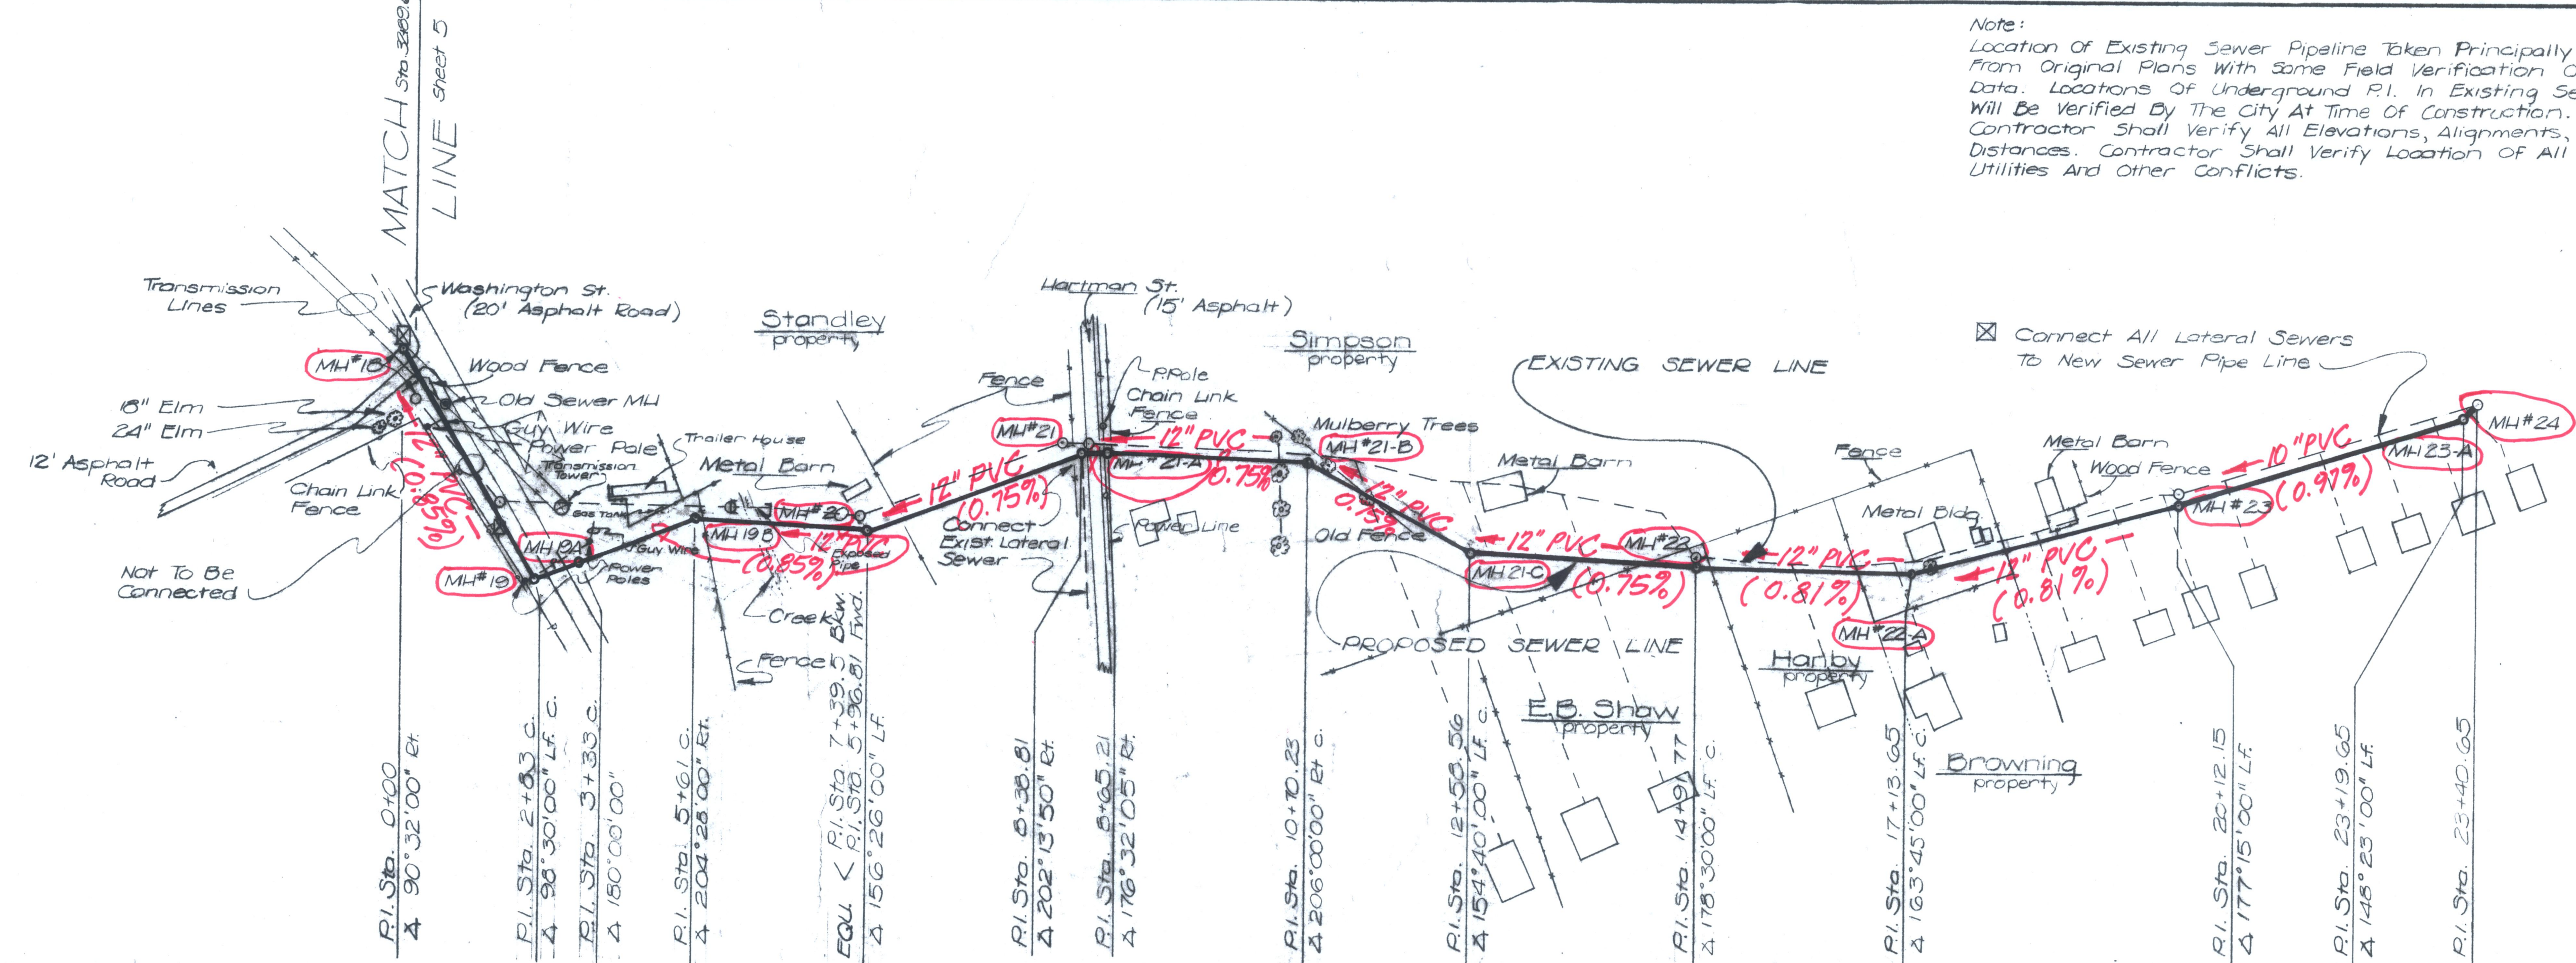

The Proposed Profile At The Center Of Each Manhole
 Shall Be Indicated As New Profile. The Profile Of The
 Existing Sewer Is Indicated As 'Exist. Profile'. The Pipe
 Elevation Indicated Shall Apply To The New Manholes
 Constructed In The Proposed Sewer Shown By Heavy Ink.