

# CITY OF ROCKWALL, TEXAS

CONSTRUCTION PLANS FOR

## I SQUABBLE CREEK TRUNK SEWER II STONEBRIDGE DIVERSION SEWER III AGAPE CIRCLE DRAINAGE IMPROVEMENTS

C.I.P. 1994 REVENUE BOND PROJECT

**COUNCIL MEMBERS**

- GEORGE HATFIELD, MAYOR
- NELL WELBORN, MAYOR PRO-TEM
- BILLY MORRIS
- SCOTT SELF
- SAM BUFFINGTON
- RON COLESON
- DALE MORGAN

**CITY MANAGER**

JULIE COUCH

**ASSISTANT CITY MANAGER**

RICHARD R. CROWLEY

**CITY ENGINEER**


CHUCK TODD, P.E.

*ALTERNATE "B" WAS CONSTRUCTED*  
 PIPE MATERIAL: ULTRA-COR BY ETI  
 CONTRACTOR: SPERLING COMPANY  
 PROJECT SUPERINTENDENT: DANNY SPERLING  
 CITY'S INSPECTOR: SONNY MANCIAS  
 CONTRACT COMPLETION DATE: JULY 20, 1999  
 FINAL ACCEPTANCE DATE: AUGUST 10, 2000  
 FINAL CONTRACT AMOUNT: \$503,958.00



SHIMEK, JACOBS & FINKLEA, L.L.P.  
 CONSULTING ENGINEERS  
 Dallas, Texas

NOVEMBER, 1998

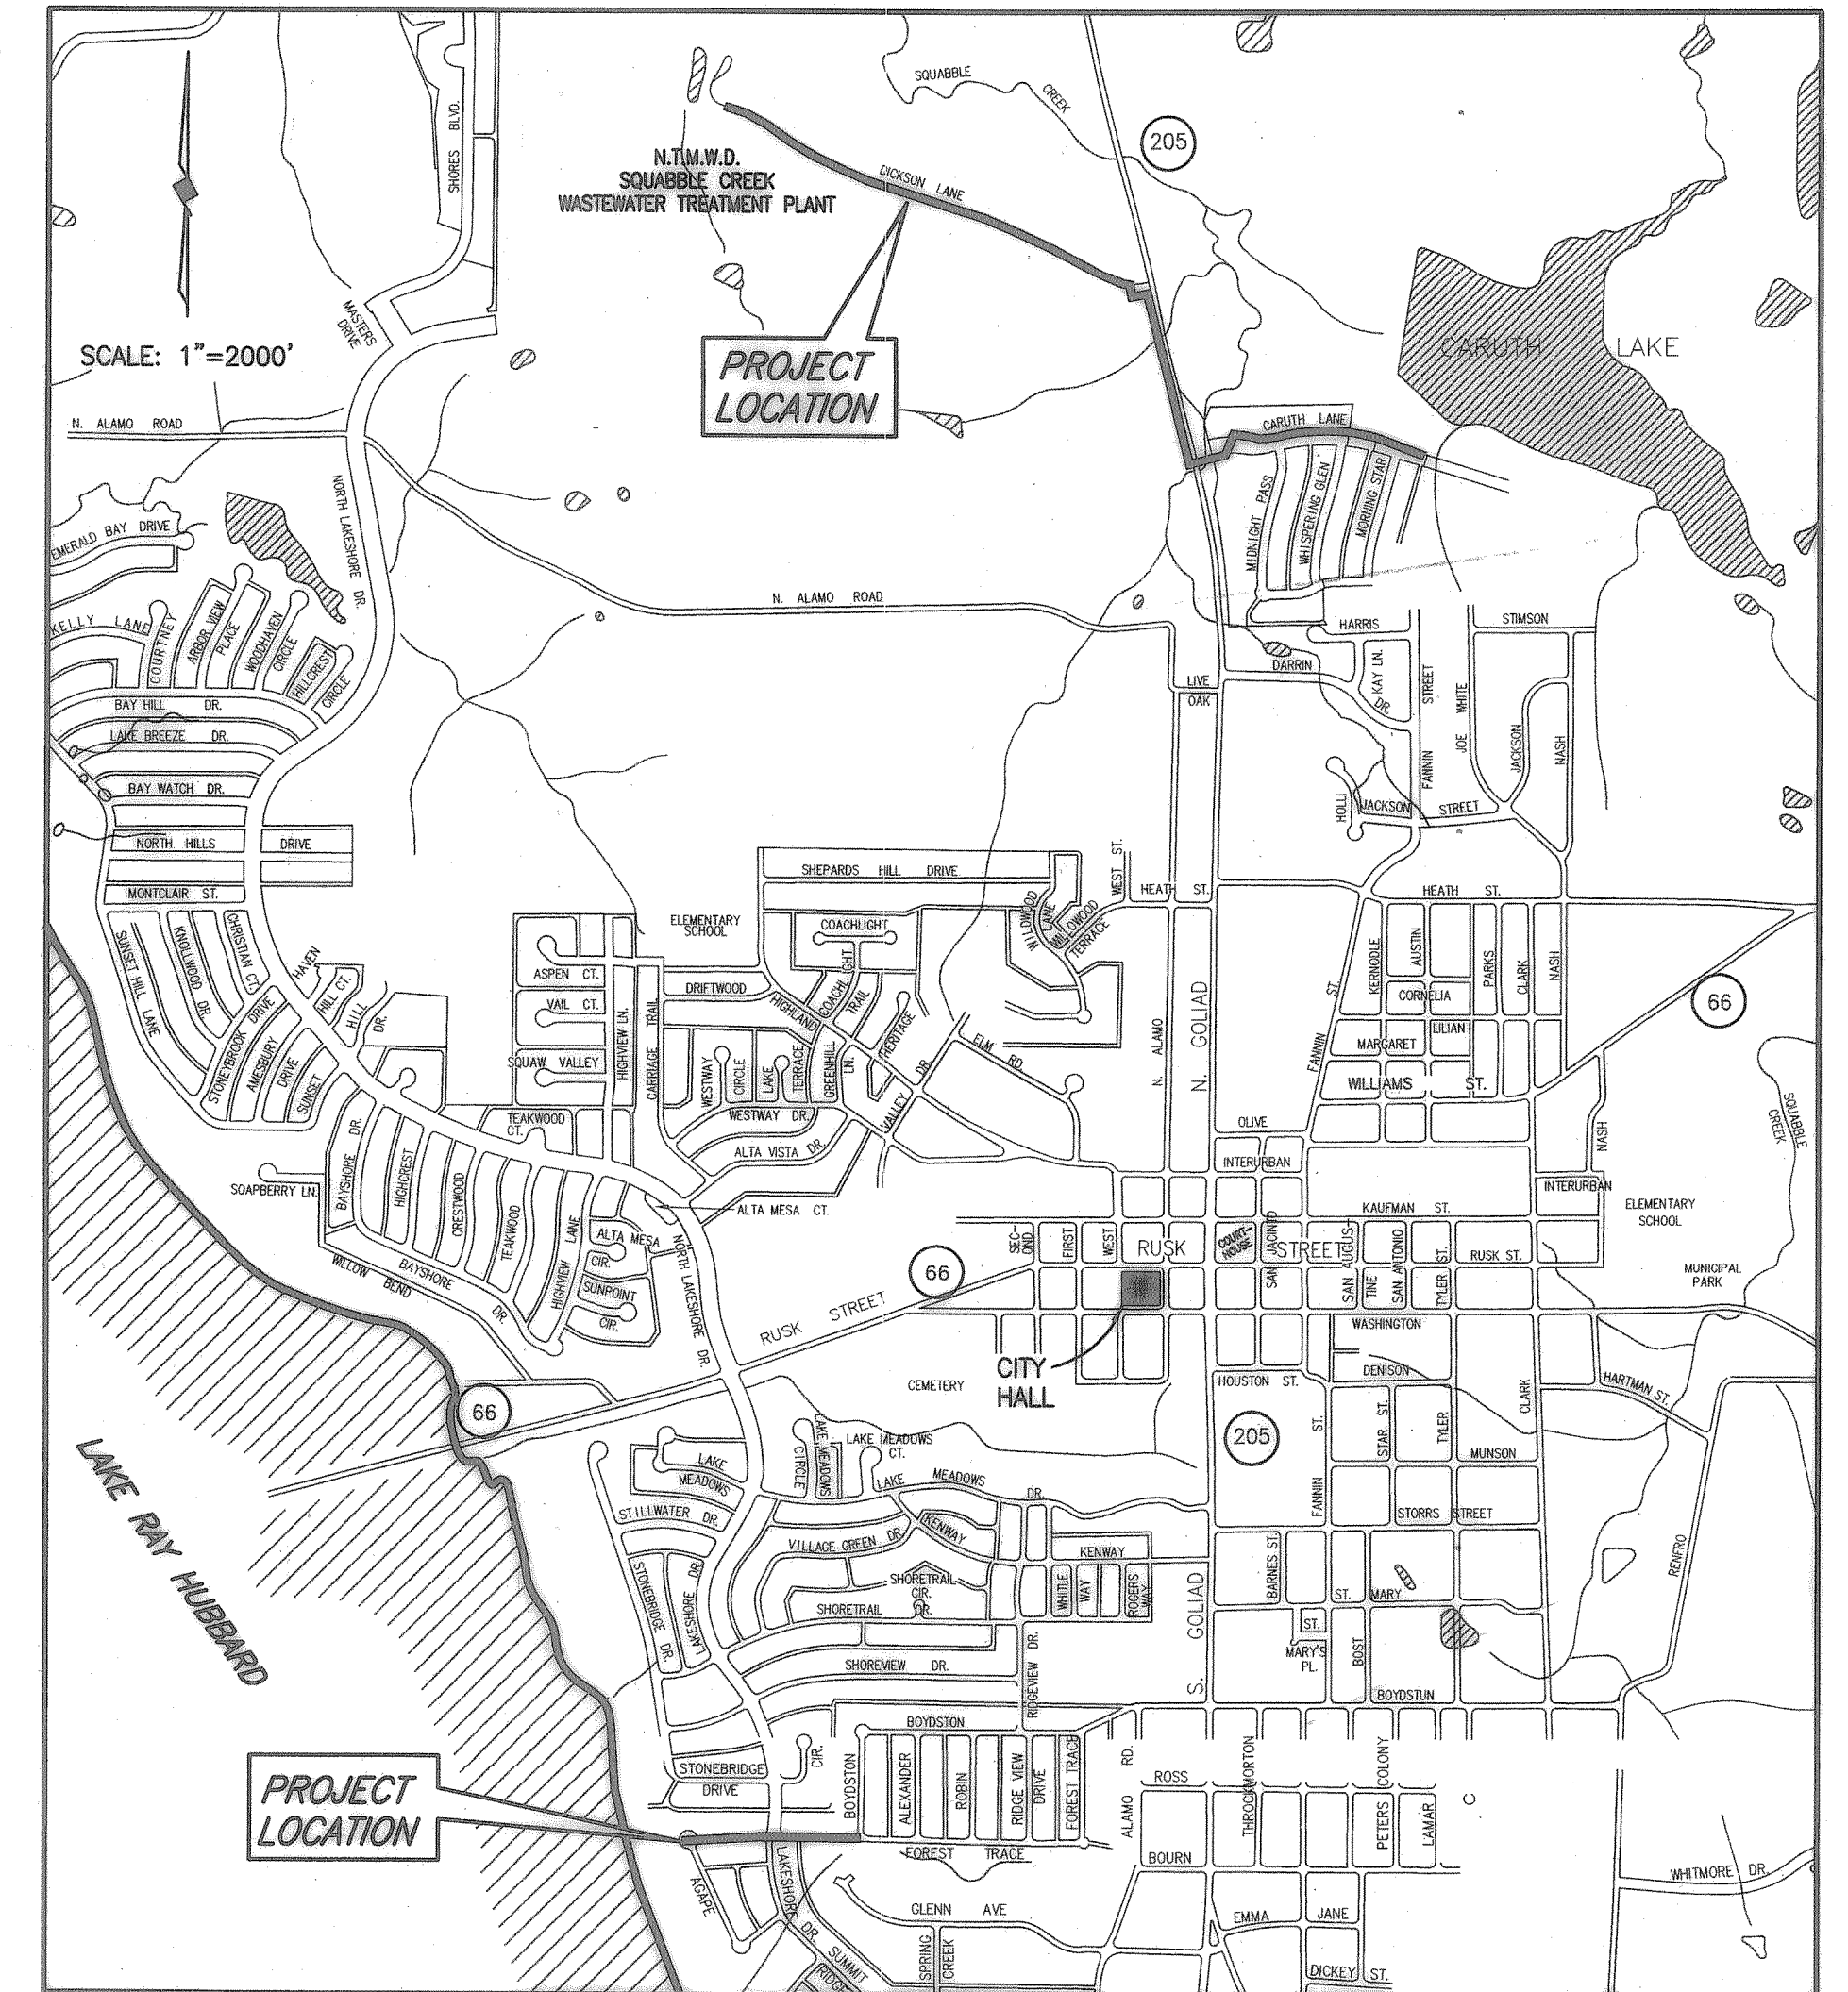

**LOCATION MAP**

**SHEET INDEX**

SHEET NO.	SHEET DESCRIPTION
-	COVER SHEET AND LOCATION MAP
1	SQUABBLE CREEK PLAN—PROFILE STA. 0+00 TO STA. 11+00
2	SQUABBLE CREEK PLAN—PROFILE STA. 11+00 TO STA. 22+00
3	SQUABBLE CREEK PLAN—PROFILE STA. 22+00 TO STA. 33+00
4	SQUABBLE CREEK PLAN—PROFILE STA. 33+00 TO STA. 42+00
5	SQUABBLE CREEK PLAN—PROFILE STA. 42+00 TO STA. 48+66.82
6	SQUABBLE CREEK AERIAL CROSSING PROFILE STA. 35+50 TO 36+75
7	STONEBRIDGE DIVERSION PLAN—PROFILE
8	AGAPE CIRCLE PLAN—PROFILE
9-12	STANDARD DETAILS

REVISED TO CONFORM  
 TO CONSTRUCTION RECORDS  
 BY G.C.T. DATE 12/06/2000



THESE DOCUMENTS ARE FOR  
 BIDDING, CONSTRUCTION,  
 AND PERMIT PURPOSES.  
 DATE: 11/5/98

97129-00.DWG 11/09/98 CRN BLOCKS LOC-MP ASBUILT: 12/06/2000 JPO