


- NOTES:
- 1.) AERIAL CROSSING LUMP SUM BID ITEM SHALL INCLUDE ALL PIPE AND ENCASEMENT, CONC. COLLAR, COUPLING, ABOVE GROUND PIER & SADDLE AND ALL OTHER APPURTENANCES EXCEPT 18" DRILLED SHAFT SHALL BE BID SEPERATELY.
 - 2.) SEE AERIAL CROSSING PIER DETAILS ON SHEET 10.


REVISED TO CONFORM TO CONSTRUCTION RECORDS
BY G.C.H. DATE 12/07/2000

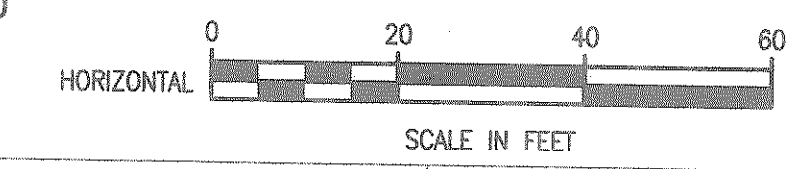

These plans and related specifications were prepared for construction of this specific project only. Reuse of these documents is not permitted without written authorization of Shimek, Jacobs & Finklea, L.L.P.

BLOCKS: AERIAL
11/02/98 KKB
97129-06.DWG

THESE DOCUMENTS ARE FOR BIDDING, CONSTRUCTION, AND PERMIT PURPOSES.
G.C.H.
DATE: 11/9/98

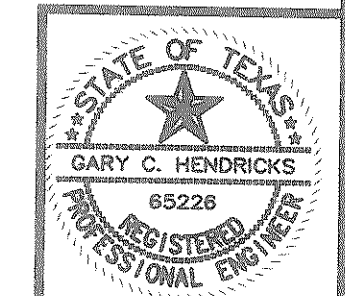

CITY OF ROCKWALL, TEXAS

SQUABBLE CREEK TRUNK SEWER
AERIAL CROSSING PROFILE & DETAILS
STA. 35+34 TO STA. 36+75

SHIMEK, JACOBS & FINKLEA
CONSULTING ENGINEERS
Dallas, Texas

DESIGNED BY: G.C.H.	PROJECT: 97129	SHEET NO. 6
DRAWN BY: S. J. & F.	DATE: NOVEMBER, 1998	OF 12 SHEETS