

REVISION: 3/16/12 - RLowe
PLOT STYLE: 11x17.ctb
PLOT SCALE: 1:2
H:\Projects\Rockwall\2007110 Lift Station\Sheets\2007110 LS Cover.dwg
PLOTTED BY: RLowe ON 3/16/2012

CITY OF ROCKWALL, TEXAS

CONSTRUCTION PLANS FOR SQUABBLE CREEK TO BUFFALO CREEK WASTEWATER TRANSFER

SQUABBLE CREEK LIFT STATION

COUNCIL MEMBERS

BILL CECIL, MAYOR
DAVID SWEET, MAYOR PRO-TEM
MATT SCOTT
CLIFF SEVIER
GLEN FARRIS
MARK RUSSO
MARGO NIELSEN

CITY MANAGER

JULIE COUCH

ASSISTANT CITY MANAGER

RICHARD CROWLEY

CITY ENGINEER

CHUCK TODD, P.E.



BIRKHOFF, HENDRICKS & CARTER, L.L.P.

PROFESSIONAL ENGINEERS


Texas Firm F526
Dallas, Texas 75243

MAY 2010



Paula A. Carline
5/23/10

This record drawing is a compilation of the sealed engineering drawing for this project; modified by addenda, change orders and information furnished by the contractor. The information shown on the record drawings that was provided by the contractor or others not associated with the design engineer cannot be verified for accuracy or completeness. This original sealed drawings are on file at the offices of Birkhoff, Hendricks & Carter, L.L.P.
BY PAC DATE 03/06/12

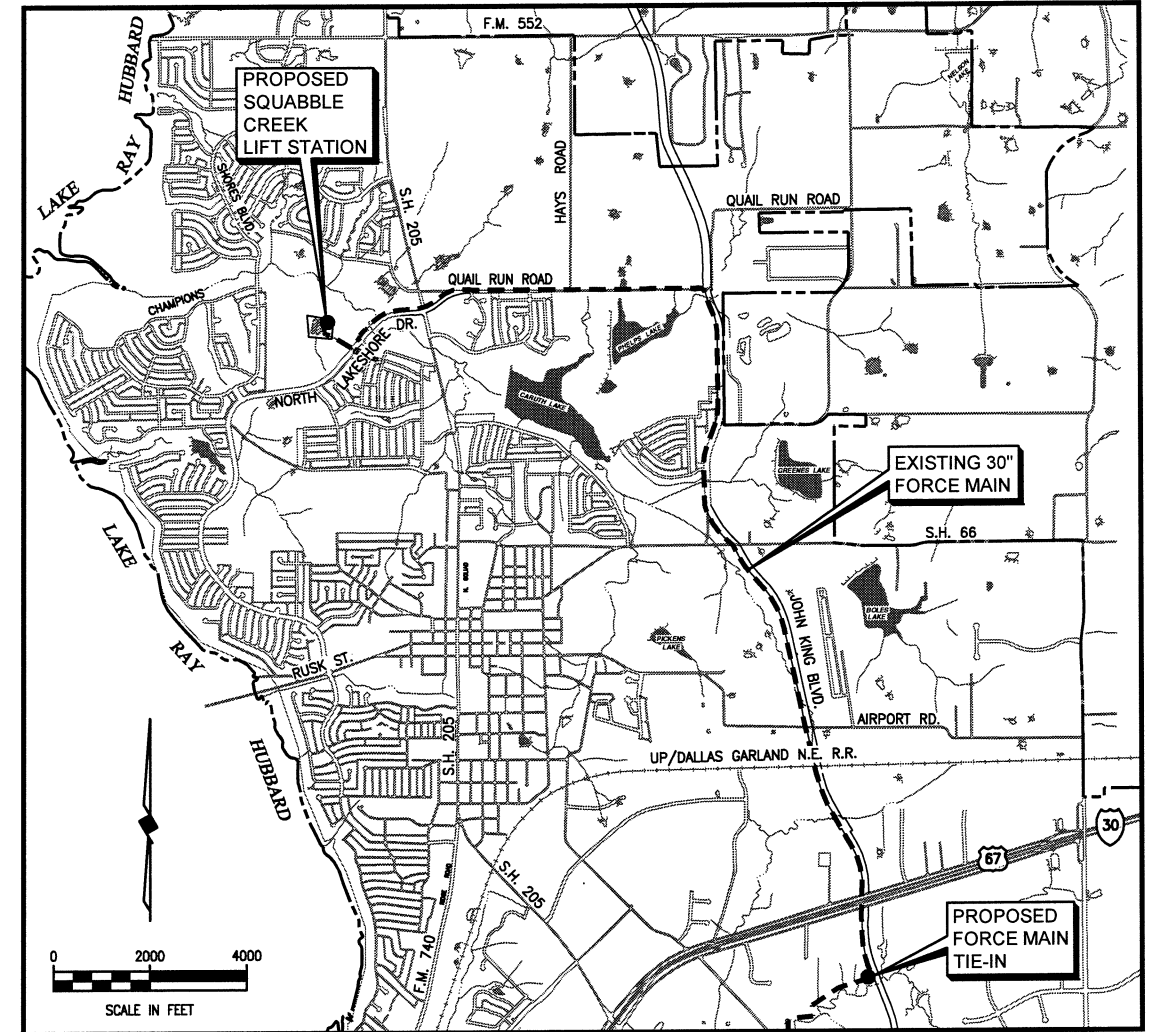

LOCATION MAP

SHEET INDEX

<u>SHEET NO.</u>	<u>SHEET DESCRIPTION</u>
1	COVER SHEET AND LOCATION MAP
2	GENERAL NOTES
3	LIFT STATION SITE PLAN
4	LIFT STATION YARD PIPING PLAN
5	LIFT STATION PIPING PLAN
6 - 7	LIFT STATION PIPING SECTIONS
8	GRAVITY SANITARY SEWER - LINE A PROFILE
9	FORCE MAIN - LINE B PROFILE
10	SPLITTER BOX NO. 3
11	TEMPORARY FORCE MAIN TIE-IN - PLAN-PROFILE
12	FOUNDATION DETAILS
13	DETAILS
E1	ELECTRICAL SITE PLAN
E2	ONE LINE DIAGRAM
E3	CONTROL SCHEMATICS
E4	CONDUIT & CABLE SCHEDULE
E5	ELECTRICAL FLOOR PLAN
E6	LIFT STATION ELECTRICAL PLAN
E7	ELECTRICAL DETAILS
E8	ELECTRICAL DETAILS