


This record drawing is a compilation of the sealed engineering drawing for this project, modified by addenda, change orders and information furnished by the contractor. The information shown on the record drawings that was provided by the contractor or others not associated with the design engineer cannot be verified for accuracy or completeness. This original sealed drawings are on file at the offices of Birkhoff, Hendricks & Carter, L.L.P.  
 BY PAC DATE 03/06/12

TBM 6514  
 SQ. CUT IN CENTER OF NORTH LAKESHORE DR. MEDIAN OPENING AT SQUABBLE WWTP ENTRANCE & SOUTH OF SUTTER DR.  
 N 7033789.3760  
 E 2592028.2244  
 ELEV. 483.52

**GRAVITY SANITARY SEWER LINE A PROFILE**

**BIRKHOFF, HENDRICKS & CARTER, L.L.P.**  
 PROFESSIONAL ENGINEERS  
 Texas Firm F526  
 11910 Greenville Ave., Suite 600  
 Dallas, Texas 75243 (214) 361-7900

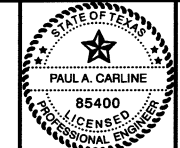

*[Signature]*  
 5/28/10

**CITY OF ROCKWALL, TEXAS**  
 SQUABBLE CREEK LIFT STATION  
 GRAVITY SANITARY SEWER  
 LINE A PROFILE

BHC  
 PROJECT NO.  
 2007-110  
 MAY 2010

SHEET NO.  
**8**

These plans and related specifications were prepared for construction of this specific project only. Reuse of these documents is not permitted without written authorization of Birkhoff, Hendricks, & Carter, L.L.P.