

CITY OF ROCKWALL

CONSTRUCTION PLANS FOR


WATER LINE AND WASTEWATER LINE

REPLACEMENT PROJECT

(ST. MARY STREET, BOST STREET, AND SHERMAN STREET)



City of Rockwall
CIP 2019-001

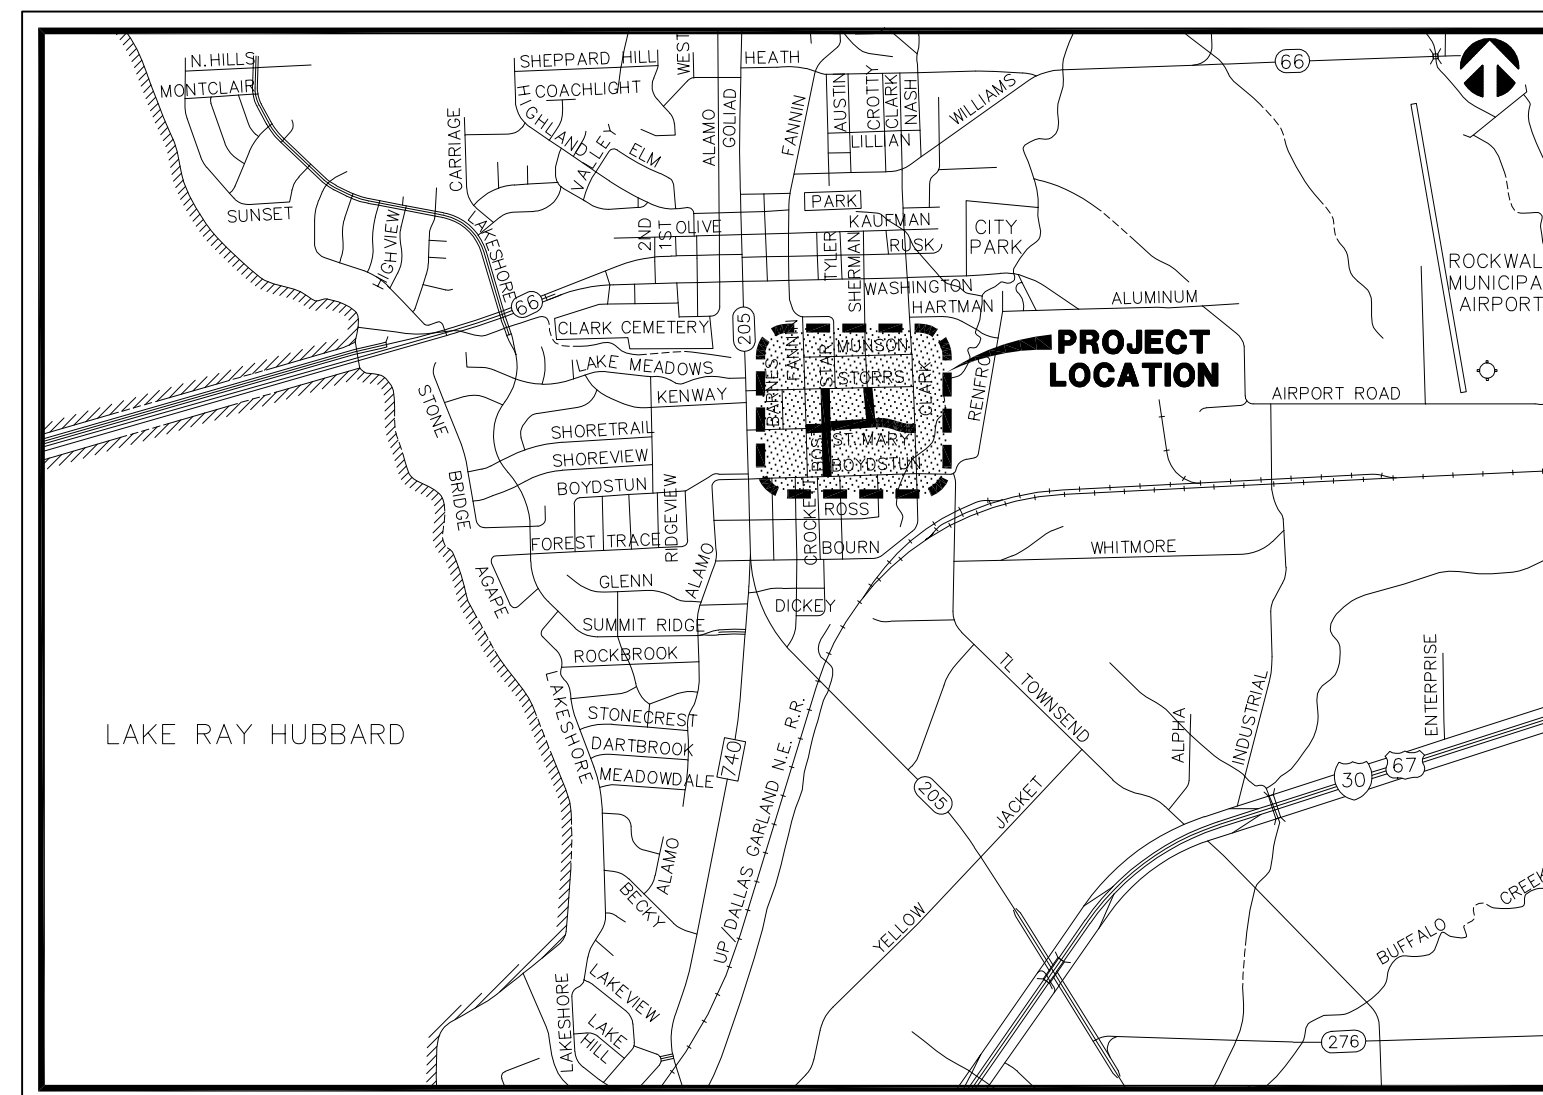

VICINITY MAP

BW2 JOB NO. 19-1933

OCTOBER 2019

"REVISED PER ADDENDA"

SHEET INDEX

COVER SHEET	1
PROJECT GENERAL NOTES	2
PROJECT LOCATION MAP	3
POTHOLE LOCATION MAP	4
EROSION CONTRAL PLAN - SHEET 1	5
EROSION CONTRAL PLAN - SHEET 2	6
EROSION CONTRAL PLAN - SHEET 3	7
EROSION CONTRAL PLAN - SHEET 4	8
LINE "W-A" - STA. 0+00 TO STA. 8+00	9
LINE "W-A" - STA. 8+00 TO STA. 10+46.36 AND LINE "W-D"	10
LINE "W-B" - STA. 0+00 TO STA. 8+00	11
LINE "W-B" - STA. 8+00 TO STA. 9+27.06 AND LINE "W-C"	12
LINE "WW-A" - STA. 0+00 TO STA. 4+00	13
LINE "WW-A" - STA. 4+00 TO STA. 8+00	14
LINE "WW-A" - STA. 8+00 TO STA. 9+77.70	15
LINE "WW-B" AND LINE "WW-C"	16
LINE "WW-D" - STA. 0+00 TO STA. 3+05.00	17
SUGGESTED TCP PHASE 1A - SHEET 1	18
SUGGESTED TCP PHASE 1A - SHEET 2	19
SUGGESTED TCP PHASE 1B - SHEET 1	20
SUGGESTED TCP PHASE 1B - SHEET 2	21
SUGGESTED TCP PHASE 2A	22
SUGGESTED TCP PHASE 2B	23
SUGGESTED TCP PHASE 3A	24
SUGGESTED TCP PHASE 3B	25
C.O.R. - GENERAL CONSTRUCTION NOTES	26
C.O.R. - CONSTRUCTION DETAILS - SHEET 1	27
C.O.R. - CONSTRUCTION DETAILS - SHEET 2	28
C.O.R. - CONSTRUCTION DETAILS - SHEET 3	29

MAYOR
JIM PRUITT

CITY COUNCIL

BENNIE DANIELS	TRACE JOHANNESSEN
KEVIN FOWLER	DANA MACALIK
JOHN HOHENSHELT	PATRICK TROWBRIDGE

CITY MANAGER
RICK CROWLEY

CONTRACTOR

PITTARD CONSTRUCTION COMPANY
COMPLETED APRIL 2020

OWNER:

CITY OF ROCKWALL
385 S. GOLIAD STREET
ROCKWALL, TEXAS 75087

ENGINEER:



BW2 ENGINEERS, INC.

1919 S. SHILOH ROAD
SUITE 500, L.B. 27
GARLAND, TEXAS 75042
Firm Registration No. F-5290

This Record Drawing is a compilation of the sealed engineering drawing for this project as modified by addenda, change orders, and information furnished by the Owner and/or Contractor (Pittard Construction Company). The information shown on the record drawing that was provided by the Contractor or others not associated with the Engineer, cannot be verified for accuracy or completeness. The original sealed engineering drawings are on file at the office of:
BW2 Engineers, Inc.
1919 S. Shiloh Road, Suite 500
Garland, Texas 75042
(972) 864-8200
RECORD DRAWINGS PREPARED ON:
06/01/20

THE SEAL THAT ORIGINALLY APPEARED ON THIS DOCUMENT WAS AUTHORIZED BY MICHAEL R. BURGE, TEXAS P.E. 41290 ON 10/31/19. ALTERATION OF A SEALED DOCUMENT WITHOUT PROPER NOTIFICATION OF THE RESPONSIBLE ENGINEER IS AN OFFENSE UNDER THE TEXAS ENGINEERING PRACTICE ACT.