



This Record Drawing is a compilation of the sealed engineering drawing for this project as modified by addenda, change orders, and information furnished by the Owner and/or Contractor (Pittard Construction Company). The information shown on the record drawing that was provided by the Contractor or others not associated with the Engineer, cannot be verified for accuracy or completeness. The original sealed engineering drawings are on file at the office of:
 BW2 Engineers, Inc.
 1919 S. Shiloh Road, Suite 500
 Garland, Texas 75042
 (972) 864-8200
 RECORD DRAWINGS PREPARED ON:
 06/01/20

WATER LINE "W-B"

STATION	NORTHING(Y)	EASTING(X)
BEGIN STA. 0+00	7025369.4230	2595149.0804
P.I. STA. 0+35.88	7025404.6144	2595142.0804
P.I. STA. 4+49.76	7025818.4956	2595142.0804
P.I. STA. 4+70.27	7025838.6050	2595146.0804
STA. 5+04.72	7025873.0587	2595146.0804
P.I. STA. 5+17.46	7025885.8026	2595146.0804
P.I. STA. 5+31.71	7025899.7718	2595143.3017
P.I. STA. 6+43.01	7026011.0604	2595141.5004
P.I. STA. 6+84.02	7026051.1443	2595132.8505

HORIZONTAL AND VERTICAL CONTROL POINTS

CP#	NORTHING(Y)	EASTING(X)	ELEVATION(Z)	DESCRIPTION
3	7025885.7550	2595113.0590	562.01	1/2" I.R. W/CAP
4	7025601.3530	2595159.9250	561.11	1/2" I.R. W/CAP
5	7025288.8080	2595123.8500	569.08	X CUT
11	7026082.5450	2595142.7530	558.84	1/2" I.R. W/CAP

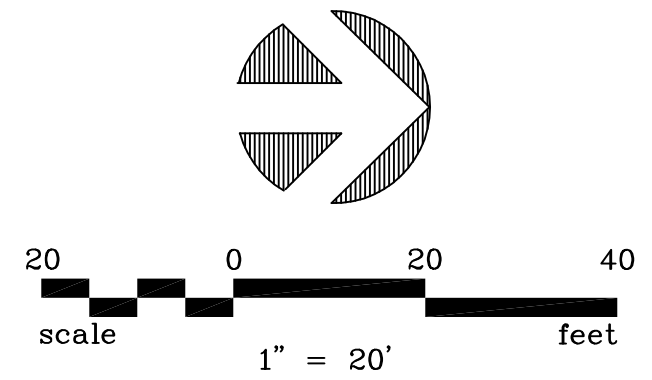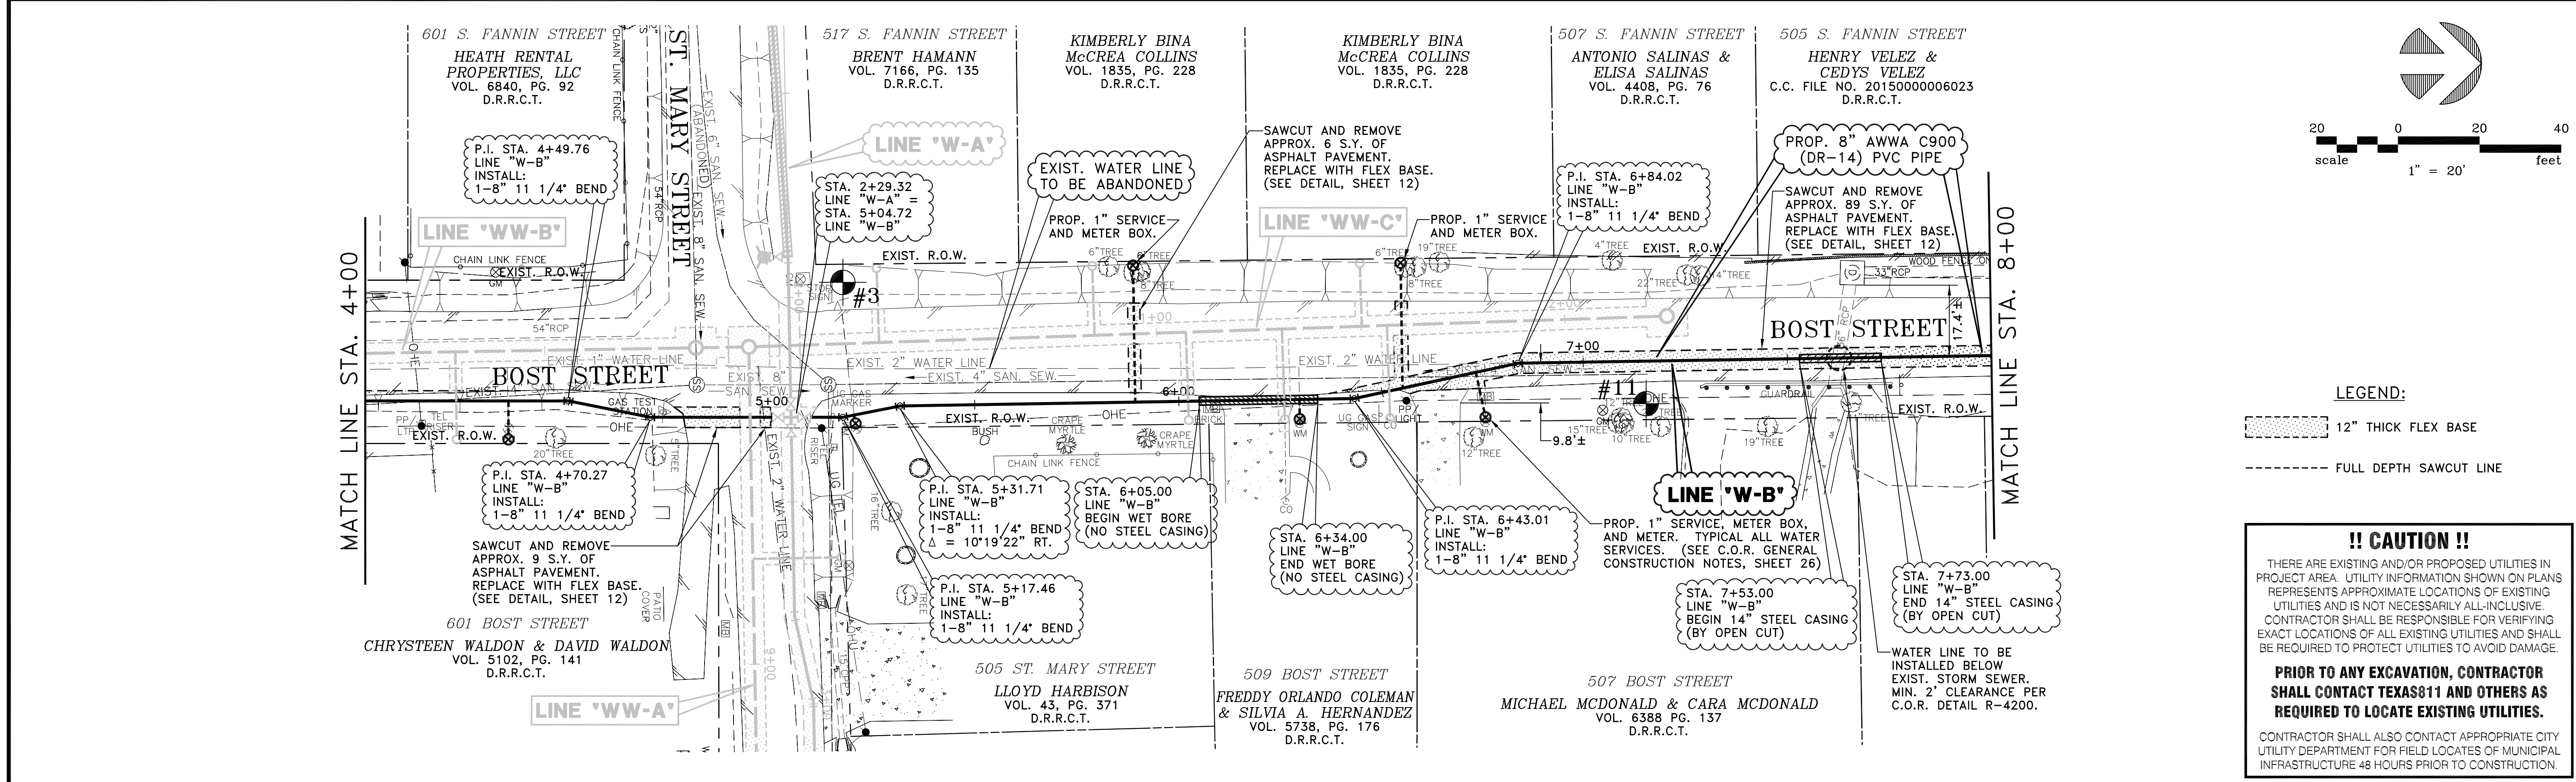

LEGEND:
 [Dashed line symbol] 12" THICK FLEX BASE
 [Dotted line symbol] FULL DEPTH SAWCUT LINE

!! CAUTION !!
 THERE ARE EXISTING AND/OR PROPOSED UTILITIES IN PROJECT AREA. UTILITY INFORMATION SHOWN ON PLANS REPRESENTS APPROXIMATE LOCATIONS OF EXISTING UTILITIES AND IS NOT NECESSARILY ALL-INCLUSIVE. CONTRACTOR SHALL BE RESPONSIBLE FOR VERIFYING EXACT LOCATIONS OF ALL EXISTING UTILITIES AND SHALL BE REQUIRED TO PROTECT UTILITIES TO AVOID DAMAGE.
PRIOR TO ANY EXCAVATION, CONTRACTOR SHALL CONTACT TEXAS811 AND OTHERS AS REQUIRED TO LOCATE EXISTING UTILITIES.
 CONTRACTOR SHALL ALSO CONTACT APPROPRIATE CITY UTILITY DEPARTMENT FOR FIELD LOCATES OF MUNICIPAL INFRASTRUCTURE 48 HOURS PRIOR TO CONSTRUCTION.

NO.	DATE	REVISION	REVIEWED
6			
5			
4			
3			
2			
1			

DRAWN: BW2
 DESIGN: MRB
 REVIEWED: JFW
 SCALE: 1" = 20'
 DATE: OCTOBER 2019
 DWG. NAME: 1933WTR01BOST

BW2 ENGINEERS, INC.
 1919 S. Shiloh Road
 Suite 500, L.B. 27
 Garland, Texas 75042
 (972) 864-8200 (T) (972) 864-8220 (F)
 Firm Registration No. F-5290

THE SEAL THAT ORIGINALLY APPEARED ON THIS DOCUMENT WAS AUTHORIZED BY MICHAEL R. BURGE, TEXAS P.E. 41290 ON 10/11/19. ALTERATION OF A SEALED DOCUMENT WITHOUT PROPER NOTIFICATION OF THE RESPONSIBLE ENGINEER IS AN OFFENSE UNDER THE TEXAS ENGINEERING PRACTICE ACT.

WATER LINE AND WASTEWATER LINE REPLACEMENT PROJECT
 (ST. MARY STREET, BOST STREET, AND SHERMAN STREET)
 LINE "W-B" - STA. 0+00 TO STA. 8+00
CITY OF ROCKWALL

SHEET NO. 11
 OF 29 SHEETS
 JOB NO. 19-1933