

LEGEND:

--- 12" THICK FLEX BASE

----- FULL DEPTH SAWCUT LINE

!! CAUTION !!

THERE ARE EXISTING AND/OR PROPOSED UTILITIES IN PROJECT AREA. UTILITY INFORMATION SHOWN ON PLANS REPRESENTS APPROXIMATE LOCATIONS OF EXISTING UTILITIES AND IS NOT NECESSARILY ALL-INCLUSIVE. CONTRACTOR SHALL BE RESPONSIBLE FOR VERIFYING EXACT LOCATIONS OF ALL EXISTING UTILITIES AND SHALL BE REQUIRED TO PROTECT UTILITIES TO AVOID DAMAGE.

PRIOR TO ANY EXCAVATION, CONTRACTOR SHALL CONTACT TEXAS811 AND OTHERS AS REQUIRED TO LOCATE EXISTING UTILITIES.

CONTRACTOR SHALL ALSO CONTACT APPROPRIATE CITY UTILITY DEPARTMENT FOR FIELD LOCATES OF MUNICIPAL INFRASTRUCTURE 48 HOURS PRIOR TO CONSTRUCTION.

WASTEWATER LINE "WW-A"


STATION	NORTHING(Y)	EASTING(X)
P.I. STA. 5+01.54	7025871.4960	2595604.9370
STA. 6+95.00	7025867.9386	2595411.5098

HORIZONTAL AND VERTICAL CONTROL POINTS

CP#	NORTHING(Y)	EASTING(X)	ELEVATION(Z)	DESCRIPTION
6	7025864.0870	2595534.2700	547.24	1/2" I.R. W/CAP

!!!CAUTION!!!

BURIED GAS LINES IN THE AREA. CONTRACTOR SHALL CALL FOR LOCATES AND NOTIFY ATMOS ENERGY TWO WORKING DAYS PRIOR TO CONSTRUCTION.

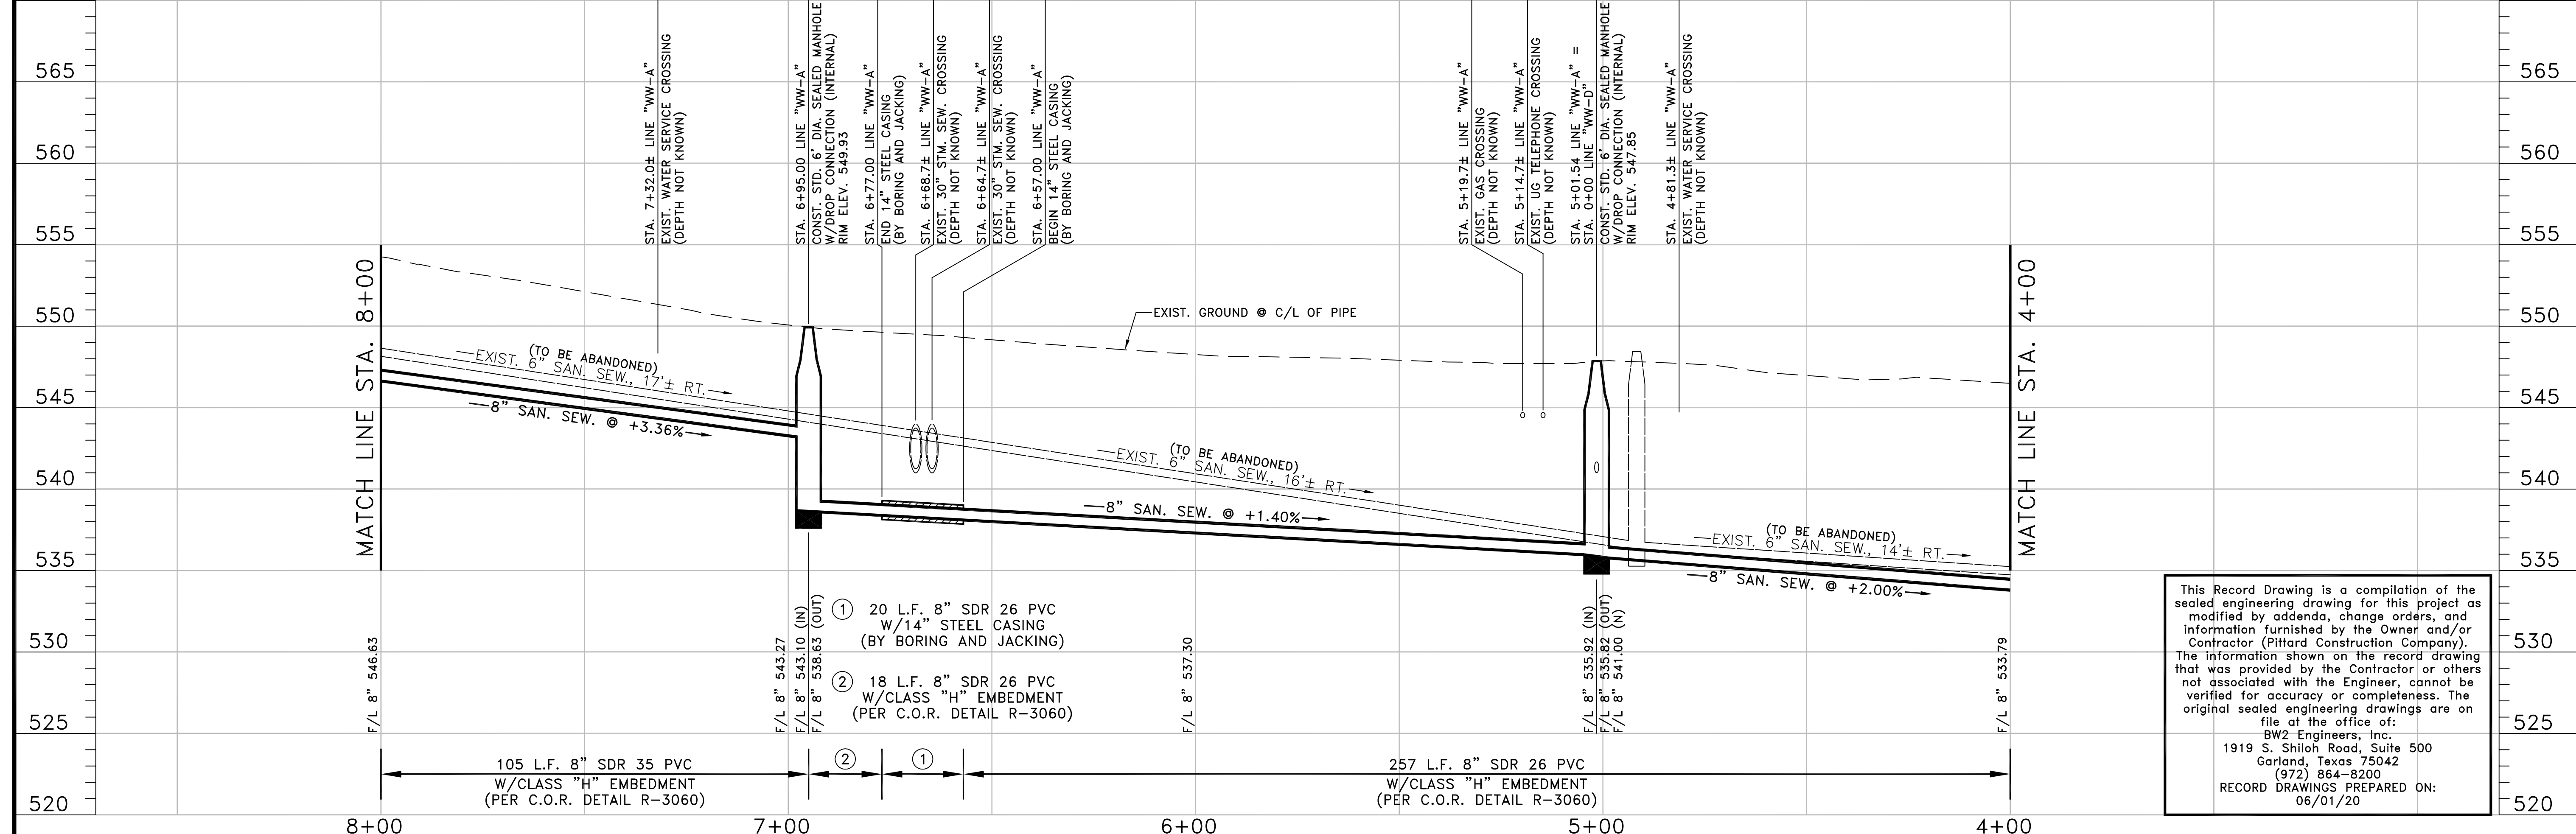

This Record Drawing is a compilation of the sealed engineering drawing for this project as modified by addenda, change orders, and information furnished by the Owner and/or Contractor (Pittard Construction Company). The information shown on the record drawing that was provided by the Contractor or others not associated with the Engineer, cannot be verified for accuracy or completeness. The original sealed engineering drawings are on file at the office of:

BW2 Engineers, Inc.
 1919 S. Shiloh Road, Suite 500
 Garland, Texas 75042
 (972) 864-8200
 RECORD DRAWINGS PREPARED ON:
 06/01/20

NO.	DATE	REVISION	REVIEWED
6			
5			
4			
3			
2			
1			

DRAWN: BW2
 DESIGN: MRB
 REVIEWED: JFW
 SCALE: (H)1"=20', (V)1"=5'
 DATE: OCTOBER 2019
 DWG. NAME: 1933SEW02STMARY

BW2 ENGINEERS, INC.

1919 S. Shiloh Road
 Suite 500, L.B. 27
 Garland, Texas 75042
 (972) 864-8200 (T) (972) 864-8220 (F)
 Firm Registration No. F-5290

WATER LINE AND WASTEWATER LINE REPLACEMENT PROJECT
 (ST. MARY STREET, BOST STREET, AND SHERMAN STREET)
 LINE "WW-A" - STA. 4+00 TO STA. 8+00
CITY OF ROCKWALL

SHEET NO. 14
 OF 29 SHEETS
 JOB NO. 19-1933