

- NOTES:**
1. POTHOLE LOCATIONS SHOWN ARE APPROXIMATE LOCATIONS. EXACT LOCATIONS OF THE POTHOLES SHALL BE AT THE DISCRETION OF THE CITY.
  2. THE DEPTH OF EACH POT HOLE SHALL BE DETERMINED BY THE DEPTH OF THE TOP OF THE CITY UTILITY LINE.
  3. ADDITIONAL POTHOLES MAY BE REQUIRED BY THE CITY AT LOCATIONS DETERMINED BY THE CITY.
  4. CONTRACTOR SHALL PREPARE AND PROVIDE REPORT OF RESULTS OF EACH POT HOLE PERFORMED. THE INFORMATION PROVIDED SHALL INCLUDE THE POT HOLE NO. AND THE DEPTH TO THE TOP OF THE PIPE AS MEASURED DOWN BY THE CONTRACTOR. ALSO, THE CONTRACTOR SHALL MARK THE ACTUAL HORIZONTAL LOCATION OF EACH POT HOLE.
  5. THE CONTRACTOR SHALL NOT DO EXCAVATIONS TO LOCATE THE EXISTING WATER LINES, SANITARY SEWERS, AND STORM SEWERS. THE POTHOLES TO LOCATE THE EXISTING LINES SHALL BE DONE BY A COMPANY THAT HAS THE EXPERTISE AND EQUIPMENT TO DO THE POT HOLE WORK.

☯ **POT HOLE LOCATION TABLE**

NUMBER	POT HOLE LOCATION TYPE
#1	LOCATE EXISTING 1" AND 2" WATER LINE.
#2	LOCATE EXISTING 6" SANITARY SEWER, EXISTING 2" WATER LINE, AND EXISTING 2-30" STORM SEWERS.
#3	LOCATE EXISTING 2" WATER LINE.
#4	LOCATE EXISTING 1" WATER LINE.
#5	LOCATE EXISTING 6" SANITARY SEWER.
#6	LOCATE EXISTING 18" STORM SEWER.
#7	LOCATE EXISTING 1" WATER LINE.
#8	LOCATE EXISTING 12" STORM SEWER.
#9	LOCATE EXISTING 2" WATER LINE.
#10	LOCATE EXISTING 2" WATER LINE.

This Record Drawing is a compilation of the sealed engineering drawing for this project as modified by addenda, change orders, and information furnished by the Owner and/or Contractor (Pittard Construction Company). The information shown on the record drawing that was provided by the Contractor or others not associated with the Engineer, cannot be verified for accuracy or completeness. The original sealed engineering drawings are on file at the office of:  
 BW2 Engineers, Inc.  
 1919 S. Shiloh Road, Suite 500  
 Garland, Texas 75042  
 (972) 864-8200  
 RECORD DRAWINGS PREPARED ON:  
 06/01/20

**!! CAUTION !!**


THERE ARE EXISTING AND/OR PROPOSED UTILITIES IN PROJECT AREA. UTILITY INFORMATION SHOWN ON PLANS REPRESENTS APPROXIMATE LOCATIONS OF EXISTING UTILITIES AND IS NOT NECESSARILY ALL-INCLUSIVE. CONTRACTOR SHALL BE RESPONSIBLE FOR VERIFYING EXACT LOCATIONS OF ALL EXISTING UTILITIES AND SHALL BE REQUIRED TO PROTECT UTILITIES TO AVOID DAMAGE.

**PRIOR TO ANY EXCAVATION, CONTRACTOR SHALL CONTACT TEXAS811 AND OTHERS AS REQUIRED TO LOCATE EXISTING UTILITIES.**

CONTRACTOR SHALL ALSO CONTACT APPROPRIATE CITY UTILITY DEPARTMENT FOR FIELD LOCATES OF MUNICIPAL INFRASTRUCTURE 48 HOURS PRIOR TO CONSTRUCTION.

6			
5			
4			
3			
2			
▲	10/31/19	REVISED PER ADDENDUM NO. 1	MRB
NO.	DATE	REVISION	REVIEWED

DRAWN:            BW2  
 DESIGN:            MRB  
 REVIEWED:            JFW  
 SCALE:            1" = 60'  
 DATE:            OCTOBER 2019  
 DWG. NAME:            1933POT HOLE

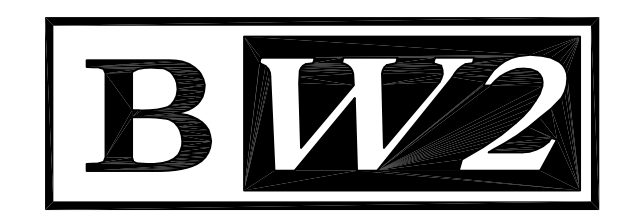

**BW2 ENGINEERS, INC.**  
 1919 S. Shiloh Road  
 Suite 500, L.B. 27  
 Garland, Texas 75042  
 (972) 864-8200 (T) (972) 864-8220 (F)  
 Firm Registration No. F-5290

THE SEAL THAT ORIGINALLY APPEARED ON THIS DOCUMENT WAS AUTHORIZED BY MICHAEL R. BURGE, TEXAS P.E. 41290 ON 10/31/19. ALTERATION OF A SEALED DOCUMENT WITHOUT PROPER NOTIFICATION OF THE RESPONSIBLE ENGINEER IS AN OFFENSE UNDER THE TEXAS ENGINEERING PRACTICE ACT.

**WATER LINE AND WASTEWATER LINE REPLACEMENT PROJECT**  
 (ST. MARY STREET, BOST STREET, AND SHERMAN STREET)  
**POT HOLE LOCATION MAP**  
**CITY OF ROCKWALL**

SHEET NO. **4**  
 OF **29** SHEETS  
 JOB NO. 19-1933