


CONSTRUCTION PLANS FOR
CITY OF ROCKWALL, TEXAS
 TO SERVE
SUMMER LEE DRIVE EXTENSION

INDEX OF DRAWINGS

A100	COVER SHEET
A101	GENERAL NOTES
P001	TYPICAL SECTIONS
P002	PAVING DETAILS
PI01	PAVING PLAN AND PROFILE - SUMMER LEE STA. 0+00 - 10+00
PI02	PAVING PLAN AND PROFILE - SUMMER LEE STA. 10+00 - 18+00
PI03	PAVING PLAN AND PROFILE - SUMMER LEE STA. 18+00 - 20+30
PI04	PAVING PLAN - HORIZON ROAD
M101	TRAFFIC PLAN FOR INTERSECTION AT SUMMER LEE AND HORIZON RD.
G101	GRADING PLAN
G102	GRADING PLAN
D001	DRAINAGE AREA MAP
D002	STORM DRAIN, INLET, AND STREET FLOW CALCULATIONS
D101	CULVERT 'A' PLAN AND PROFILE
D102	CULVERT 'B' PLAN AND PROFILE
D103	STORM DRAIN 'C' PLAN AND PROFILE
D201	DRAINAGE DETAILS
D202	DRAINAGE DETAILS
D203	DRAINAGE DETAILS
UI01	WATER PLAN AND PROFILE STA 0+00 TO 11+00
UI02	WATER PLAN AND PROFILE STA 11+00 TO 18+00
UI03	WATER PLAN AND PROFILE STA 18+00 TO 19+49.49
I101	STREET LIGHT PLAN
E001	STORM WATER POLLUTION PREVENTION NOTES
E002	STORM WATER POLLUTION PREVENTION NOTES
E003	STORM WATER POLLUTION PREVENTION NOTES
E101	STORM WATER POLLUTION PREVENTION PLAN
E201	STORM WATER POLLUTION PREVENTION DETAILS
E202	STORM WATER POLLUTION PREVENTION DETAILS

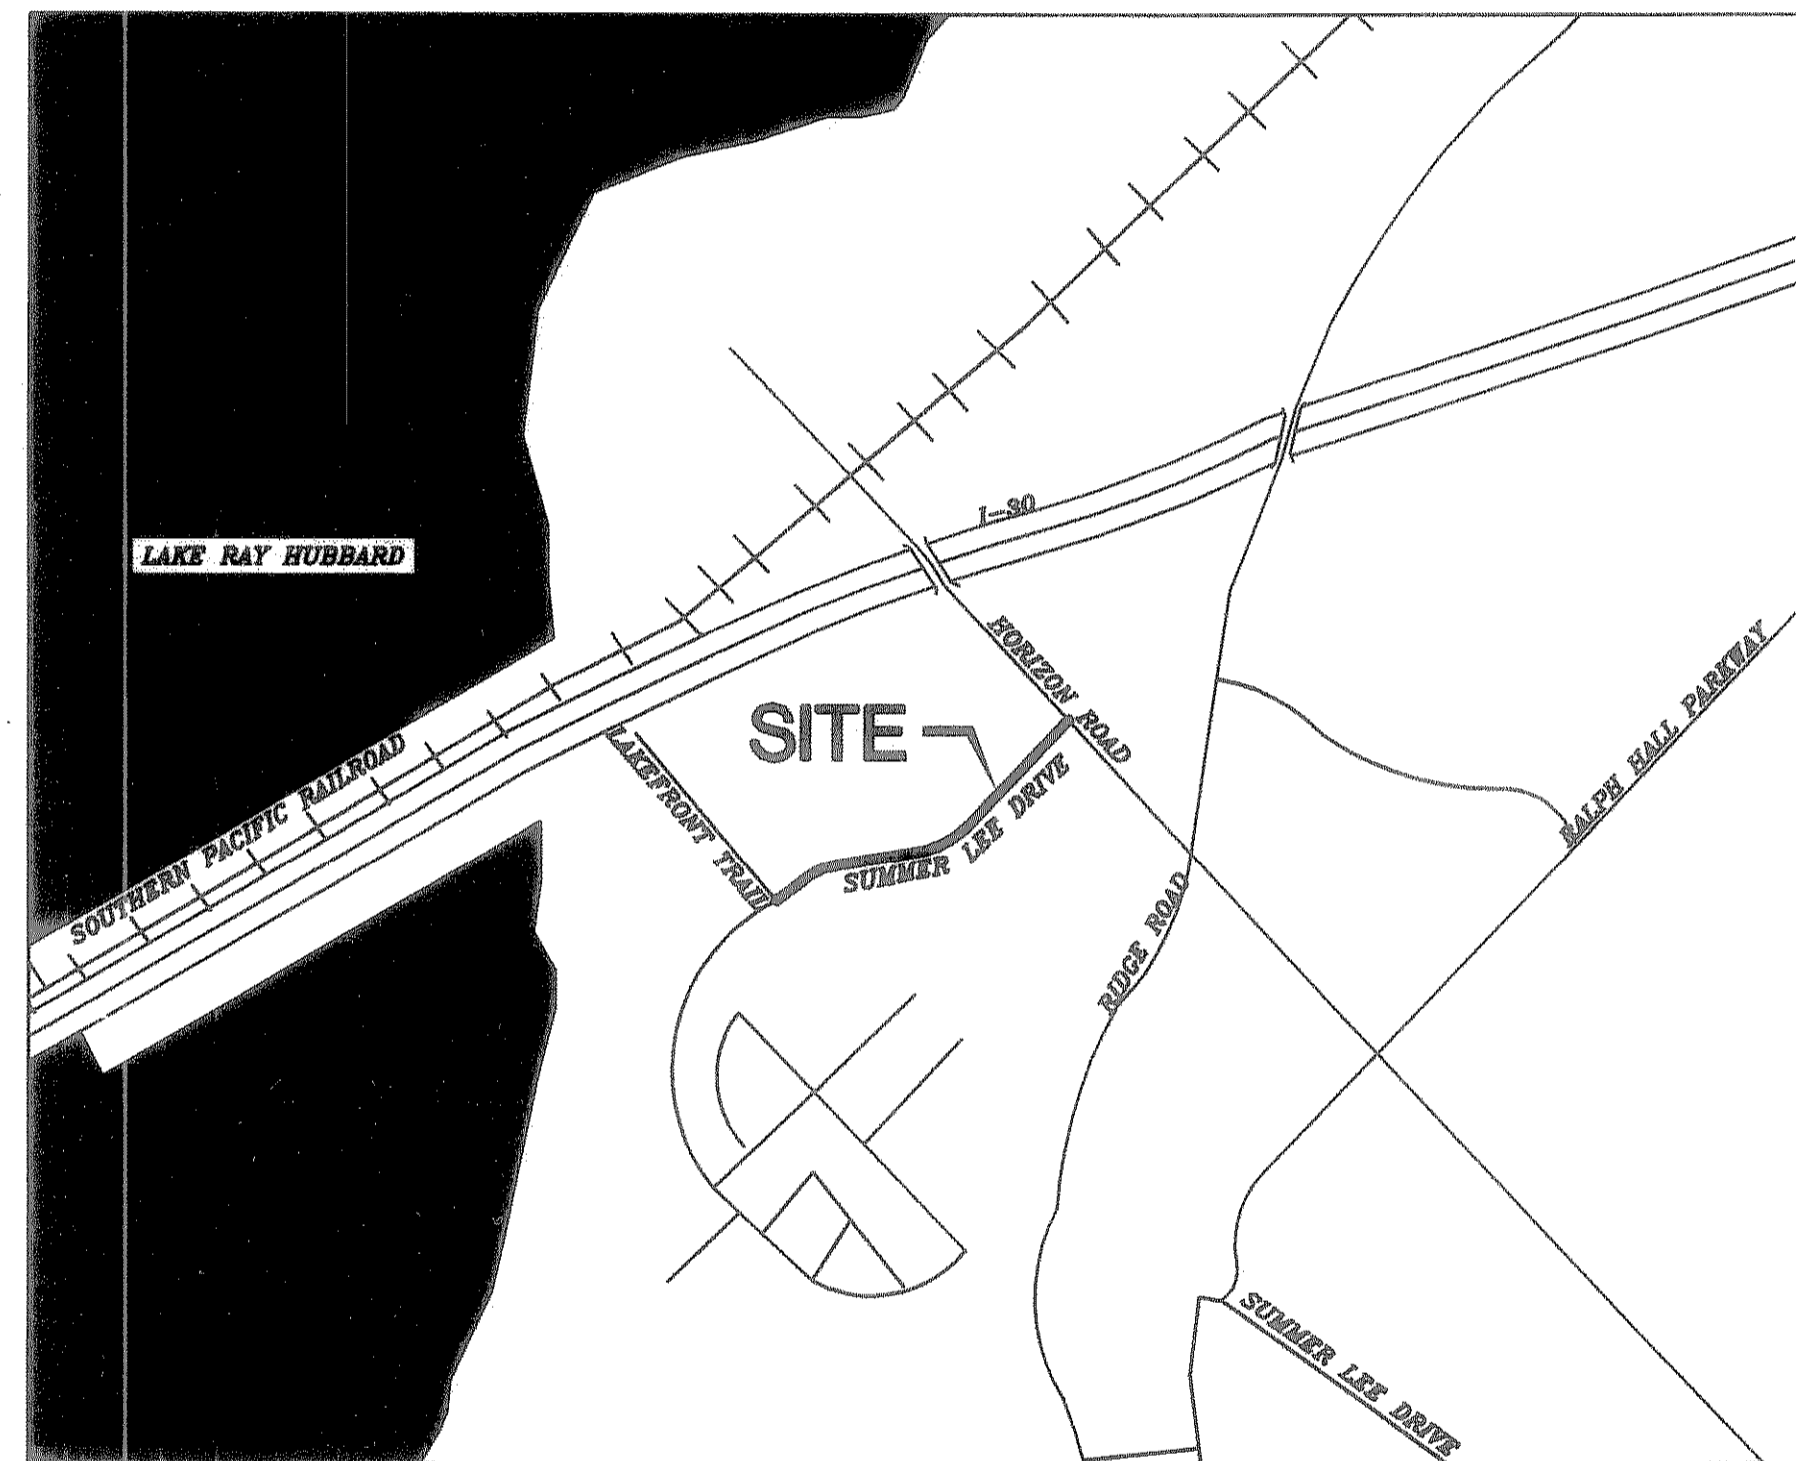

VICINITY MAP
N.T.S

KEN JONES - MAYOR

COUNCIL MEMBERS:

BOB COTTI - Mayor Pro Tem

TIM McCALLUM


STEPHEN STRAUGHAN

JOHN KING

TERRY RAULSTON


BILL CECIL

JULIE COUCH - City Manager

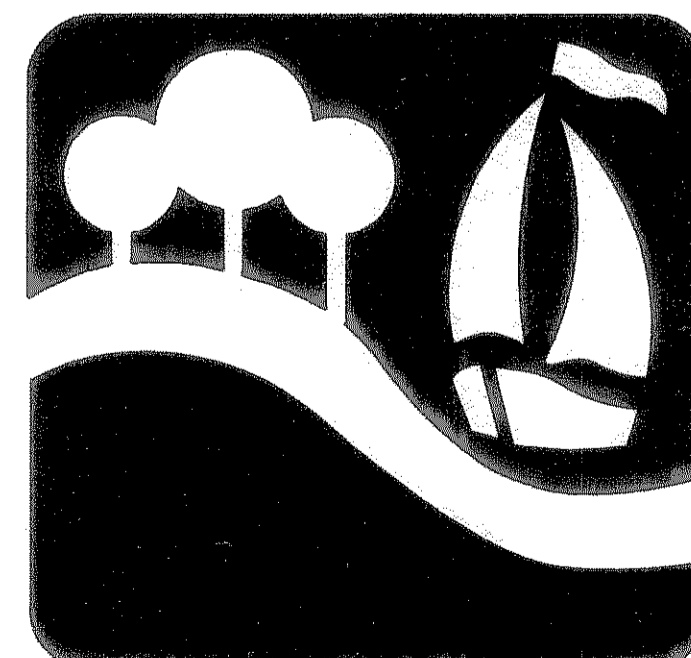

"THE NEW HORIZON"

FEBRUARY, 2005

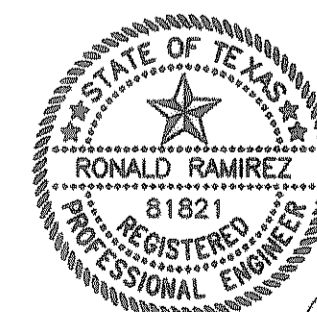

Ronald Ramirez
3/18/06

**RECORD
DRAWING**
07/12/06