

TIME: 11:27 FILE: GRADING1.dwg

THE CONTRACTOR SHALL PRESERVE AND PROTECT ALL EXISTING UTILITIES FROM DAMAGE DURING CONSTRUCTION. ANY DAMAGE BY THE CONTRACTOR TO EXISTING UTILITIES SHALL BE REPAIRED BY THE CONTRACTOR AT HIS EXPENSE. CONTACT ALL POSSIBLE UTILITY AND UNDERGROUND FACILITY OWNERS.


X-CUT SET IN CONCRETE AT THE END OF SUMMER LEE DRIVE AND ALSO BEING THE INTERSECTION WITH LAKEFRONT TRAIL. 477.19 FT.

X-CUT SET IN THE NORTHWEST CORNER OF A CURB INLET ALONG THE SOUTHEAST BOUND LAND OF HORIZON ROAD AND BEING SOUTHEASTERLY +/- 485 FEET FROM INTERSTATE 30 EAST BOUND ACCESS ROAD. 550.45 FT.

X-CUT SET IN CONCRETE MEDIAN FOR THE RIGHT HAND TURNING LANE AT THE SOUTHEAST CORNER OF THE INTERSECTION OF THE EAST BOUND ACCESS ROAD OF INTERSTATE 30 AND HORIZON ROAD. 559.94 FT.

LEGEND

- PROPOSED WATER LINE
- PROPOSED STORM DRAIN
- - - EXIST. SANITARY SEWER
- - - EXIST. WATER LINE
- - - EXIST. OVERHEAD ELECTRIC
- - - EXIST. UNDERGROUND ELEC.
- - - R.O.W. LINE
- - - LOT LINE
- ⊕ FIRE HYDRANT
- ⊕ STORM DRAIN INLET
- ⊕ SANITARY SEWER MANHOLE
- ⊕ WATER VALVES
- DIRECTION OF FLOW
- ⋯ EXISTING MAJOR CONTOUR
- ⋯ EXISTING MINOR CONTOUR
- PROPOSED MAJOR CONTOUR
- PROPOSED MINOR CONTOUR

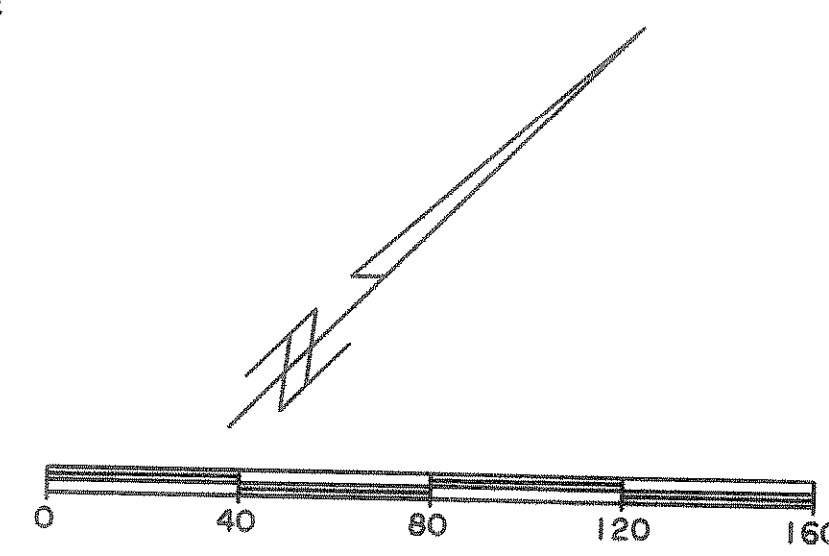

MATCH LINE
SEE SHEET G102


**RECORD
DRAWING**
07/12/06

PREPARED BY:
VIA WIER & ASSOCIATE
ENGINEERS SURVEYORS LAND PLANNERS
4300 BELWAY PLACE SUITE 130 ARLINGTON, TEXAS 76018 METRO
1380 U.S. HIGHWAY 207 N. SUITE 101 HANSFELD, TEXAS 76063 METRO
6848 ELM STREET FRISCO, TEXAS 75034 METRO (214)387-1111
www.viawierassociates.com



**CITY OF
ROCKWALL
SUMMER LEE DRIVE
EXTENSION**

GRADING PLAN

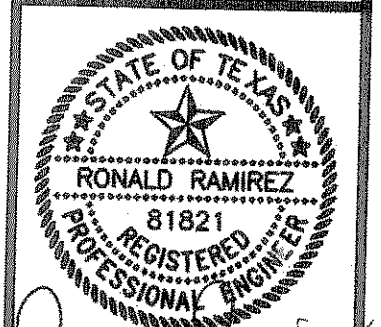

Ronald Ramirez
8/18/06

COPYRIGHT ©
WIER & ASSOCIATES, INC.
LAST SHEET EDIT
DATE 06-07-2005
WA# 03049

**SHEET NO.
G101**