


REVISION NO.	REMARKS	DATE
1.	TRANSITIONED AROUND TRANSFORMER SHEET 3	7/29/04
2.	HARBOR DEVELOPMENT CONSTRUCTED 12" WATERLINE IN PART OF LAKEFRONT	2/01/05

DESIGNED: A.J.W.
 DRAWN: ACAD
 DATE: 1/5/04

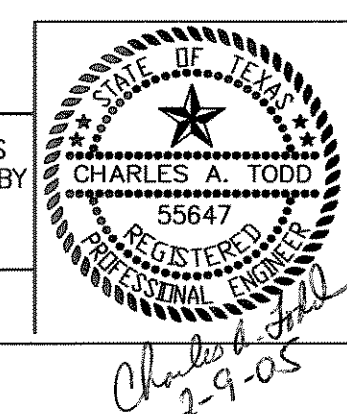

SUMMER LEE DRIVE
 PAVING STA. 0+00 TO 11+00
 12" WATER LINE
 CITY OF ROCKWALL
 "THE NEW HORIZON"