


CROSS SECTION
NTS

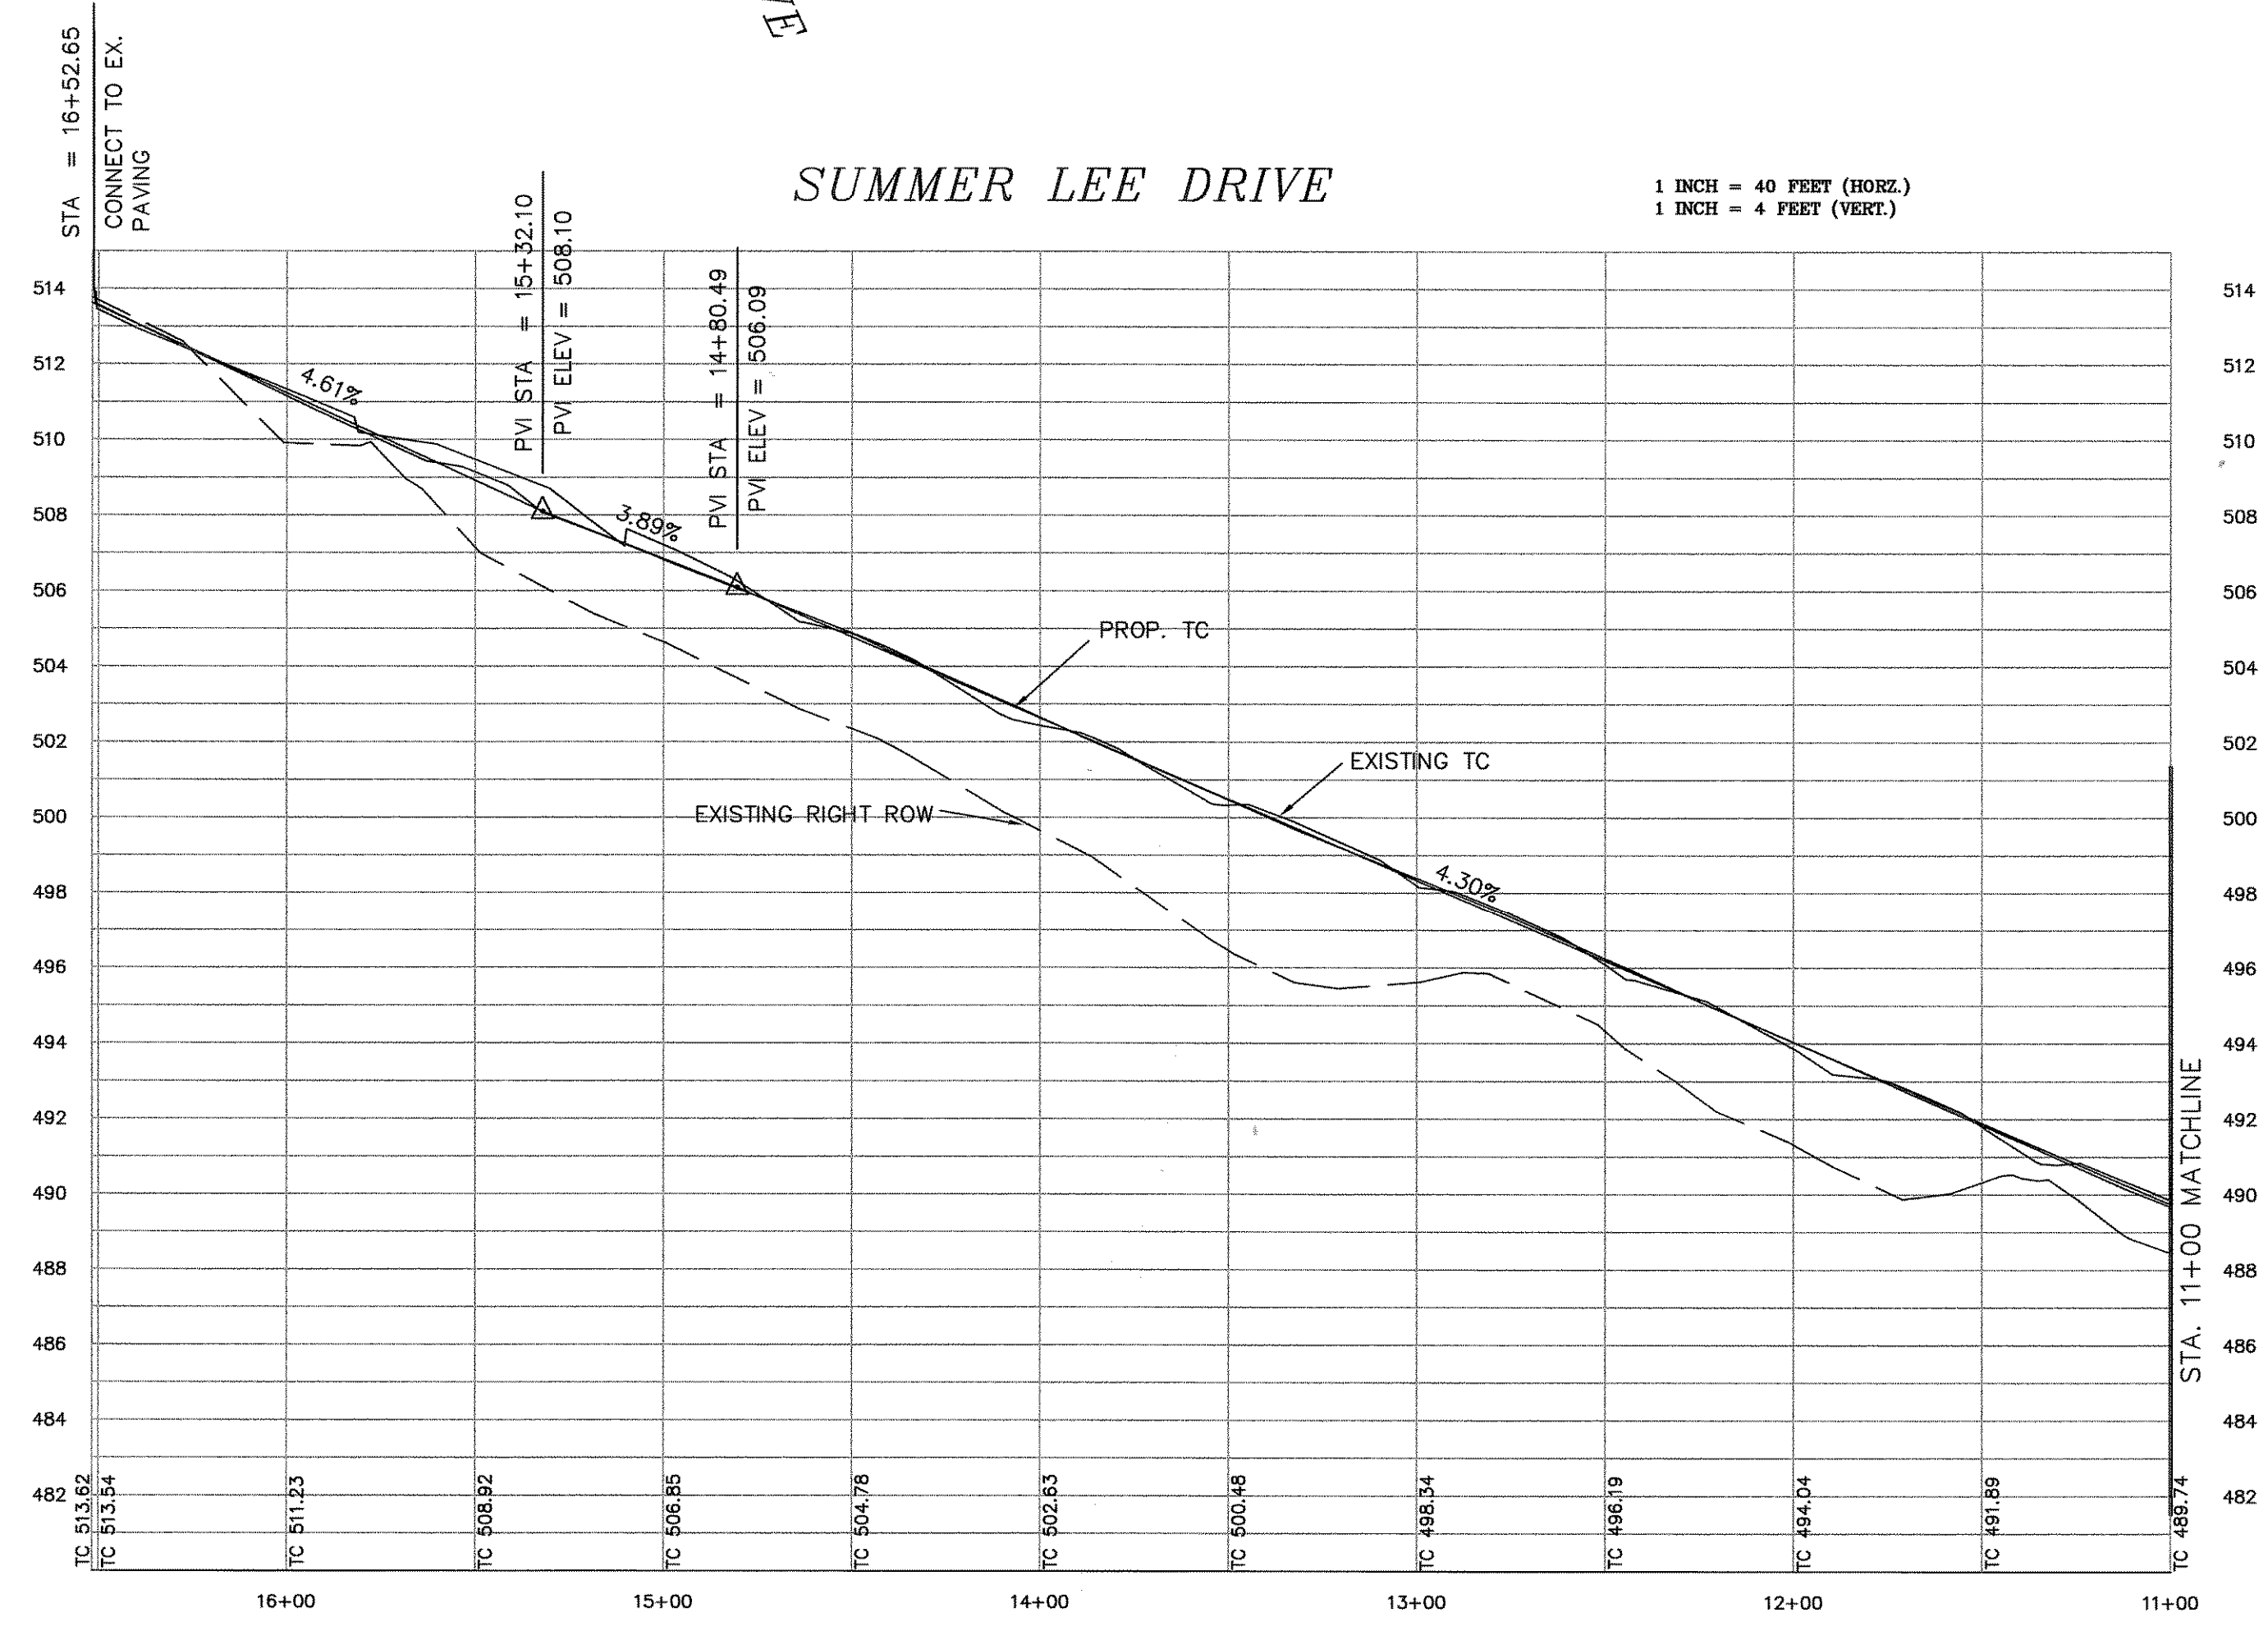

REVISION NO.	REMARKS	DATE
1.		
2.	TRANSITIONED AROUND TRANSFORMER HARBOR DEVELOPMENT CONSTRUCTED 12\"/>	7/29/04 2/01/05

SUMMER LEE DRIVE
PAVING STA. 11+00 TO 16+78.74
12\"/>

CITY OF ROCKWALL
"THE NEW HORIZON"

DESIGNED:	A.J.W.	THE SEAL APPEARING ON THIS DOCUMENT WAS AUTHORIZED BY CHARLES A. TODD TEXAS P.E. NO. 55647 ON
DRAWN:	ACAD	
DATE:	1/5/04	SHEET 3

Charles A. Todd
2-9-05