

DISCLAIMER: The use of this standard is governed by the "Texas Engineering Practice Act". No warranty of any kind is made by TxDOT for any purpose whatsoever. TxDOT assumes no responsibility for the conversion of this standard to other formats or for incorrect results or damages resulting from its use.

COMMENTS:

| | |
|----|--|
| 1 | |
| 2 | |
TABLE OF DIMENSIONS & REINFORCING STEEL
(Wings for One Structure End)

| Maximum Wingwall Height Hw | Dimensions | | | | Variable Reinforcing | | | | ③ Estimated Quantities per ft of wing length (2-Wings) Reinf (Lb/Ft) Conc (CY/Ft) | |
|----------------------------|------------|-------|-------|-------|----------------------|-------|---------|-------|--|-------|
| | W | X | Y | Z | Bars J1 | | Bars J2 | | | |
| 2'-6" | 2'-5" | 1'-0" | 9" | 7" | #4 | 1'-0" | #4 | 1'-0" | 33.73 | 0.248 |
| 3'-0" | 2'-5" | 1'-0" | 9" | 7" | #4 | 1'-0" | #4 | 1'-0" | 37.07 | 0.261 |
| 3'-6" | 2'-5" | 1'-0" | 9" | 7" | #4 | 1'-0" | #4 | 1'-0" | 37.74 | 0.273 |
| 4'-0" | 2'-5" | 1'-0" | 9" | 7" | #4 | 1'-0" | #4 | 1'-0" | 38.41 | 0.285 |
| 4'-6" | 3'-2" | 1'-6" | 1'-0" | 7" | #4 | 1'-0" | #4 | 1'-0" | 41.75 | 0.330 |
| 5'-0" | 3'-2" | 1'-6" | 1'-0" | 7" | #4 | 1'-0" | #4 | 1'-0" | 45.09 | 0.343 |
| 5'-6" | 3'-2" | 1'-6" | 1'-0" | 7" | #4 | 1'-0" | #4 | 1'-0" | 45.75 | 0.355 |
| 6'-0" | 3'-2" | 1'-6" | 1'-0" | 7" | #4 | 1'-0" | #4 | 1'-0" | 46.42 | 0.367 |
| 7'-0" | 3'-8" | 1'-9" | 1'-3" | 7" | #4 | 1'-0" | #4 | 1'-0" | 52.77 | 0.414 |
| 8'-0" | 4'-2" | 2'-0" | 1'-6" | 8" | #5 | 1'-0" | #4 | 1'-0" | 60.19 | 0.486 |
| 9'-0" | 4'-8" | 2'-3" | 1'-9" | 8" | #4 | 6" | #4 | 6" | 81.49 | 0.535 |
| 10'-0" | 5'-2" | 2'-6" | 2'-0" | 8" | #5 | 6" | #4 | 6" | 97.25 | 0.584 |
| 11'-0" | 5'-8" | 2'-9" | 2'-3" | 8" | #6 | 6" | #5 | 6" | 133.65 | 0.634 |
| 12'-0" | 6'-2" | 3'-0" | 2'-6" | 9" | #7 | 6" | #5 | 6" | 162.29 | 0.721 |
| 13'-0" | 6'-8" | 3'-3" | 2'-9" | 11" | #7 | 6" | #5 | 6" | 178.80 | 0.856 |
| 14'-0" | 7'-2" | 3'-6" | 3'-0" | 1'-0" | #8 | 6" | #5 | 6" | 216.78 | 0.959 |
| 15'-0" | 7'-8" | 4'-0" | 3'-0" | 1'-1" | #9 | 6" | #6 | 6" | 283.06 | 1.068 |
| 16'-0" | 8'-2" | 4'-6" | 3'-0" | 1'-3" | #9 | 6" | #6 | 6" | 297.02 | 1.234 |

TABLE OF WINGWALL REINFORCING
(2-Wings)

| Bar | Size | No. | Spa |
|-----|------|-----|-------|
| D | #5 | ~ | 1'-0" |
| E | #4 | ~ | 1'-0" |
| F | #4 | ~ | 1'-0" |
| G | #6 | 4 | ~ |
| M | #4 | 4 | ~ |
| P | #4 | ~ | 1'-0" |
| R | #5 | 6 | ~ |
| V | #4 | ~ | 1'-0" |

TABLE OF ESTIMATED CULVERT TOEWALL QUANTITIES

| Bar | Size | No. | Spa |
|---------------|------|-----|-------|
| L | #4 | ~ | 1'-6" |
| Q | #4 | 1 | ~ |
| Reinf (Lb/Ft) | | | 2.45 |
| Conc (CY/Ft) | | | 0.037 |




- Extend Bars P 3'-0" minimum into bottom slab of Box Culvert.
- Adjust to fit as necessary to maintain 1 1/4" clear cover and 4" minimum between bars.
- Quantities shown are based on an average wing height for two wings (one structure end). To determine total quantities for two wings multiply the tabulated values by Lw.
- Recommended values of Slope are: 2:1, 3:1, 4:1, & 6:1.
- When shown elsewhere on the plans, a 5" deep concrete riprap shall be constructed. Unless otherwise shown on the plans or directed by the Engineer, the riprap shall have a 6" wide by 1'-6" deep reinforced concrete toewall along all edges adjacent to natural ground; the toewall shall be reinforced by extending typical riprap reinforcing into the toewall; construction joints or grooved joints, oriented in the direction of flow, shall extend across the full distance of the riprap, at intervals of approximately 20'. When such riprap is provided, the culvert toewall shown in SECTION B-B will not be required. Payment for riprap shall be as required by the pertinent Item.
- At Contractor's option, Culvert Toewall may be ended flush with Wingwall Toewall. Adjust reinforcing from that shown as necessary.
- 0" min to 5'-0" max. For T6 or C6 Rail, see T6-CM standard for additional details. For curbs without rail and greater than 1'-0" high, see ECD standard for additional details. Estimated curb heights are shown elsewhere in the plans.
- For vehicle safety, curb heights and wall heights shall be reduced, if necessary, to provide a maximum 3" projection above finished grade. No changes will be made in quantities and no additional compensation will be allowed for this work.

WING DIMENSION CALCULATIONS:


Formulas: (All values are in Feet)
 $Hw = H + T + C - 0.250'$
 $A = (Hw - 0.333') (SL)$
 $B = (A) \text{ Tangent } (30^\circ)$
 $Lw = (A) \div \text{Cosine } (30^\circ)$
 For Cast-in-place culverts:
 $Ltw = (N) (S) + (N+1) (U)$
 For Precast culverts:
 $Ltw = (N) (2U+S) + (N-1) (0.500')$
 $\text{Total Wingwall Area (Two Wings ~ S.F.)} = (Hw + 0.333') (Lw)$

Hw = Height of Wingwall
 SL:1 = Side Slope Ratio (Horizontal:1 Vertical)
 Lw = Length of Wingwall
 Ltw = Culvert Toewall Length
 N = Number of Culvert Spans

See applicable box culvert standard for H, S, T, and U values.

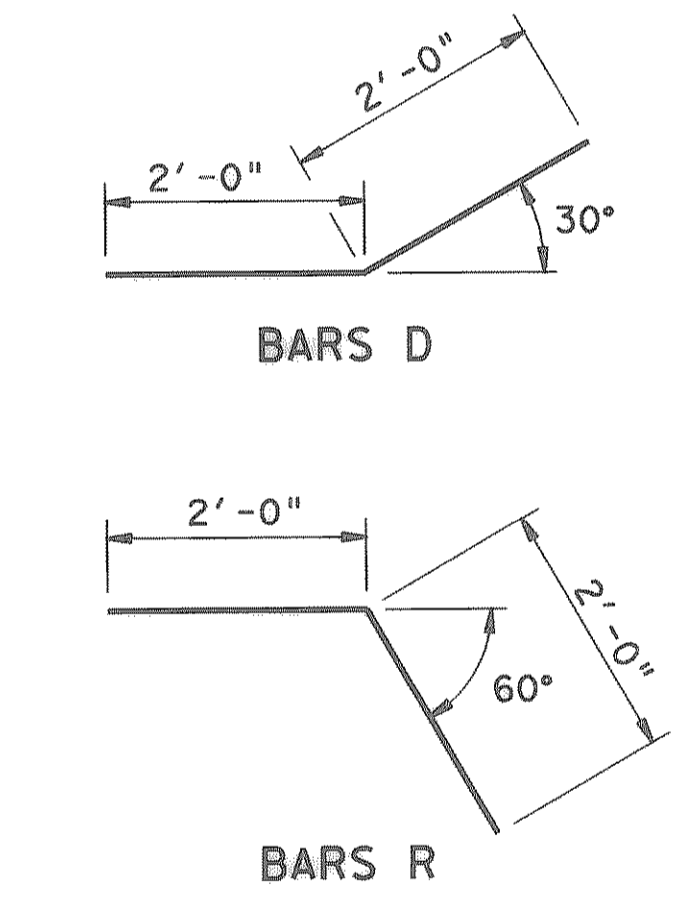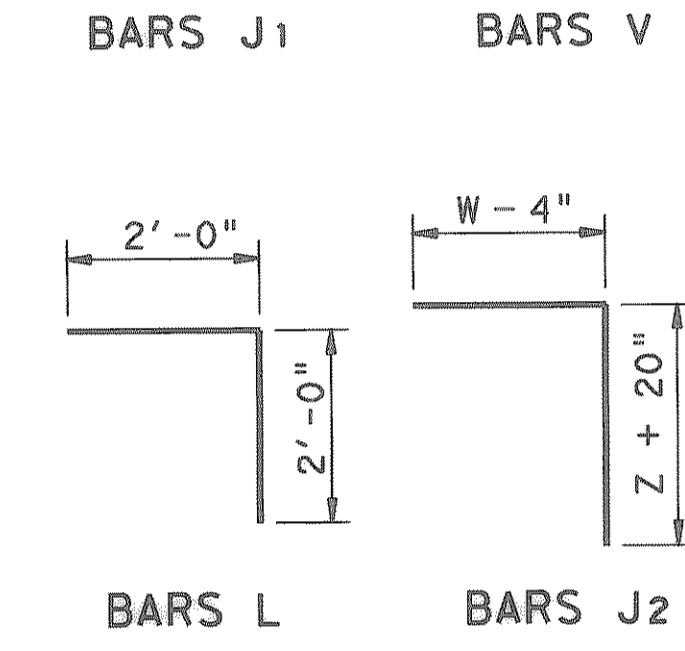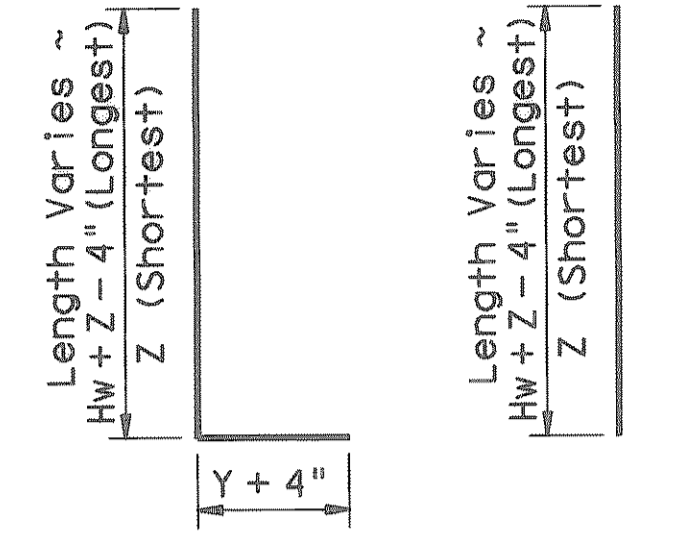


GENERAL NOTES:
 Designed according to current AASHTO Standard and Interim Specifications.
 All reinforcing steel shall be Grade 60.
 All concrete shall be Class "C" and shall have a minimum 28 day compressive strength of 3600 psi.
 All reinforcing bars shall be adjusted to provide a minimum of 1 1/4" clear cover.
 When structure is founded on solid rock, depth of toewalls for culverts and wingwalls may be reduced or eliminated as directed by the Engineer.
 See BCS sheet for additional dimensions and information.
 The quantities for concrete and reinforcing steel resulting from the formulas given on this sheet are for Contractor's information only.

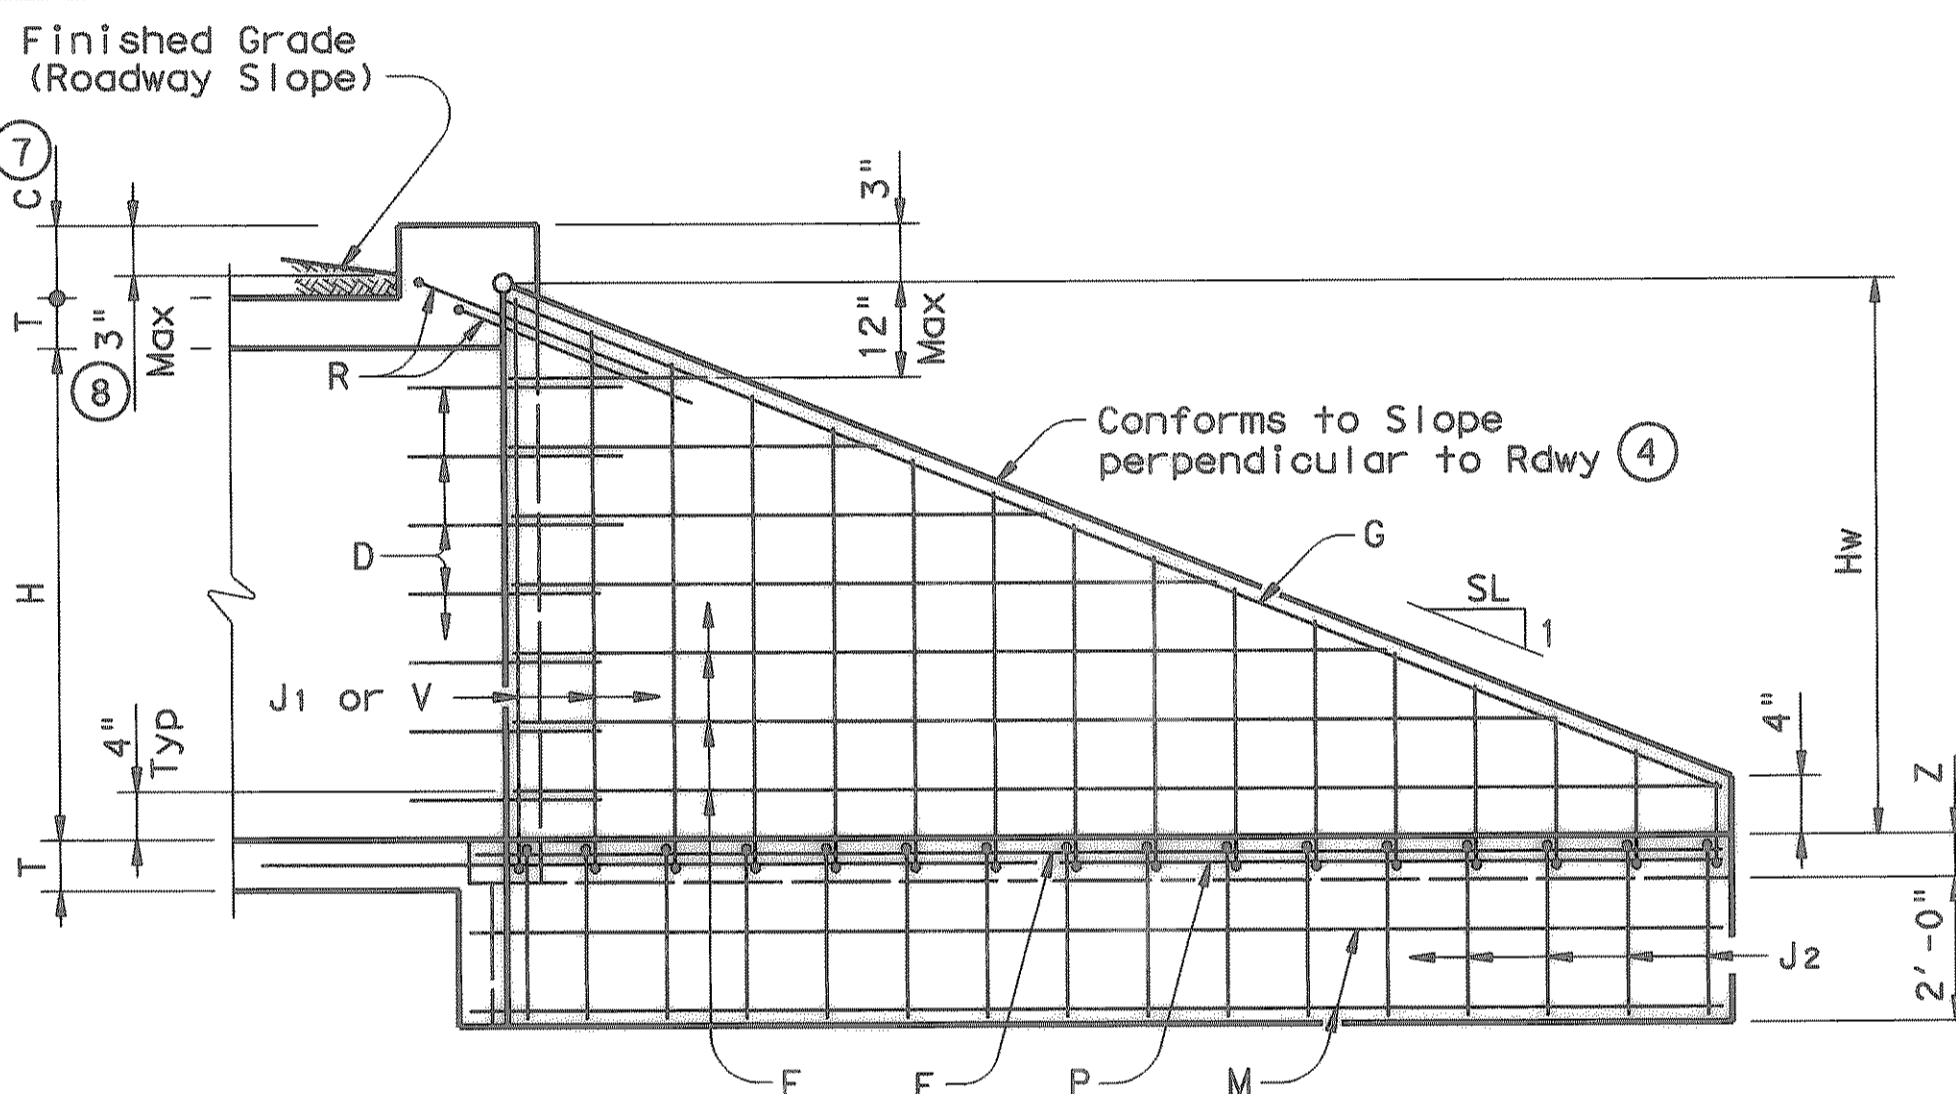


INSIDE ELEVATION

(Showing reinforcing. Culvert and Culvert Toewall reinforcing not shown for clarity.)

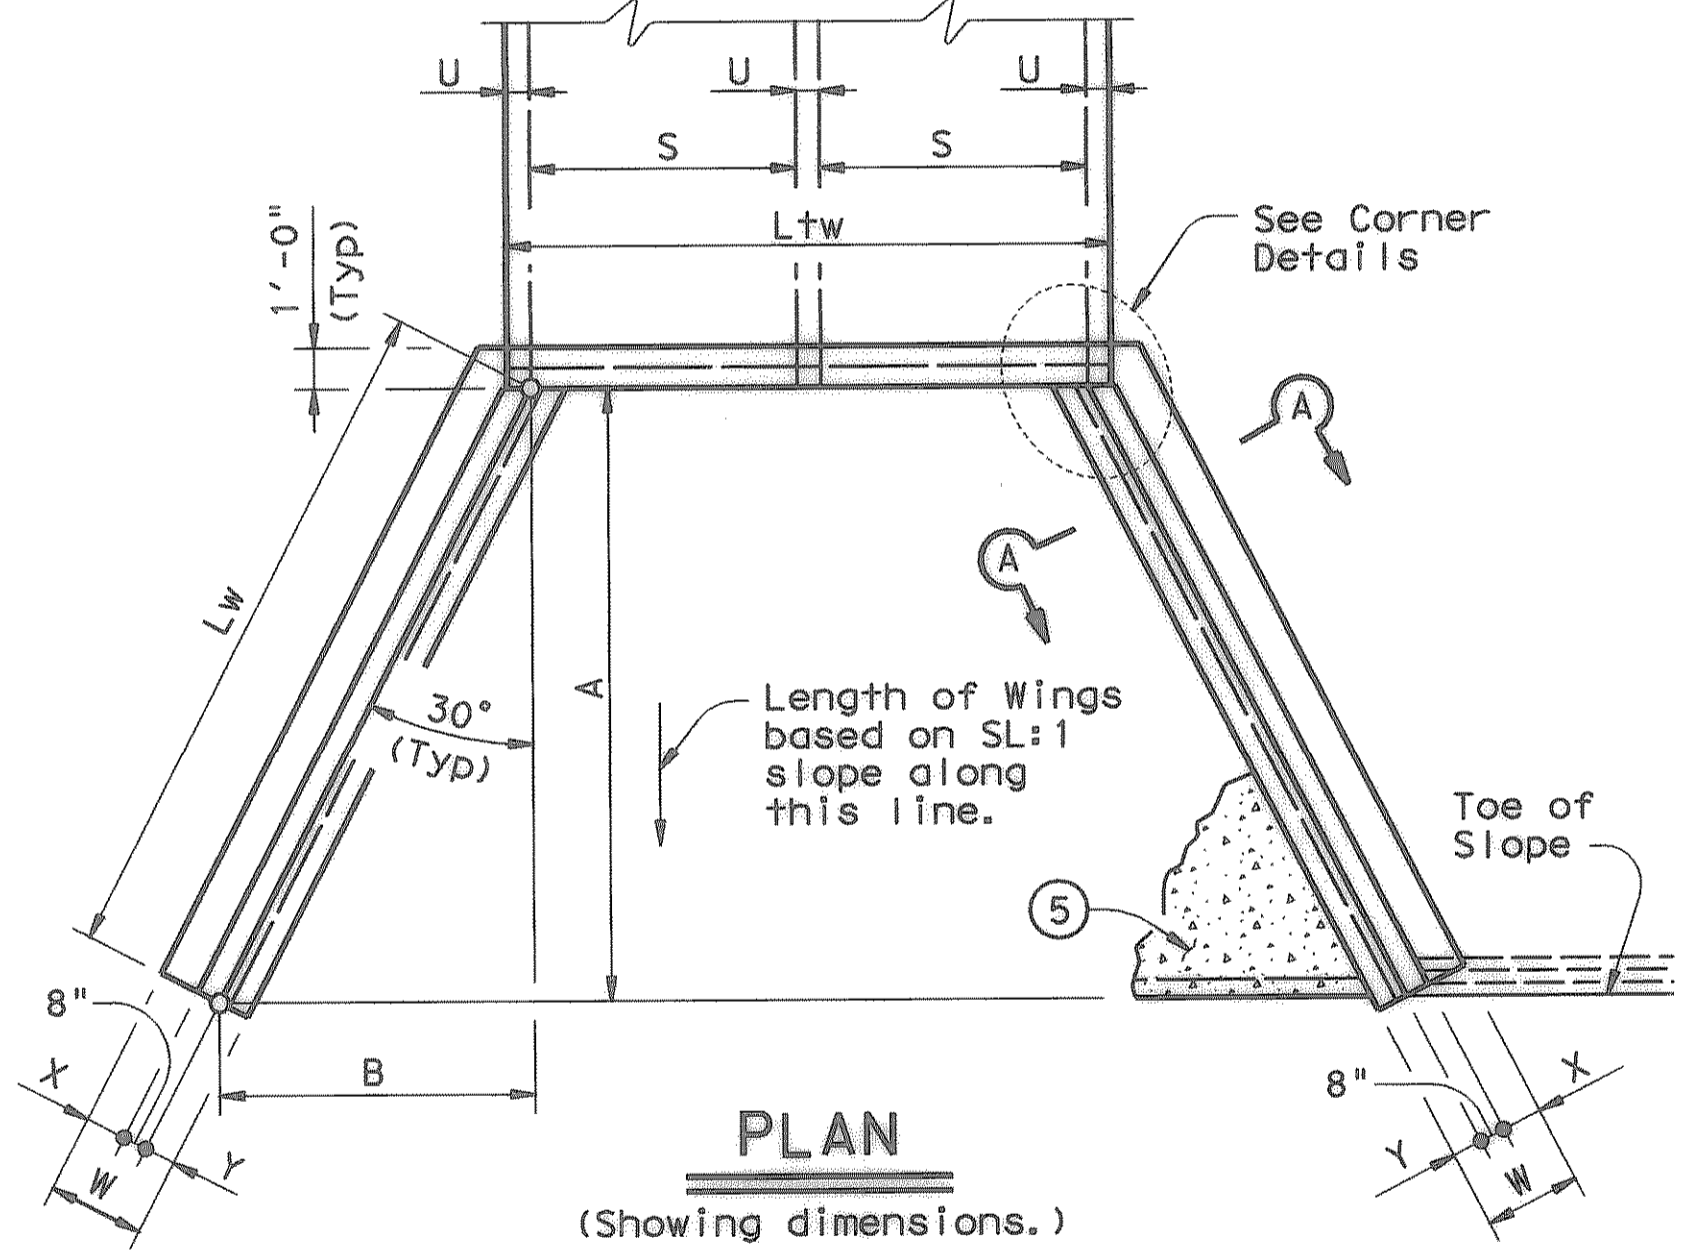


PLAN

(Showing dimensions.)

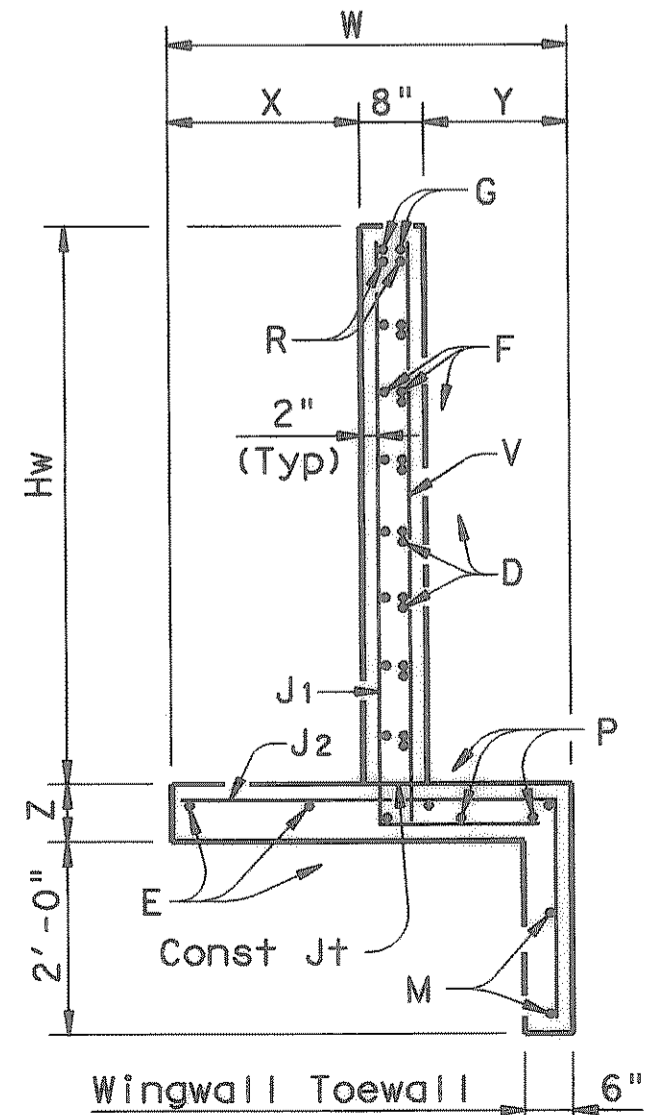


SECTION A-A

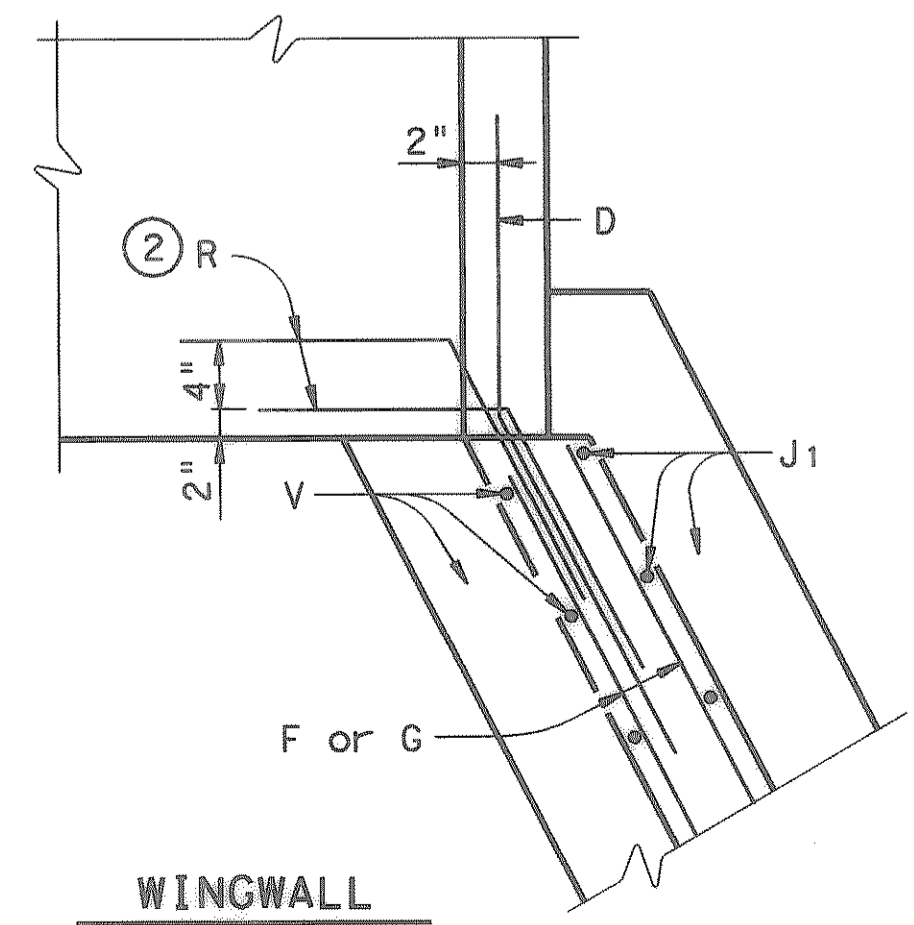


CORNER DETAILS

(Culvert and Culvert Toewall reinforcing not shown for clarity.)

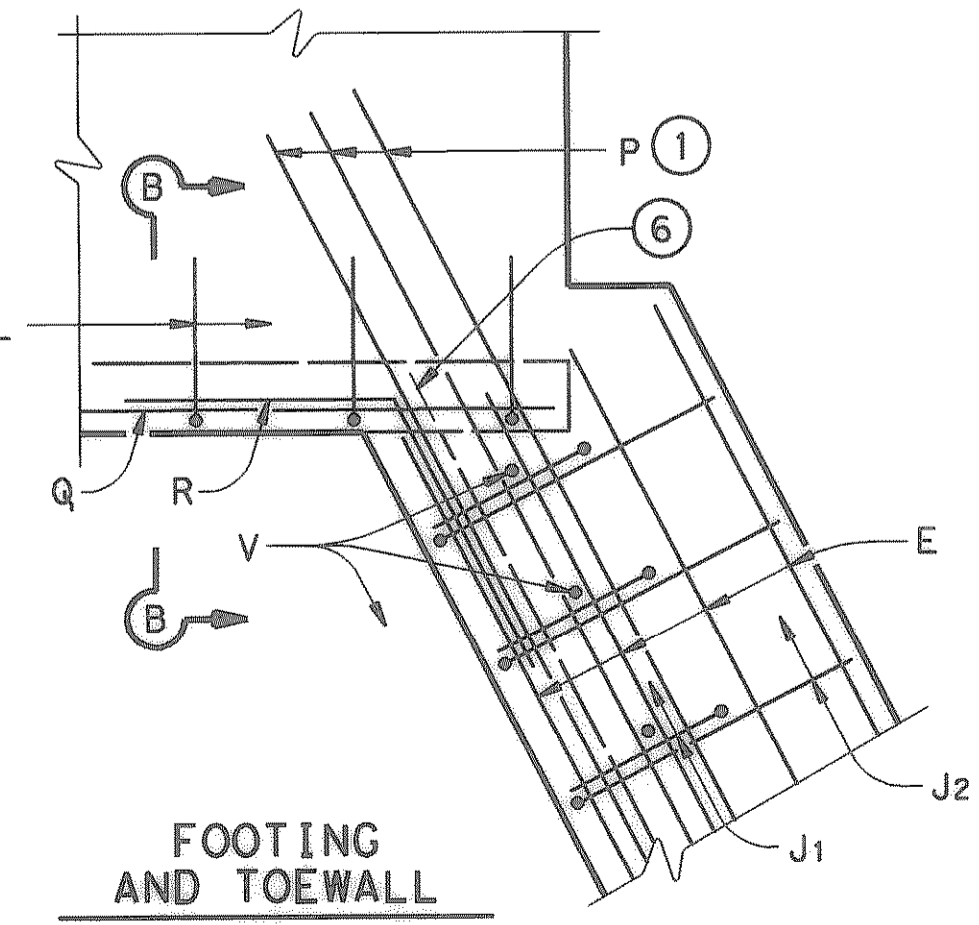

FOOTING AND TOEWALL

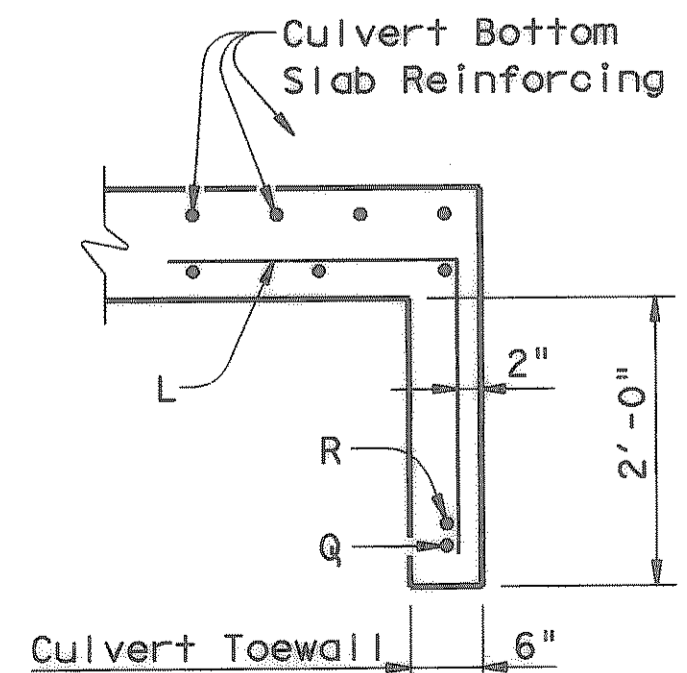

SECTION B-B

RECORD DRAWINGS
 These record drawings have been prepared using information provided by the Construction Contractor and/or Owner. The seal and signature below only signifies that the plans have been revised in accordance with the information provided and does not guarantee that these plans accurately show every detail of the constructed project.
 Signature: [Signature] Date: 4-2002

Texas Department of Transportation
 Bridge Division

FLARED WINGS FOR 0° SKEW BOX CULVERTS

FW-0

| | | | | |
|------------------------|----------|---------------------|-----------|---------|
| FILE: fw-0std.dgn | DN: GAF | CK: CAT | DW: TxDOT | CK: GAF |
| © TxDOT September 2000 | DISTRICT | FEDERAL AID PROJECT | | SHEET |
| REVISIONS | | | | 58 |
| | COUNTY | CONTROL | SECT | JOB |
| | | | | HIGHWAY |