
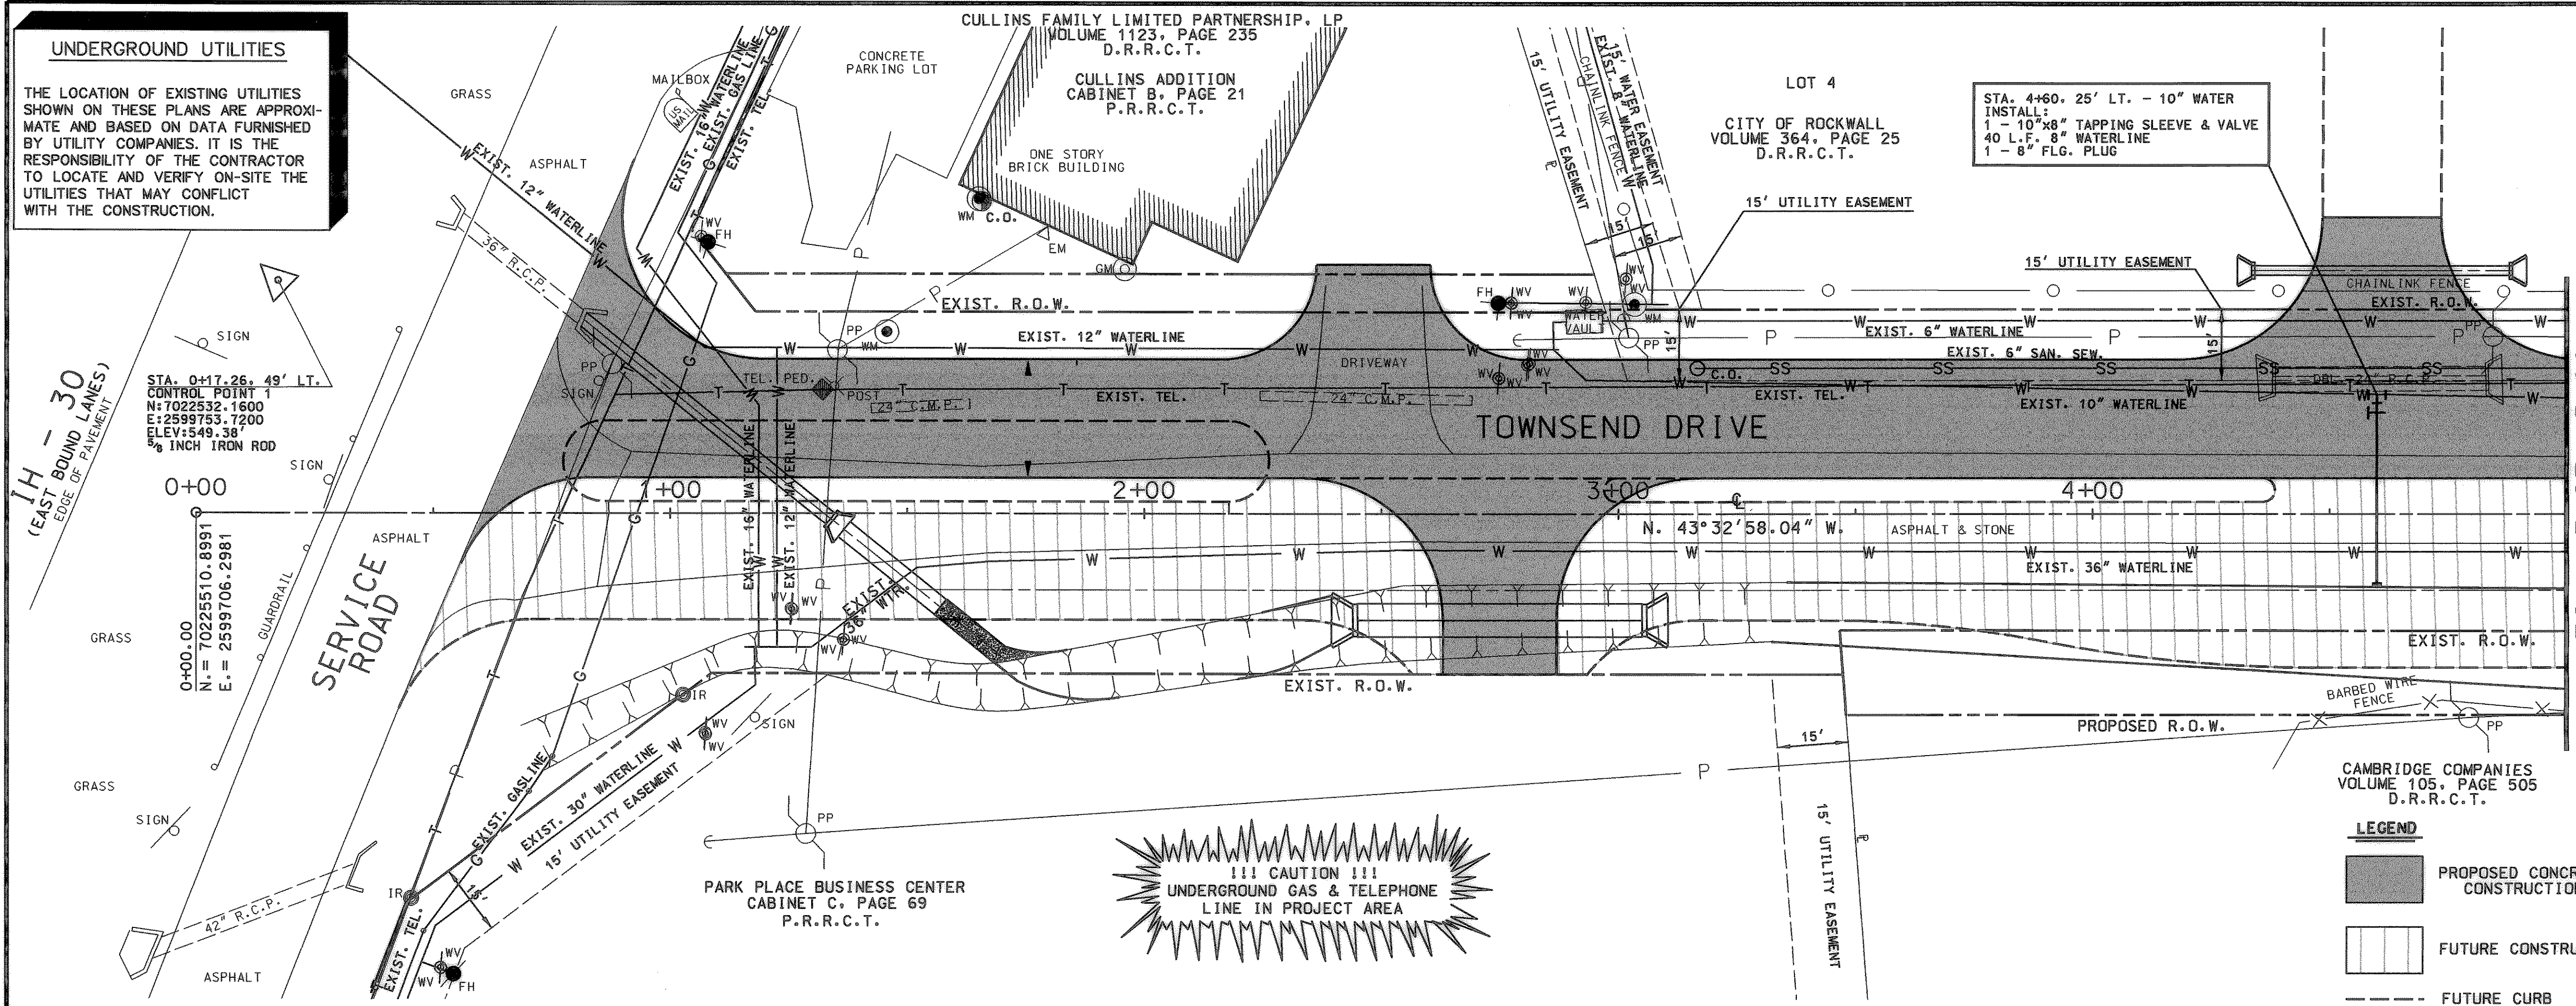


**UNDERGROUND UTILITIES**

THE LOCATION OF EXISTING UTILITIES SHOWN ON THESE PLANS ARE APPROXIMATE AND BASED ON DATA FURNISHED BY UTILITY COMPANIES. IT IS THE RESPONSIBILITY OF THE CONTRACTOR TO LOCATE AND VERIFY ON-SITE THE UTILITIES THAT MAY CONFLICT WITH THE CONSTRUCTION.

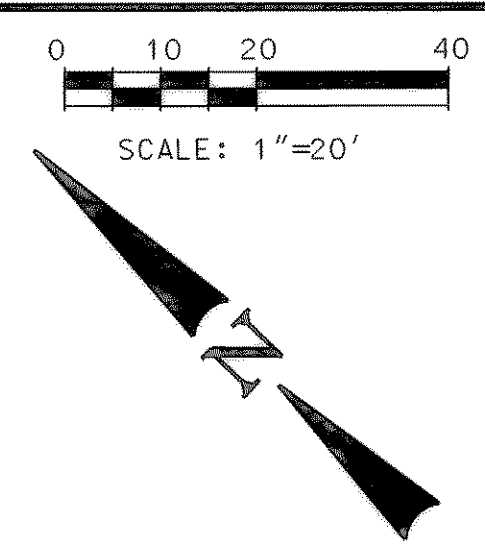


**LEGEND**


[Symbol]	POWER POLE
[Symbol]	GUY WIRE
[Symbol]	TELEPHONE BOX
[Symbol]	POST
[Symbol]	SIGN
[Symbol]	IRON ROD
[Symbol]	FIRE HYDRANT
[Symbol]	WATER METER
[Symbol]	MAILBOX
[Symbol]	WATER METER
[Symbol]	GAS METER
[Symbol]	CHAIN LINK FENCE
[Symbol]	WOOD FENCE
[Symbol]	BARBED WIRE FENCE
[Symbol]	APPROXIMATE TELEPHONE LINE
[Symbol]	APPROXIMATE GAS LINE
[Symbol]	APPROXIMATE WATER LINE
[Symbol]	OVERHEAD POWER LINE

**LEGEND**

[Hatched Area]	PROPOSED CONCRETE CONSTRUCTION
[Dotted Area]	FUTURE CONSTRUCTION
[Dashed Line]	FUTURE CURB

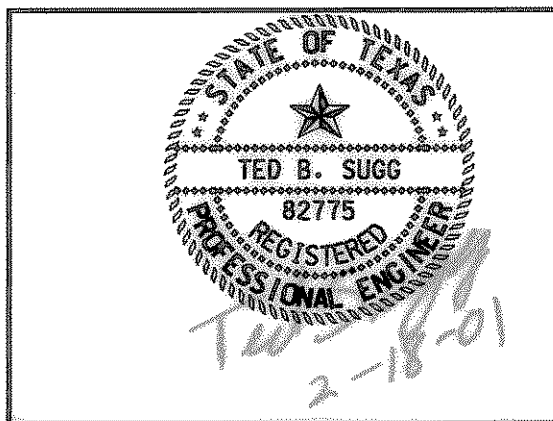

**!!! CAUTION !!!**  
 UNDERGROUND GAS & TELEPHONE LINE IN PROJECT AREA

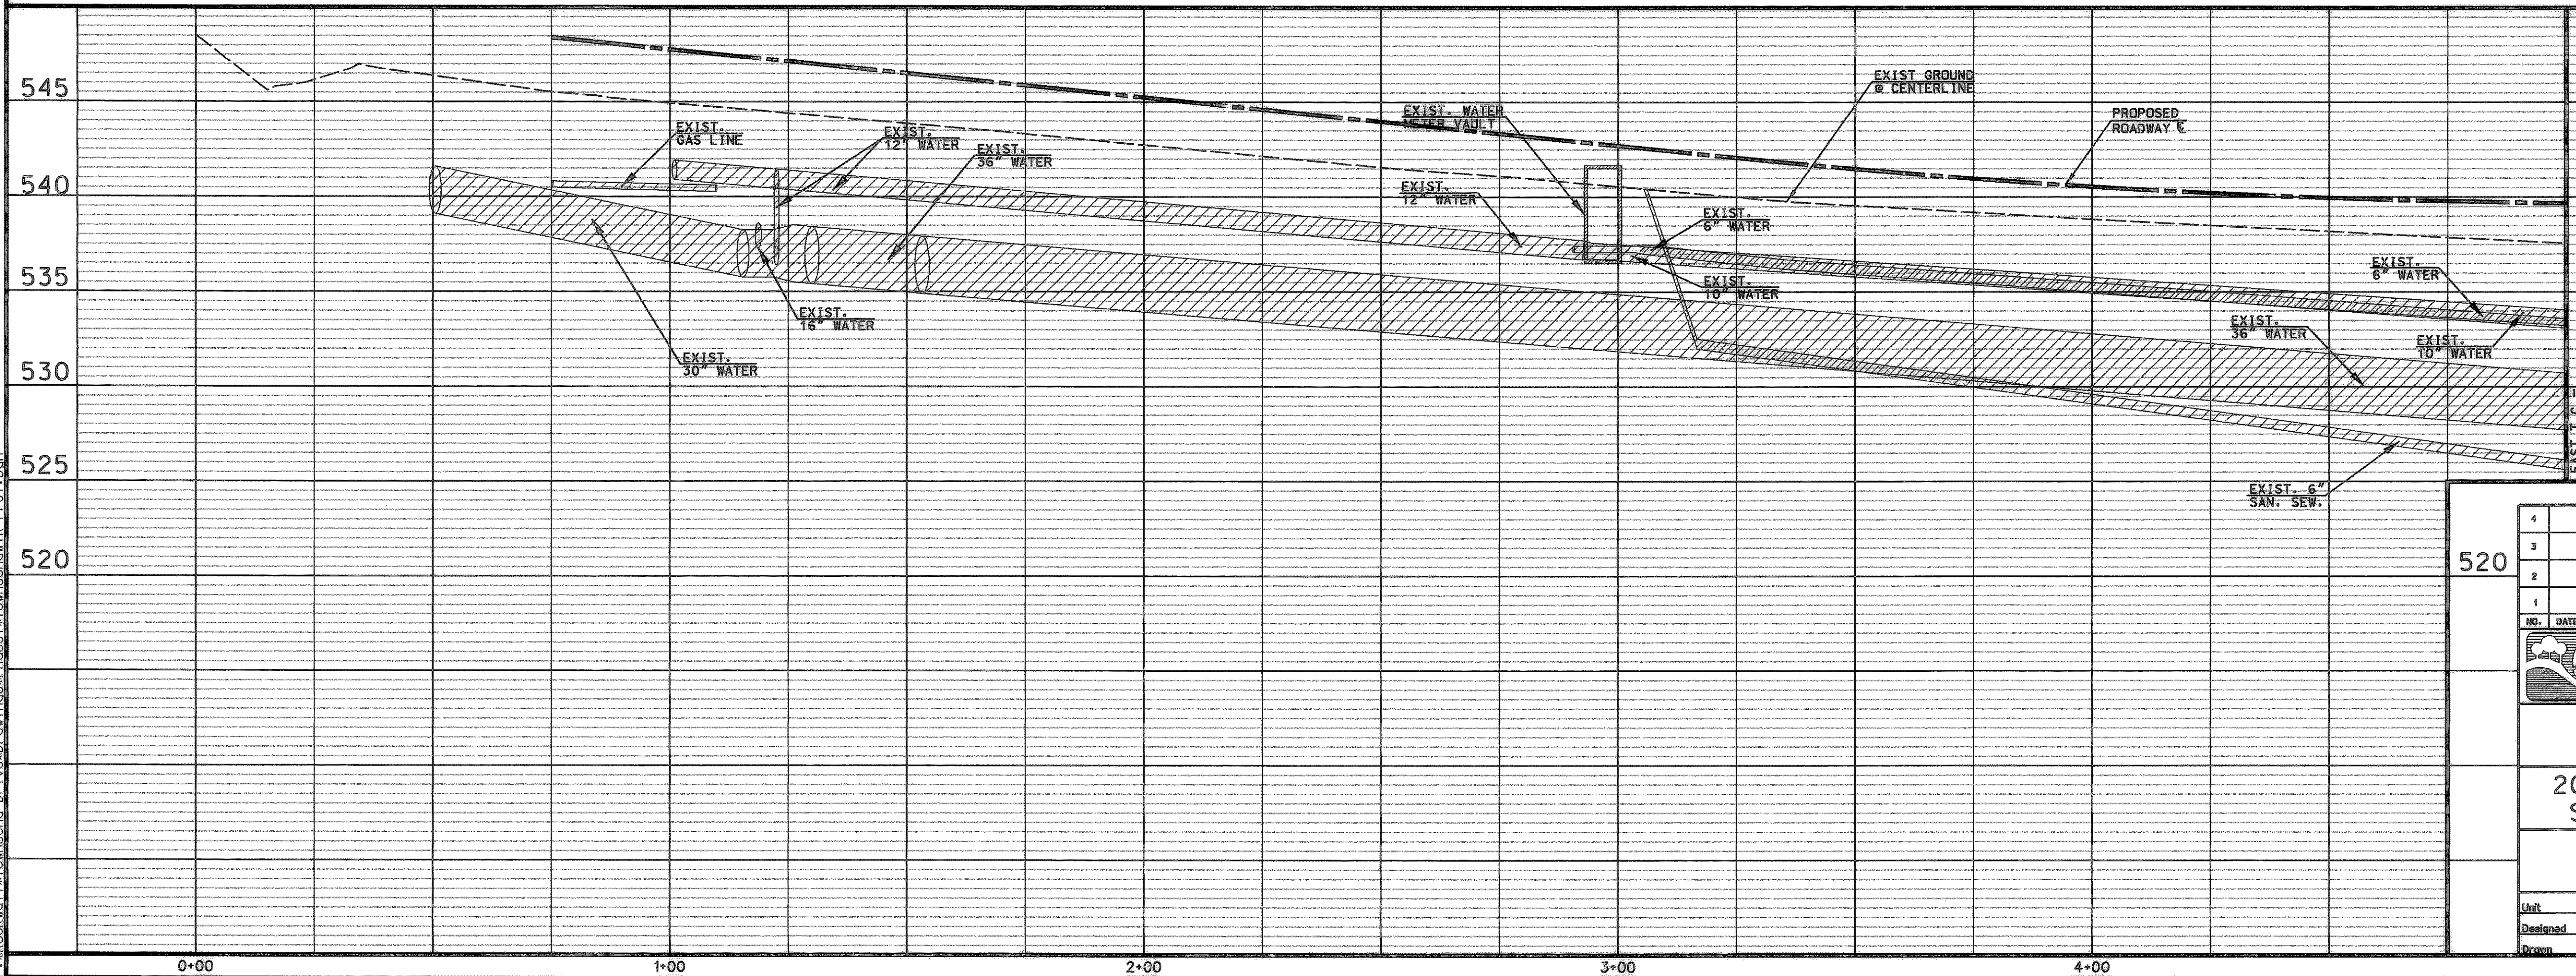

MATCHLINE STA. 5+00

**RECORD DRAWINGS**

These record drawings have been prepared using information provided by the Construction Contractor and/or Owner. The seal and signature below certify and affirm that the plans have been reviewed in accordance with the information provided and does not constitute that these plans accurately show every detail of the constructed project.

*Signature* \_\_\_\_\_ Date \_\_\_\_\_

4			
3			
2			
1			
NO.	DATE	REVISION	APPROV.
<b>CITY OF ROCKWALL</b> "THE NEW HORIZON"			
<b>TOWNSEND DRIVE</b> 20" WATERLINE - LINE "A" STA. 0+00 TO STA. 5+00			
<b>TurnerCollie &amp; Braden Inc.</b> ENGINEERS • PLANNERS • PROJECT MANAGERS			
Unit	A123	Scale	Horz. 1"=20' Vert. 1"=5'
Designed	VVS	Checked	TBS
Drawn	GBA	Approved	RCR
Date	FEBRUARY, 2001	Job No.	15-00925-200
		Sheet	31 of 72

P:\Rockwall\Townsend\_Drives\Drawings\Phase1\Townsend\TR\_PP01.dwg