



ADVANCED WARNING SIGN DETAIL
N.T.S.

RECORD DRAWINGS
These record drawings have been prepared using information provided by the Construction Contractor and/or Owner. The seal and signature below only signifies that the plans have been revised in accordance with the information provided and does not guarantee that these plans accurately show every detail of the constructed project.

Thomasina 4-2-02
Signature Date

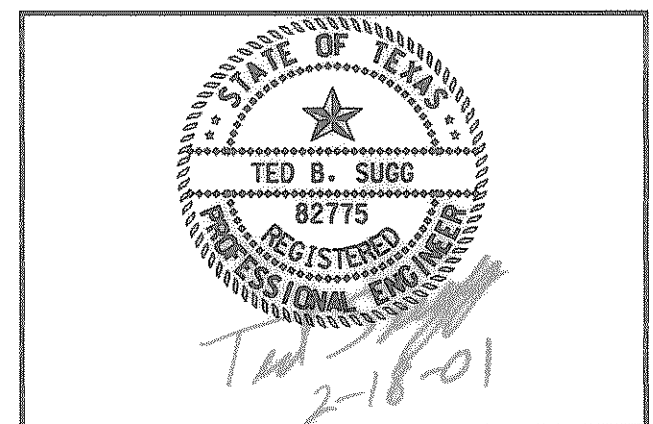

4			
3			
2			
1			
NO.	DATE	REVISION	APPROV.
 CITY OF ROCKWALL "THE NEW HORIZON"			
TOWNSEND DRIVE			
ADVANCED WARNING SIGNS			
Turner Collie & Braden Inc. <small>ENGINEERS • PLANNERS • PROJECT MANAGERS</small>			
Unit	A125	Scale Horz. Vert. 1"=20'	Date FEBRUARY, 2001
Designed	VVS	Checked TBS	Job No. 15-00925-200
Drawn	GBA	Approved RCR	Sheet 45 of 72