

UNDERGROUND UTILITIES

THE LOCATION OF EXISTING UTILITIES SHOWN ON THESE PLANS ARE APPROXIMATE AND BASED ON DATA FURNISHED BY UTILITY COMPANIES. IT IS THE RESPONSIBILITY OF THE CONTRACTOR TO LOCATE AND VERIFY ON-SITE THE UTILITIES THAT MAY CONFLICT WITH THE CONSTRUCTION.

DAVID G & SHIRLEY J LANDUA
VOLUME 674, PAGE 16
D.R.R.C.T.


STA. 25+73.40, 32.50' LT.
L 13' DRIVEWAY.
MATCH EXISTING.

STA. 26+39.52, 49' LT.
CONTROL POINT 1428
N: 7020659.2400
E: 2601541.5500
ELEV: 533.51'
5/8" INCH IRON ROD

CONNECT PROPOSED STORM SEWER TO WINGWALL SEE DRAINAGE SHEETS

INSTALL 8" CONCRETE APRON WITH #4 BARS @ 12" C-C EACH WAY

INSTALL STONE RIP RAP BETWEEN ENCASED SANITARY SEWER AND BOX CULVERTS. STONE RIPRAP SHALL COVER BOTTOM AND SIDE OF CHANNELS, INCLUDING THE AREA BEHIND THE WINGWALLS. SEE NOTE.

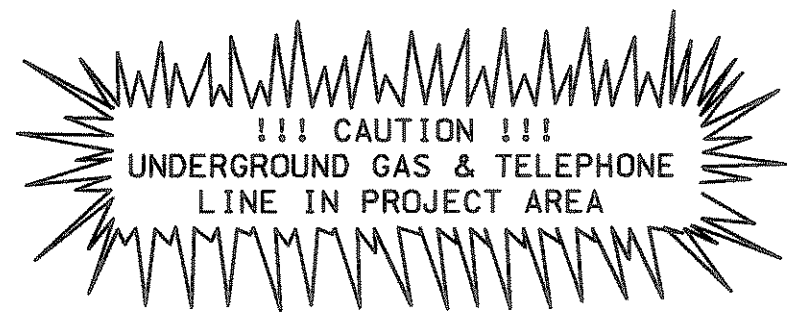

REGRADE CHANNEL TO TRANSITION TO BOX CULVERT

CONSTRUCT 98 L.F. GUARD RAIL

TXDOT RETAINING WALL RW-1(L)C
TOP OF WALL (SOUTH) 532.50
TOP OF WALL FOOTING (SOUTH) 522.50
H=11'

CONNECT 18" R.C.P. CULVERT TO BOX CULVERT

INSTALL 4' HEADWALL TXDOT ECD

(SKEW BOX CULVERT) ENDS 45° PER TXDOT MC-45° 75'

INSTALL 8" CONCRETE APRON WITH #4 BARS @ 12" C-C EACH WAY

INSTALL STRAIGHT WINGWALL TXDOT SW-0 HW= 12'

INSTALL 4' HEADWALL TXDOT ECD


INSTALL FLARED WINGWALL TXDOT FW-0 HW= 12'

INSTALL FLARED WINGWALL TXDOT FW-0 HW= 12'

CONNECT PROPOSED STORM SEWER TO WINGWALL SEE DRAINAGE SHEETS

INSTALL 4' HEADWALL TXDOT ECD

INSTALL 6' 8" X 8' BOX CULVERTS TXDOT MC-8-13

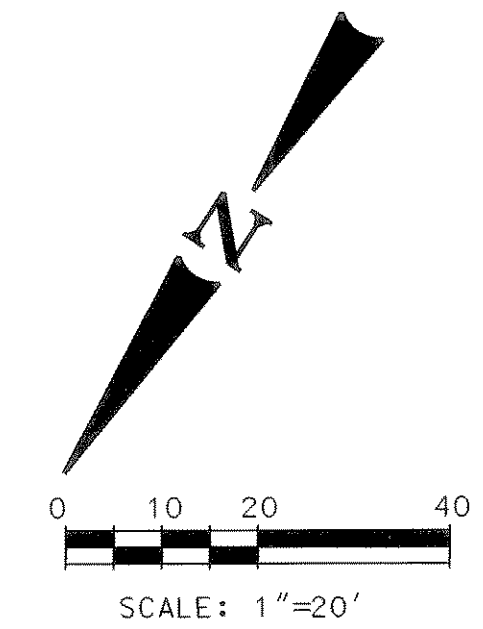

CAMBRIDGE COMPANIES
VOLUME 105, PAGE 505
D.R.R.C.T.

NOTE:
FOR DETAILS ON PLACEMENT OF RIP-RAP, SEE STANDARD DRAINAGE DETAILS SHEET 56A


LEGEND

- PROPOSED CONCRETE CONSTRUCTION
- FUTURE CONSTRUCTION
- FUTURE CURB

THOMAS REAL ESTATE L.P.
VOLUME 1507, PAGE 203
D.R.R.C.T.

INSTALL STONE RIP RAP BETWEEN ENCASED SANITARY SEWER AND BOX CULVERTS. STONE RIPRAP SHALL COVER BOTTOM AND SIDE OF CHANNELS INCLUDING THE AREA BEHIND THE WINGWALLS. SEE NOTE.


STA. 25+43.92 - R.O.W. =
E. 6 - 8' X 8' R.C.B.
N. = 7020659.43
E. = 2601449.94

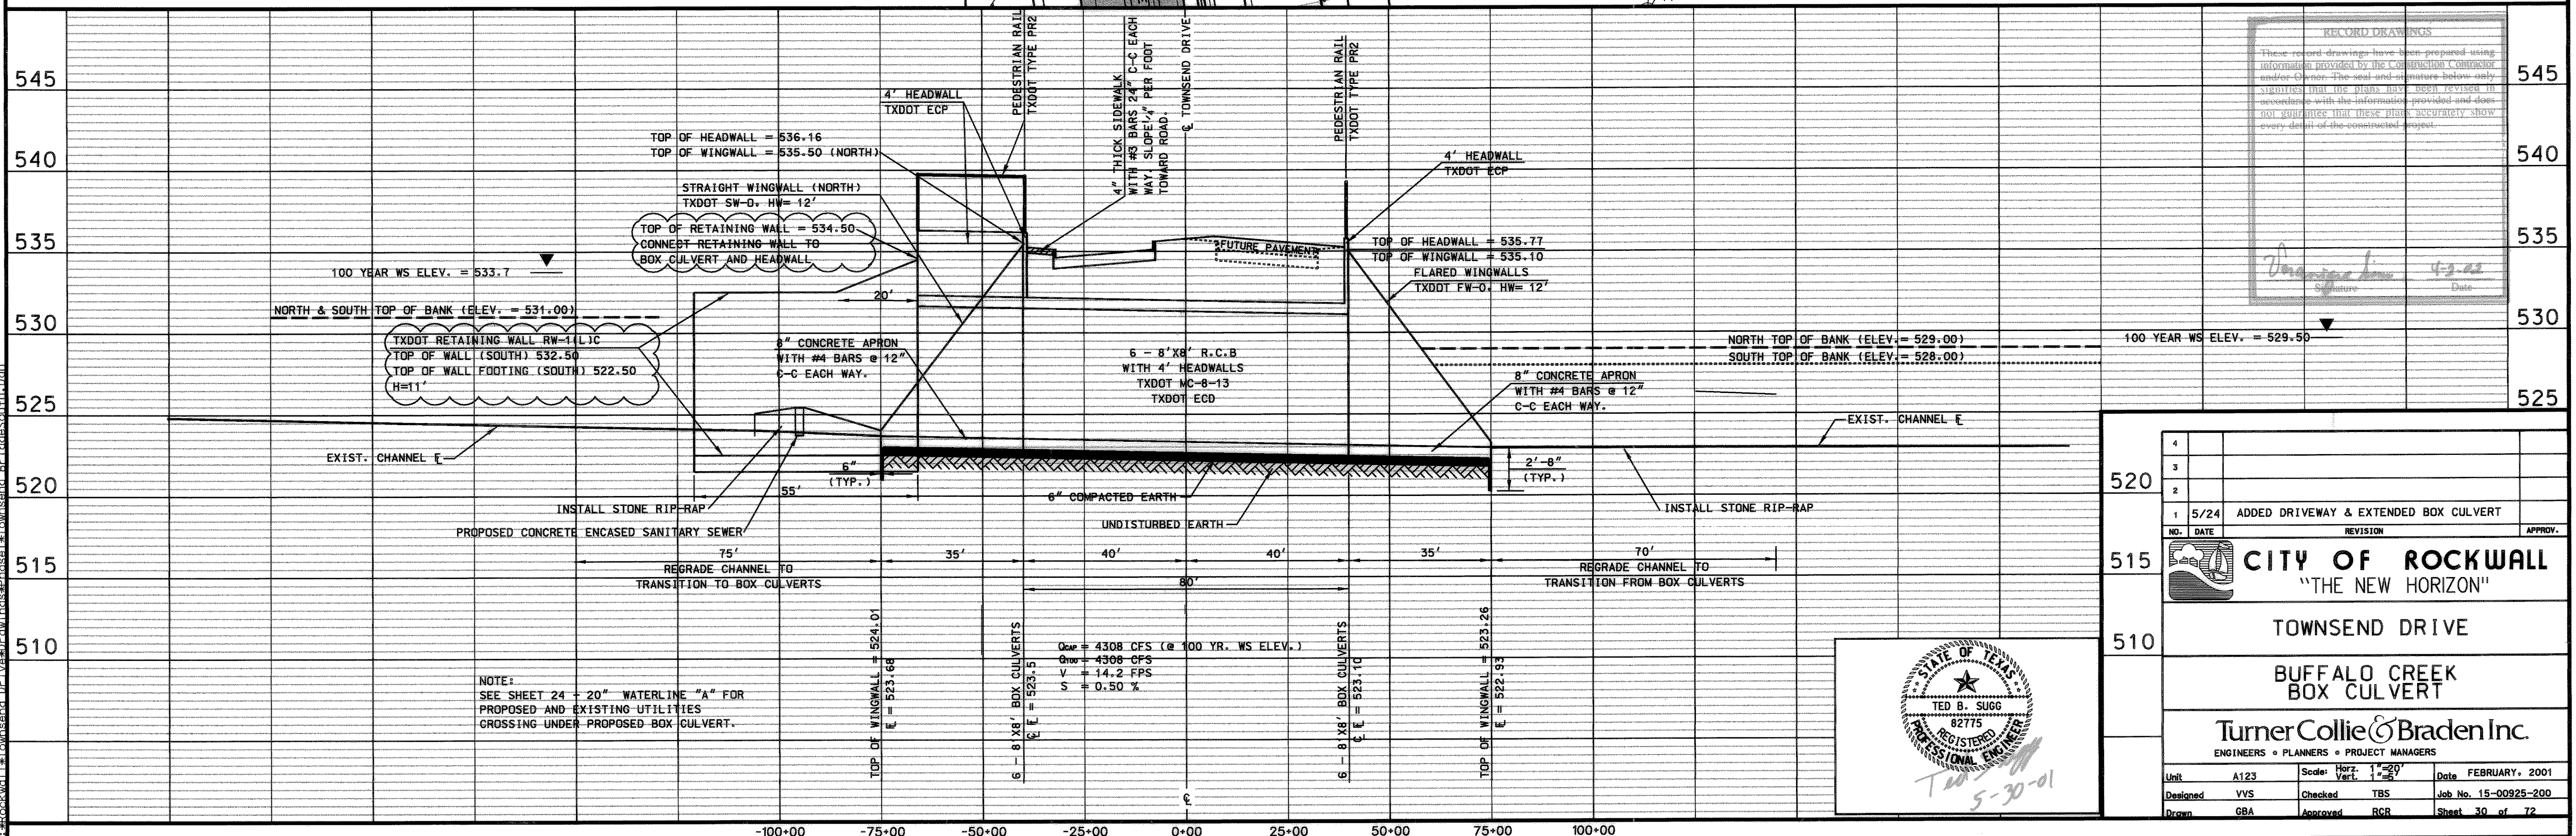

RECORD DRAWINGS

These record drawings have been prepared using information provided by the contractor's engineer and/or client. The user and contractor are solely responsible for the accuracy of the information provided and do not guarantee that these plans accurately show every detail of the constructed project.

Signature 4-2-02
Date

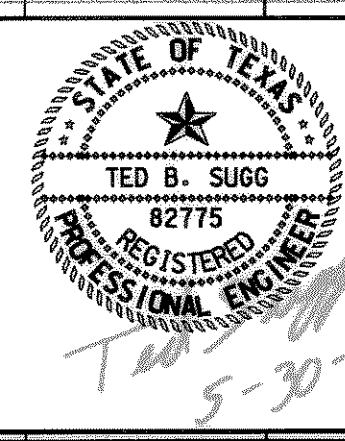

4			
3			
2			
1	5/24	ADDED DRIVEWAY & EXTENDED BOX CULVERT	
NO.	DATE	REVISION	APPROV.
CITY OF ROCKWALL "THE NEW HORIZON"			
TOWNSEND DRIVE			
BUFFALO CREEK BOX CULVERT			
Turner Collie & Braden Inc. ENGINEERS • PLANNERS • PROJECT MANAGERS			
Unit	A123	Scale: Horiz. 1"=20' Vert. 1"=5'	Date FEBRUARY, 2001
Designed	VVS	Checked TBS	Job No. 15-00925-200
Drawn	GBA	Approved RCR	Sheet 30 of 72