


PHASE II


- LEGEND
- CONSTRUCTION THIS PHASE
  - CONSTRUCTION PREVIOUS PHASE

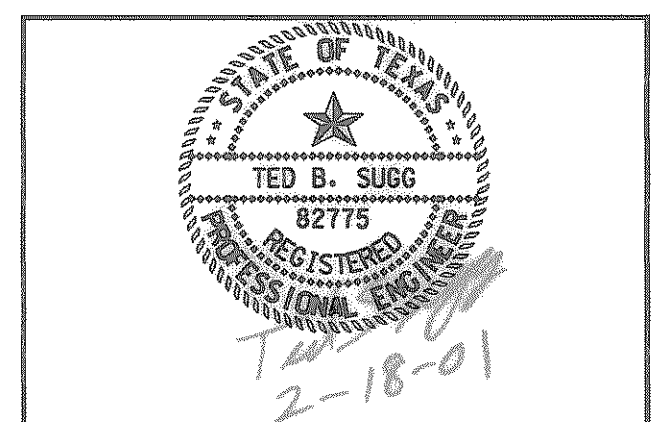

RECORD DRAWINGS

These record drawings have been prepared using information provided by the Construction Contractor and/or Owner. The seal and signature below only signifies that the plans have been revised in accordance with the information provided and does not guarantee that these plans accurately show every detail of the constructed project.

*Thomas Braden*  
Signature Date 4-2-02

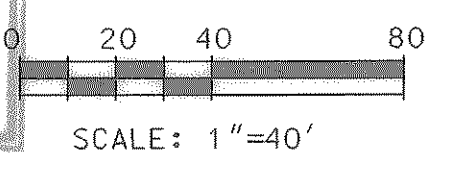

4			
3			
2			
1			
NO.	DATE	REVISION	APPROV.
<b>CITY OF ROCKWALL</b> "THE NEW HORIZON"			
<b>TOWNSEND DRIVE</b>			
<b>CONSTRUCTION PHASING - PHASE 2</b>			
<b>Turner Collie &amp; Braden Inc.</b> <small>ENGINEERS • PLANNERS • PROJECT MANAGERS</small>			
Unit	A123	Scale: Horz. 1"=40' Vert. 1"=10'	Date FEBRUARY, 2001
Designed	VVS	Checked TBS	Job No. 15-00925-200
Drawn	GBA	Approved RCR	Sheet 47 of 72

P:\rockwall\Townsend.Dr\Townsend\_Phase2.dwg