


RECORD DRAWINGS
 These record drawings have been prepared using information provided by the Construction Contractor and/or Owner. The seal and signature below only signifies that the plans have been revised in accordance with the information provided and does not guarantee that the drawings accurately show every detail of the constructed project.

Voranique Y. Simon 4/2/00
 Signature Date

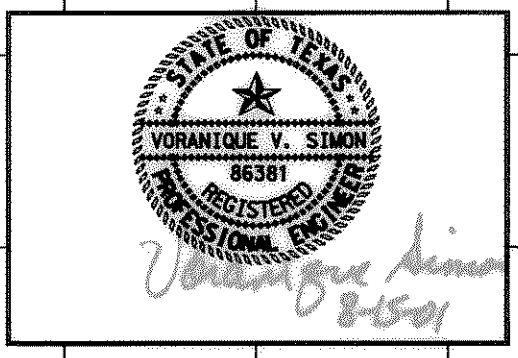

NO.	DATE	REVISION	APPROV.
1	8/15	LATERAL PROFILE B-1, B-2, B-3 ADJUSTED	
2	1/5/21	LATERAL PROFILE B-1 & B-2 ADJUSTED	

CITY OF ROCKWALL
 "THE NEW HORIZON"
 TOWNSEND DRIVE
 LATERAL PROFILES

TurnerCollie & Braden Inc.
 ENGINEERS • PLANNERS • PROJECT MANAGERS

Sheet	A123	Scale	VERT. 1"=10'	Date	DECEMBER, 2000
Designed	YVS	Checked	TBS	Job No.	15-00925-200
Drawn	GBA	Approved	RCR	Sheet	26 of 72