


RECORD DRAWINGS

These record drawings have been prepared by the Engineer and/or Designer and are not to be construed as a guarantee of the accuracy of the information provided. The Engineer and/or Designer does not guarantee that these plans accurately represent every detail of the constructed project.

*Signature* Date

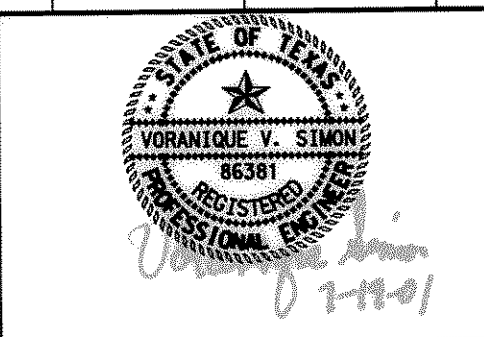

**CITY OF ROCKWALL**  
"THE NEW HORIZON"

TOWNSEND DRIVE

LATERAL PROFILES

Turner Collie & Braden Inc.  
ENGINEERS • PLANNERS • PROJECT MANAGERS

Unit	A123	Scale	1" = 10'	Date	DECEMBER, 2000
Designed	VYS	Checked	TBS	Job No.	15-00825-200
Drawn	GBA	Approved	RCR	Sheet	27 of 72