


**UNDERGROUND UTILITIES**




THE LOCATION OF EXISTING UTILITIES SHOWN ON THESE PLANS ARE APPROXIMATE AND BASED ON DATA FURNISHED BY UTILITY COMPANIES. IT IS THE RESPONSIBILITY OF THE CONTRACTOR TO LOCATE AND VERIFY ON-SITE THE UTILITIES THAT MAY CONFLICT WITH THE CONSTRUCTION.

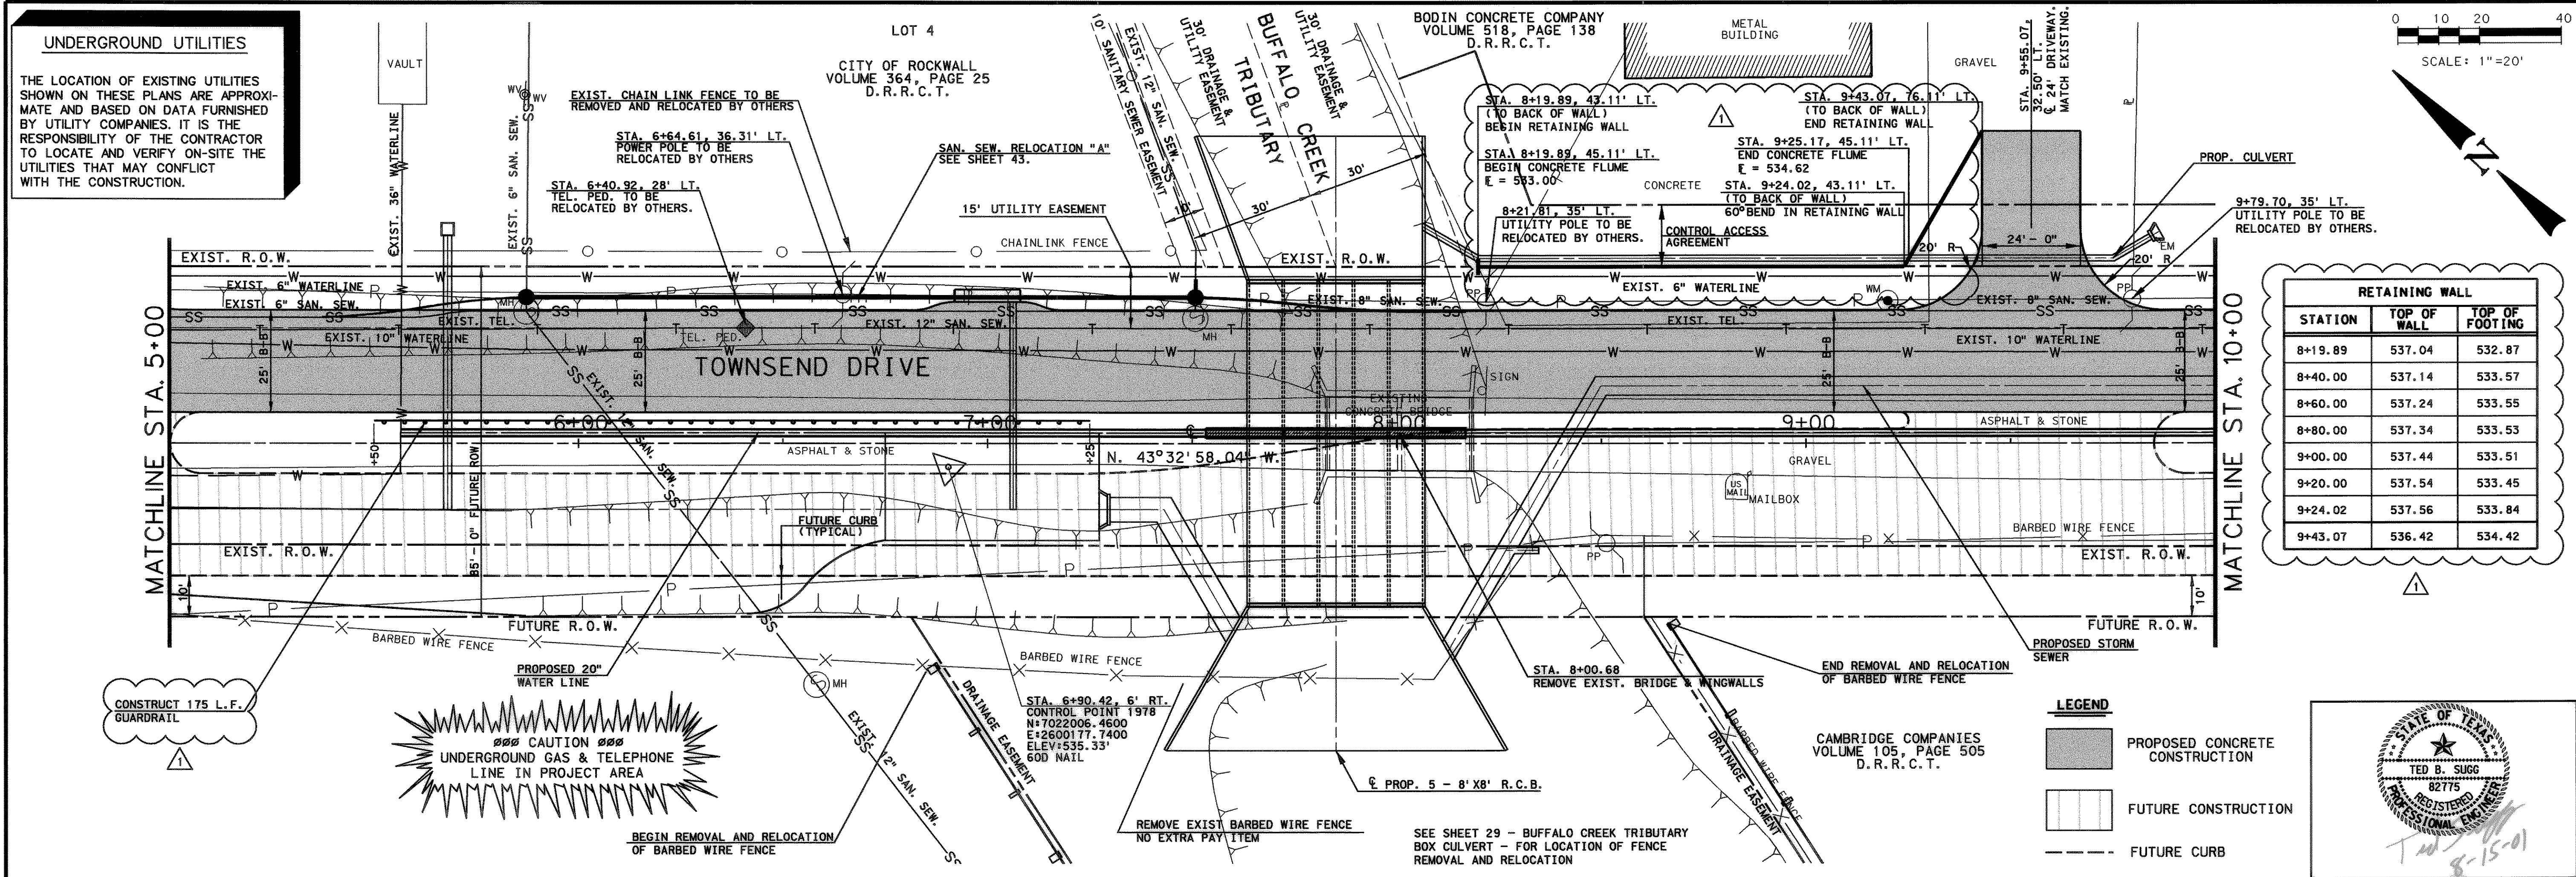

RETAINING WALL		
STATION	TOP OF WALL	TOP OF FOOTING
8+19.89	537.04	532.87
8+40.00	537.14	533.57
8+60.00	537.24	533.55
8+80.00	537.34	533.53
9+00.00	537.44	533.51
9+20.00	537.54	533.45
9+24.02	537.56	533.84
9+43.07	536.42	534.42

**LEGEND**

- PROPOSED CONCRETE CONSTRUCTION
- FUTURE CONSTRUCTION
- FUTURE CURB

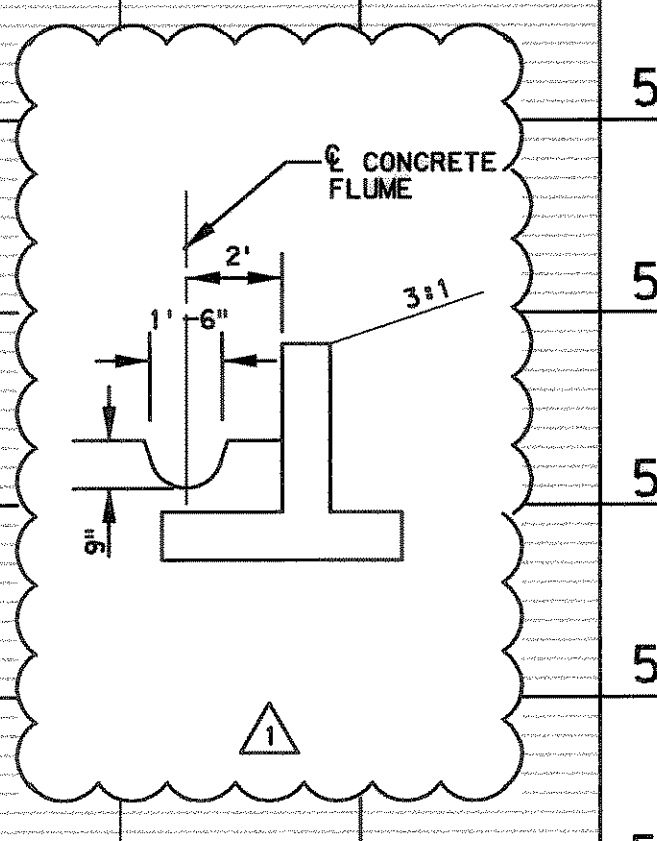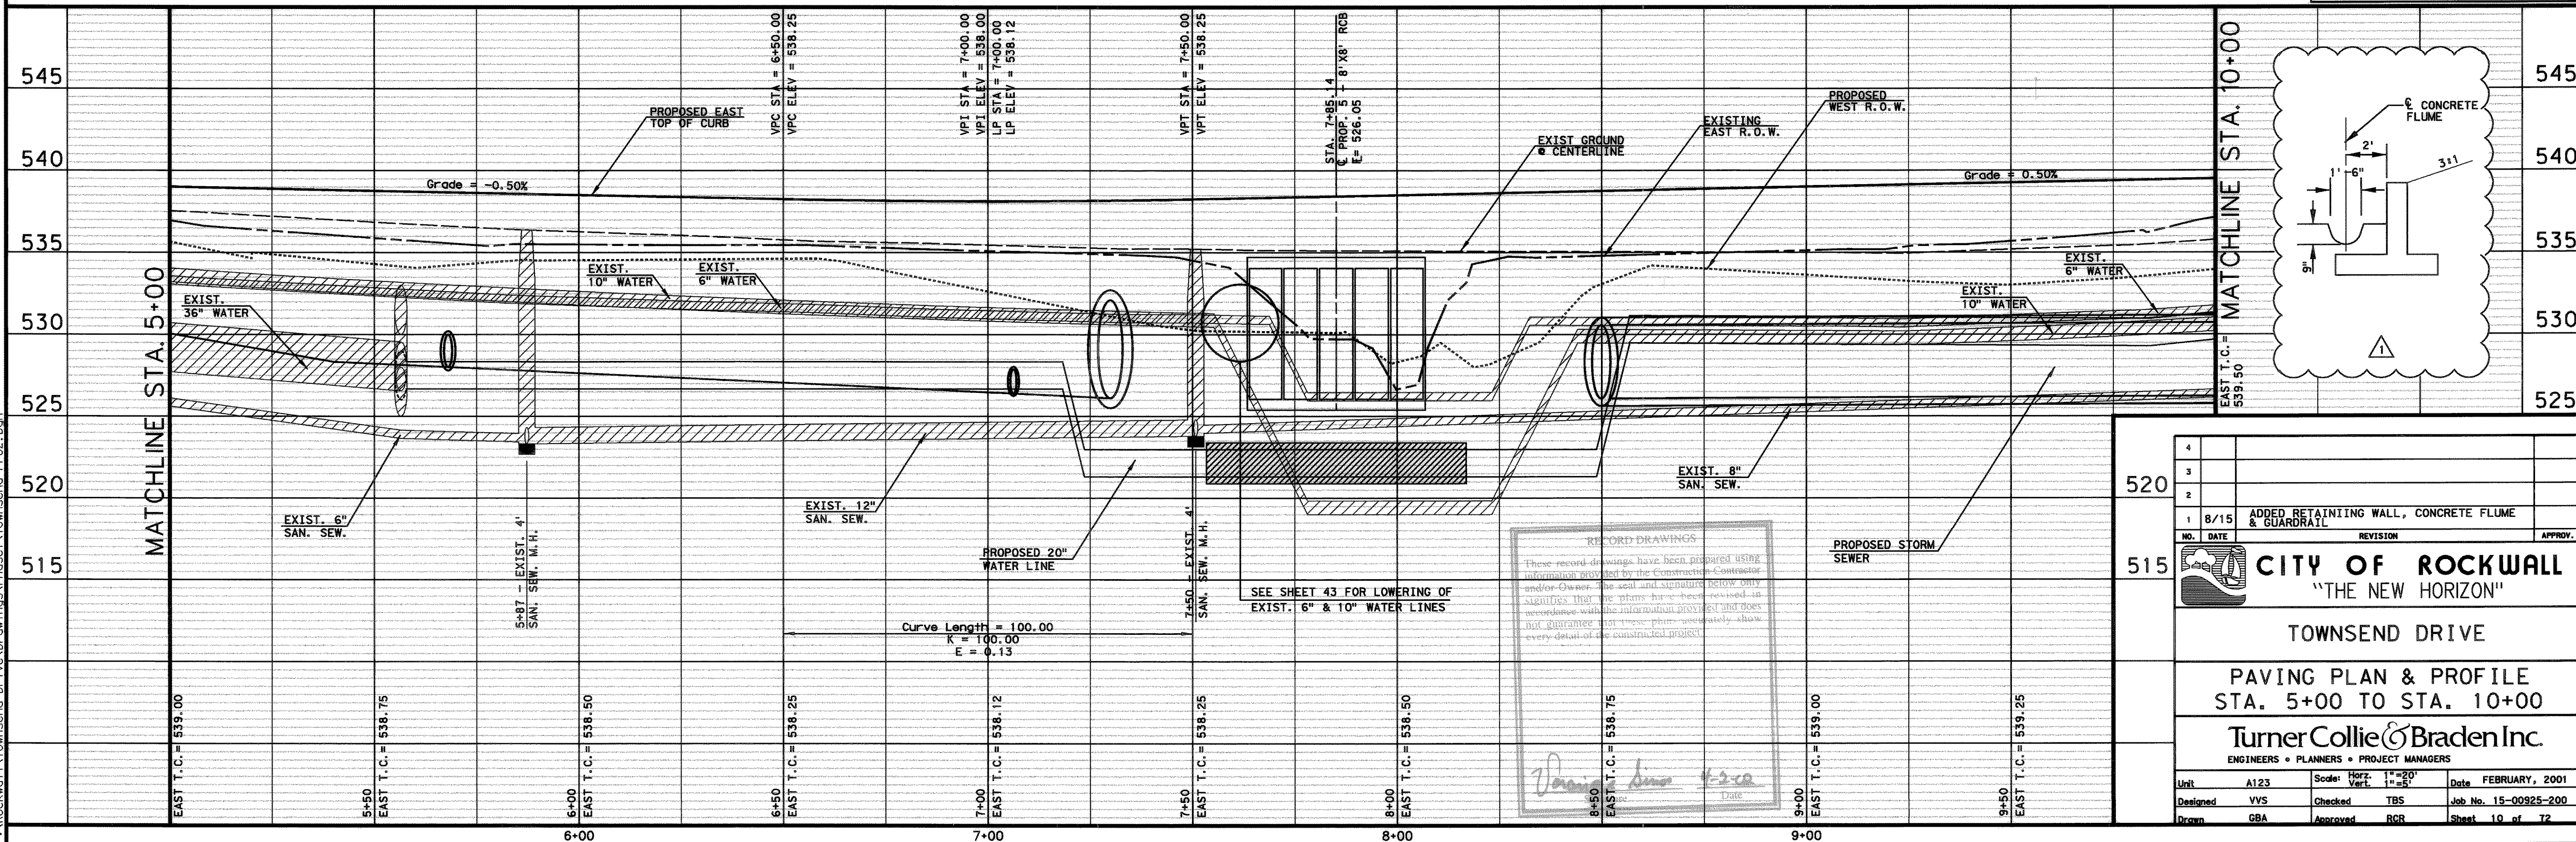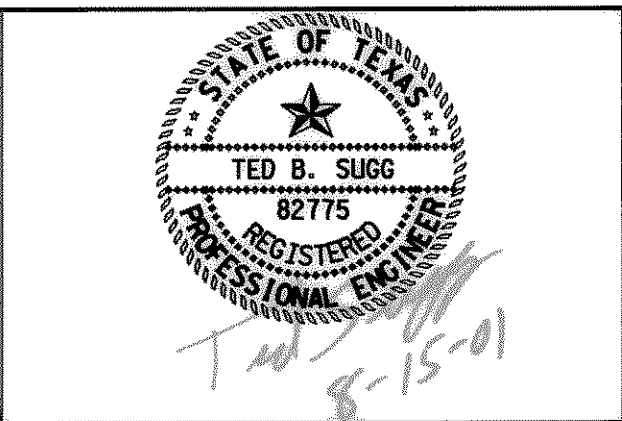

4			
3			
2			
1	8/15	ADDED RETAINING WALL, CONCRETE FLUME & GUARDRAIL	APPROV.
<b>CITY OF ROCKWALL</b> "THE NEW HORIZON"			
<b>TOWNSEND DRIVE</b>			
<b>PAVING PLAN &amp; PROFILE</b> STA. 5+00 TO STA. 10+00			
<b>TurnerCollie &amp; Braden Inc.</b> ENGINEERS • PLANNERS • PROJECT MANAGERS			
Unit	A123	Scale: Horiz. 1"=50'	Date: FEBRUARY, 2001
Designed	VVS	Checked	TBS
Drawn	GBA	Approved	RCR
		Job No. 15-00925-200	Sheet 10 of 12

P:\Rockwall\Townsend Dr\1ve\Drawings\Phase1\Townsend\_PP02.dwg