
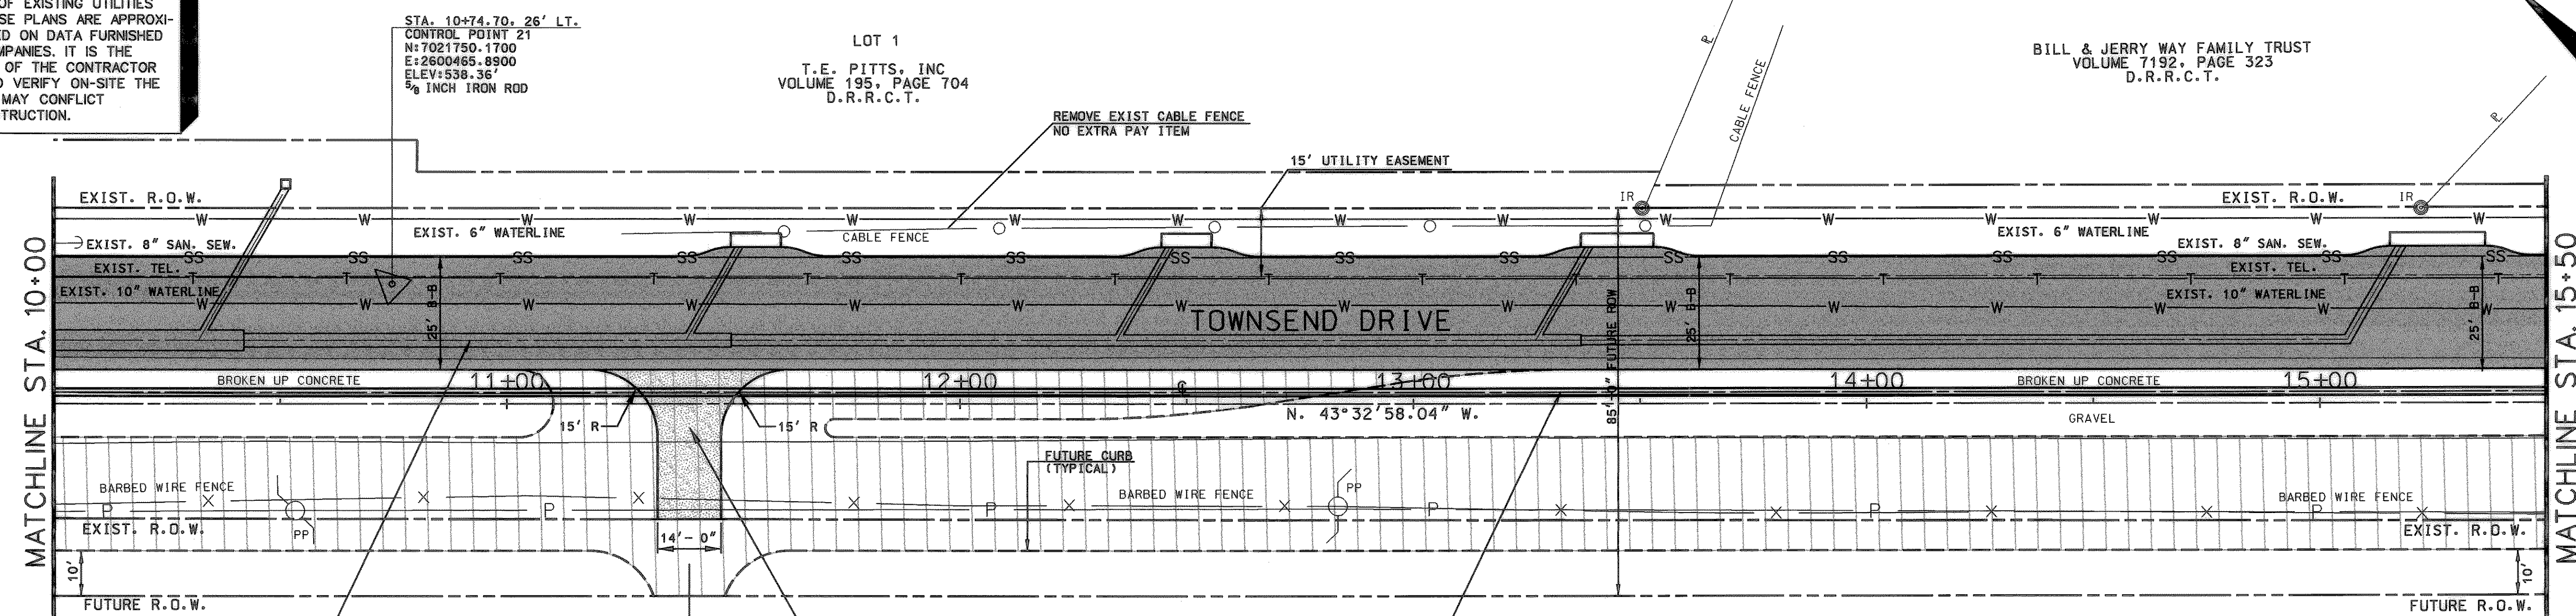
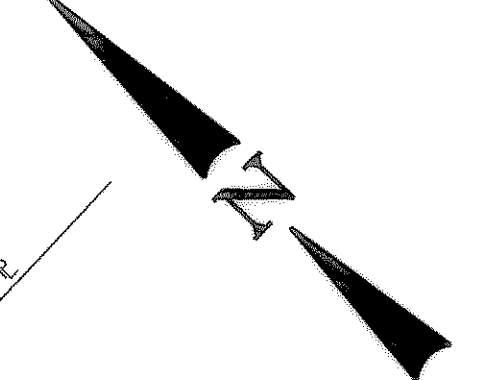


UNDERGROUND UTILITIES

THE LOCATION OF EXISTING UTILITIES SHOWN ON THESE PLANS ARE APPROXIMATE AND BASED ON DATA FURNISHED BY UTILITY COMPANIES. IT IS THE RESPONSIBILITY OF THE CONTRACTOR TO LOCATE AND VERIFY ON-SITE THE UTILITIES THAT MAY CONFLICT WITH THE CONSTRUCTION.

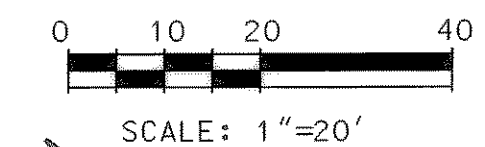


MATCHLINE STA. 10+00

MATCHLINE STA. 15+50


LEGEND

- PROPOSED CONCRETE CONSTRUCTION
- FUTURE CONSTRUCTION
- PROPOSED ASPHALT CONSTRUCTION
- FUTURE CURB

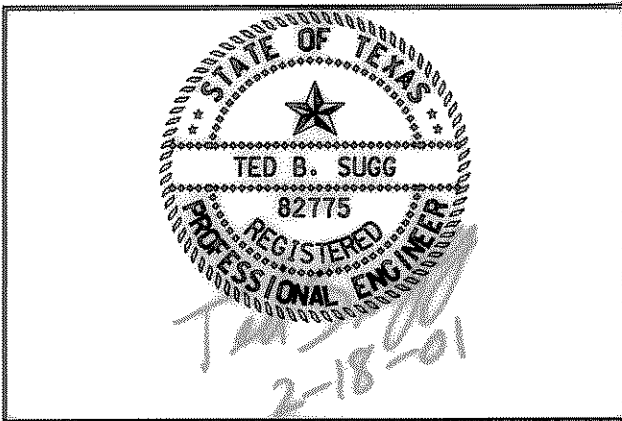

!!! CAUTION !!!
UNDERGROUND GAS & TELEPHONE
LINE IN PROJECT AREA

CAMBRIDGE COMPANIES
VOLUME 105, PAGE 505
D.R.R.C.T.

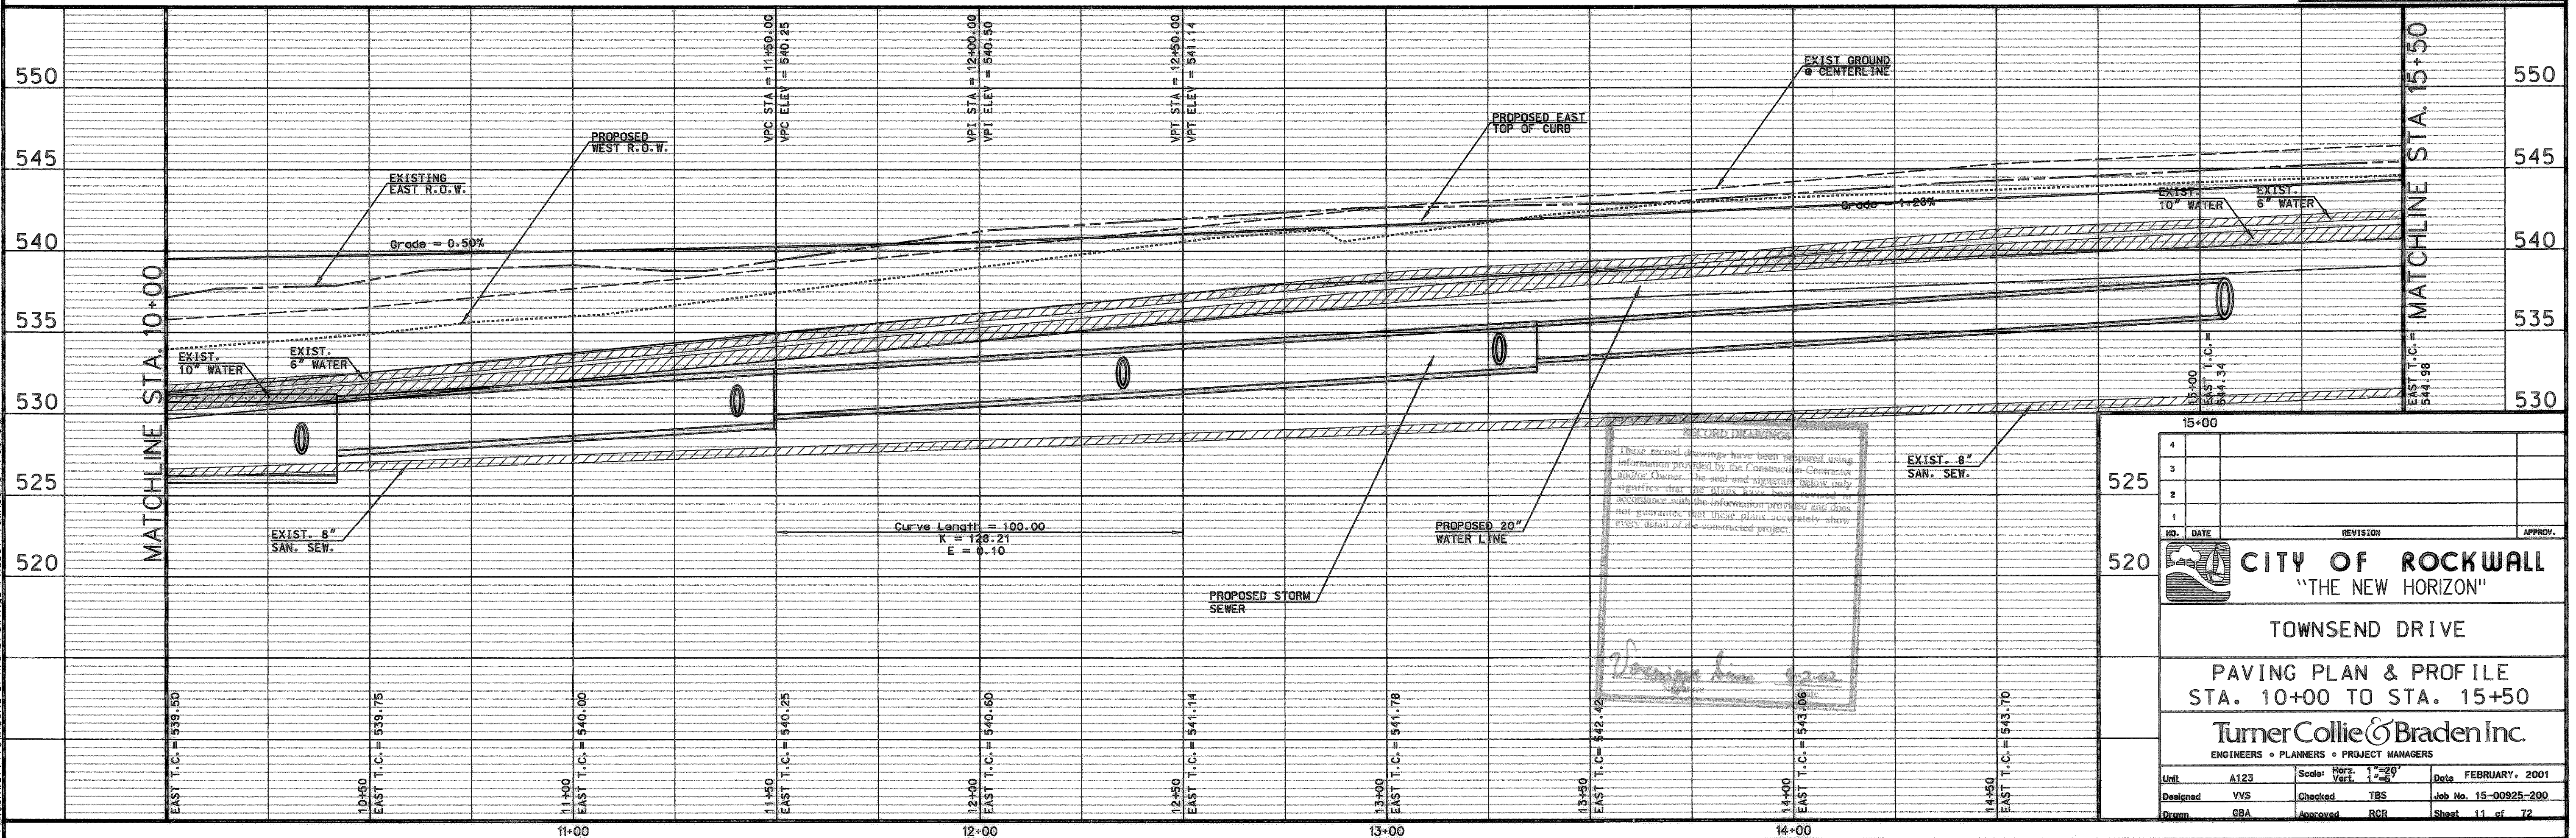

P:\Rockwall\Townsend Drive\Drawings\Phase1\Townsend_PP03.dwg

MATCHLINE STA. 10+00

MATCHLINE STA. 15+50

RECORD DRAWINGS
These record drawings have been prepared using information provided by the Construction Contractor. The user and signatory below only warrant that the information provided and does not guarantee that these plans accurately show every detail of the constructed project.

Donna Line 522

NO.	DATE	REVISION	APPROV.
<p>CITY OF ROCKWALL "THE NEW HORIZON"</p>			
<p>TOWNSEND DRIVE</p> <p>PAVING PLAN & PROFILE STA. 10+00 TO STA. 15+50</p> <p>TurnerCollie & Braden Inc. ENGINEERS • PLANNERS • PROJECT MANAGERS</p>			
Unit	A123	Scale: Horiz. 1"=20' Vert. 1"=5'	Date FEBRUARY, 2001
Designed	VVS	Checked TBS	Job No. 15-00925-200
Drawn	GBA	Approved RCR	Sheet 11 of 72